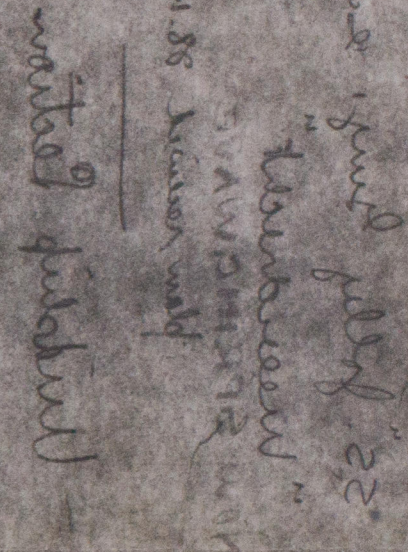


$$\frac{1}{20} = 1 \text{ ft}$$


Spannen in Messchne und Kesselschraube
im Boden wendung 75.75.7
oben Bes zu Kopfdeck 140.75.9

0,75 L.B.H + $\frac{1}{2}$ INHALT AUFBAU = 1075 + 200 = 1275


Del. Sept 10 Oktober 1917
Fischer

© 1300

Lloyd's Register
Foundation

W1032-0262

W1032-0262

MIDSHIP SECTION

"GRANNY SUZANNE" ★

To accompany Barry
Report No. 28/43

RECORDS DEPT.
LONDON

2

RECEIVED



© 2020

Lloyd's Register
Foundation