



© 2021

Lloyd's Register
Foundation


SS "KALMARSUND IX"

BOMBAY

rept No. 8629.

PROPOSED CROP.

STEREFRAME

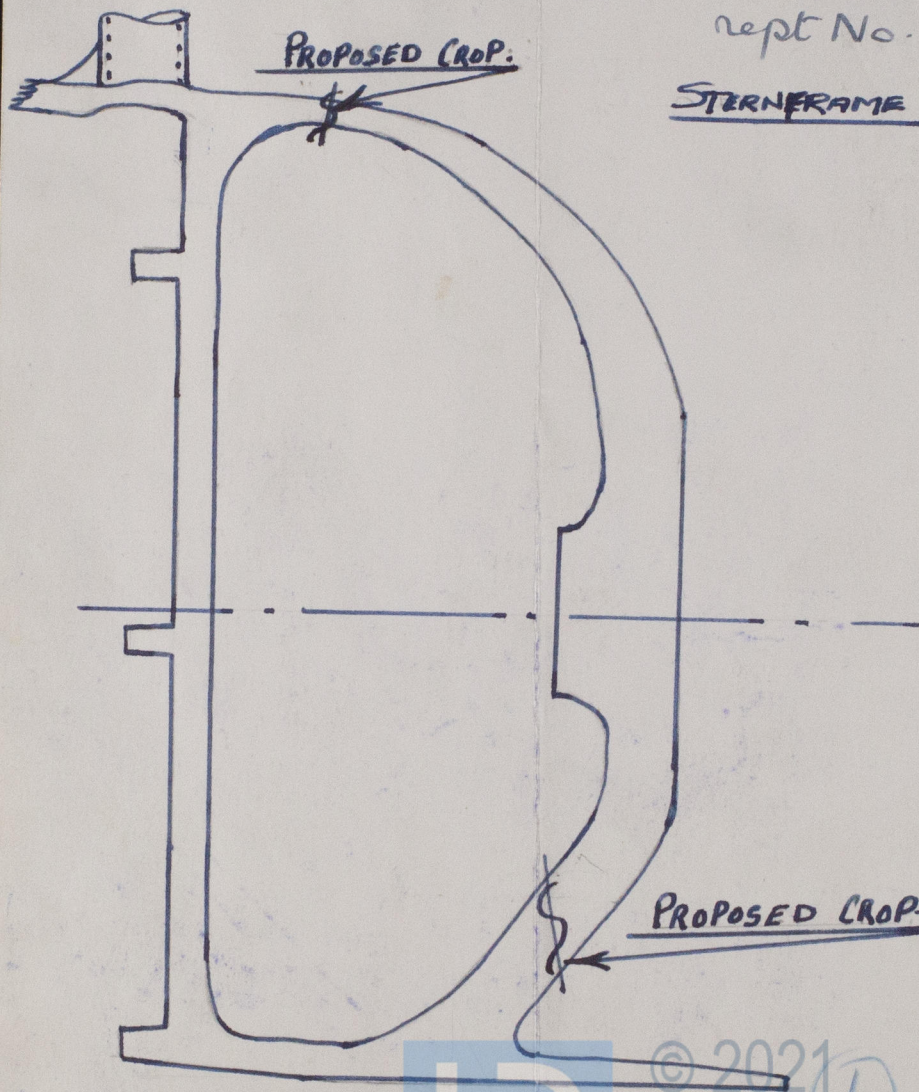

PROPOSED CROP.



© 2021

①

Photo by
Hamilton Studios Ltd.
Bombay.
Foundation

W1034 - 0044