


22/8/29

Support of Windless, Winches, Masts etc,
to Surveyor's Satisfaction

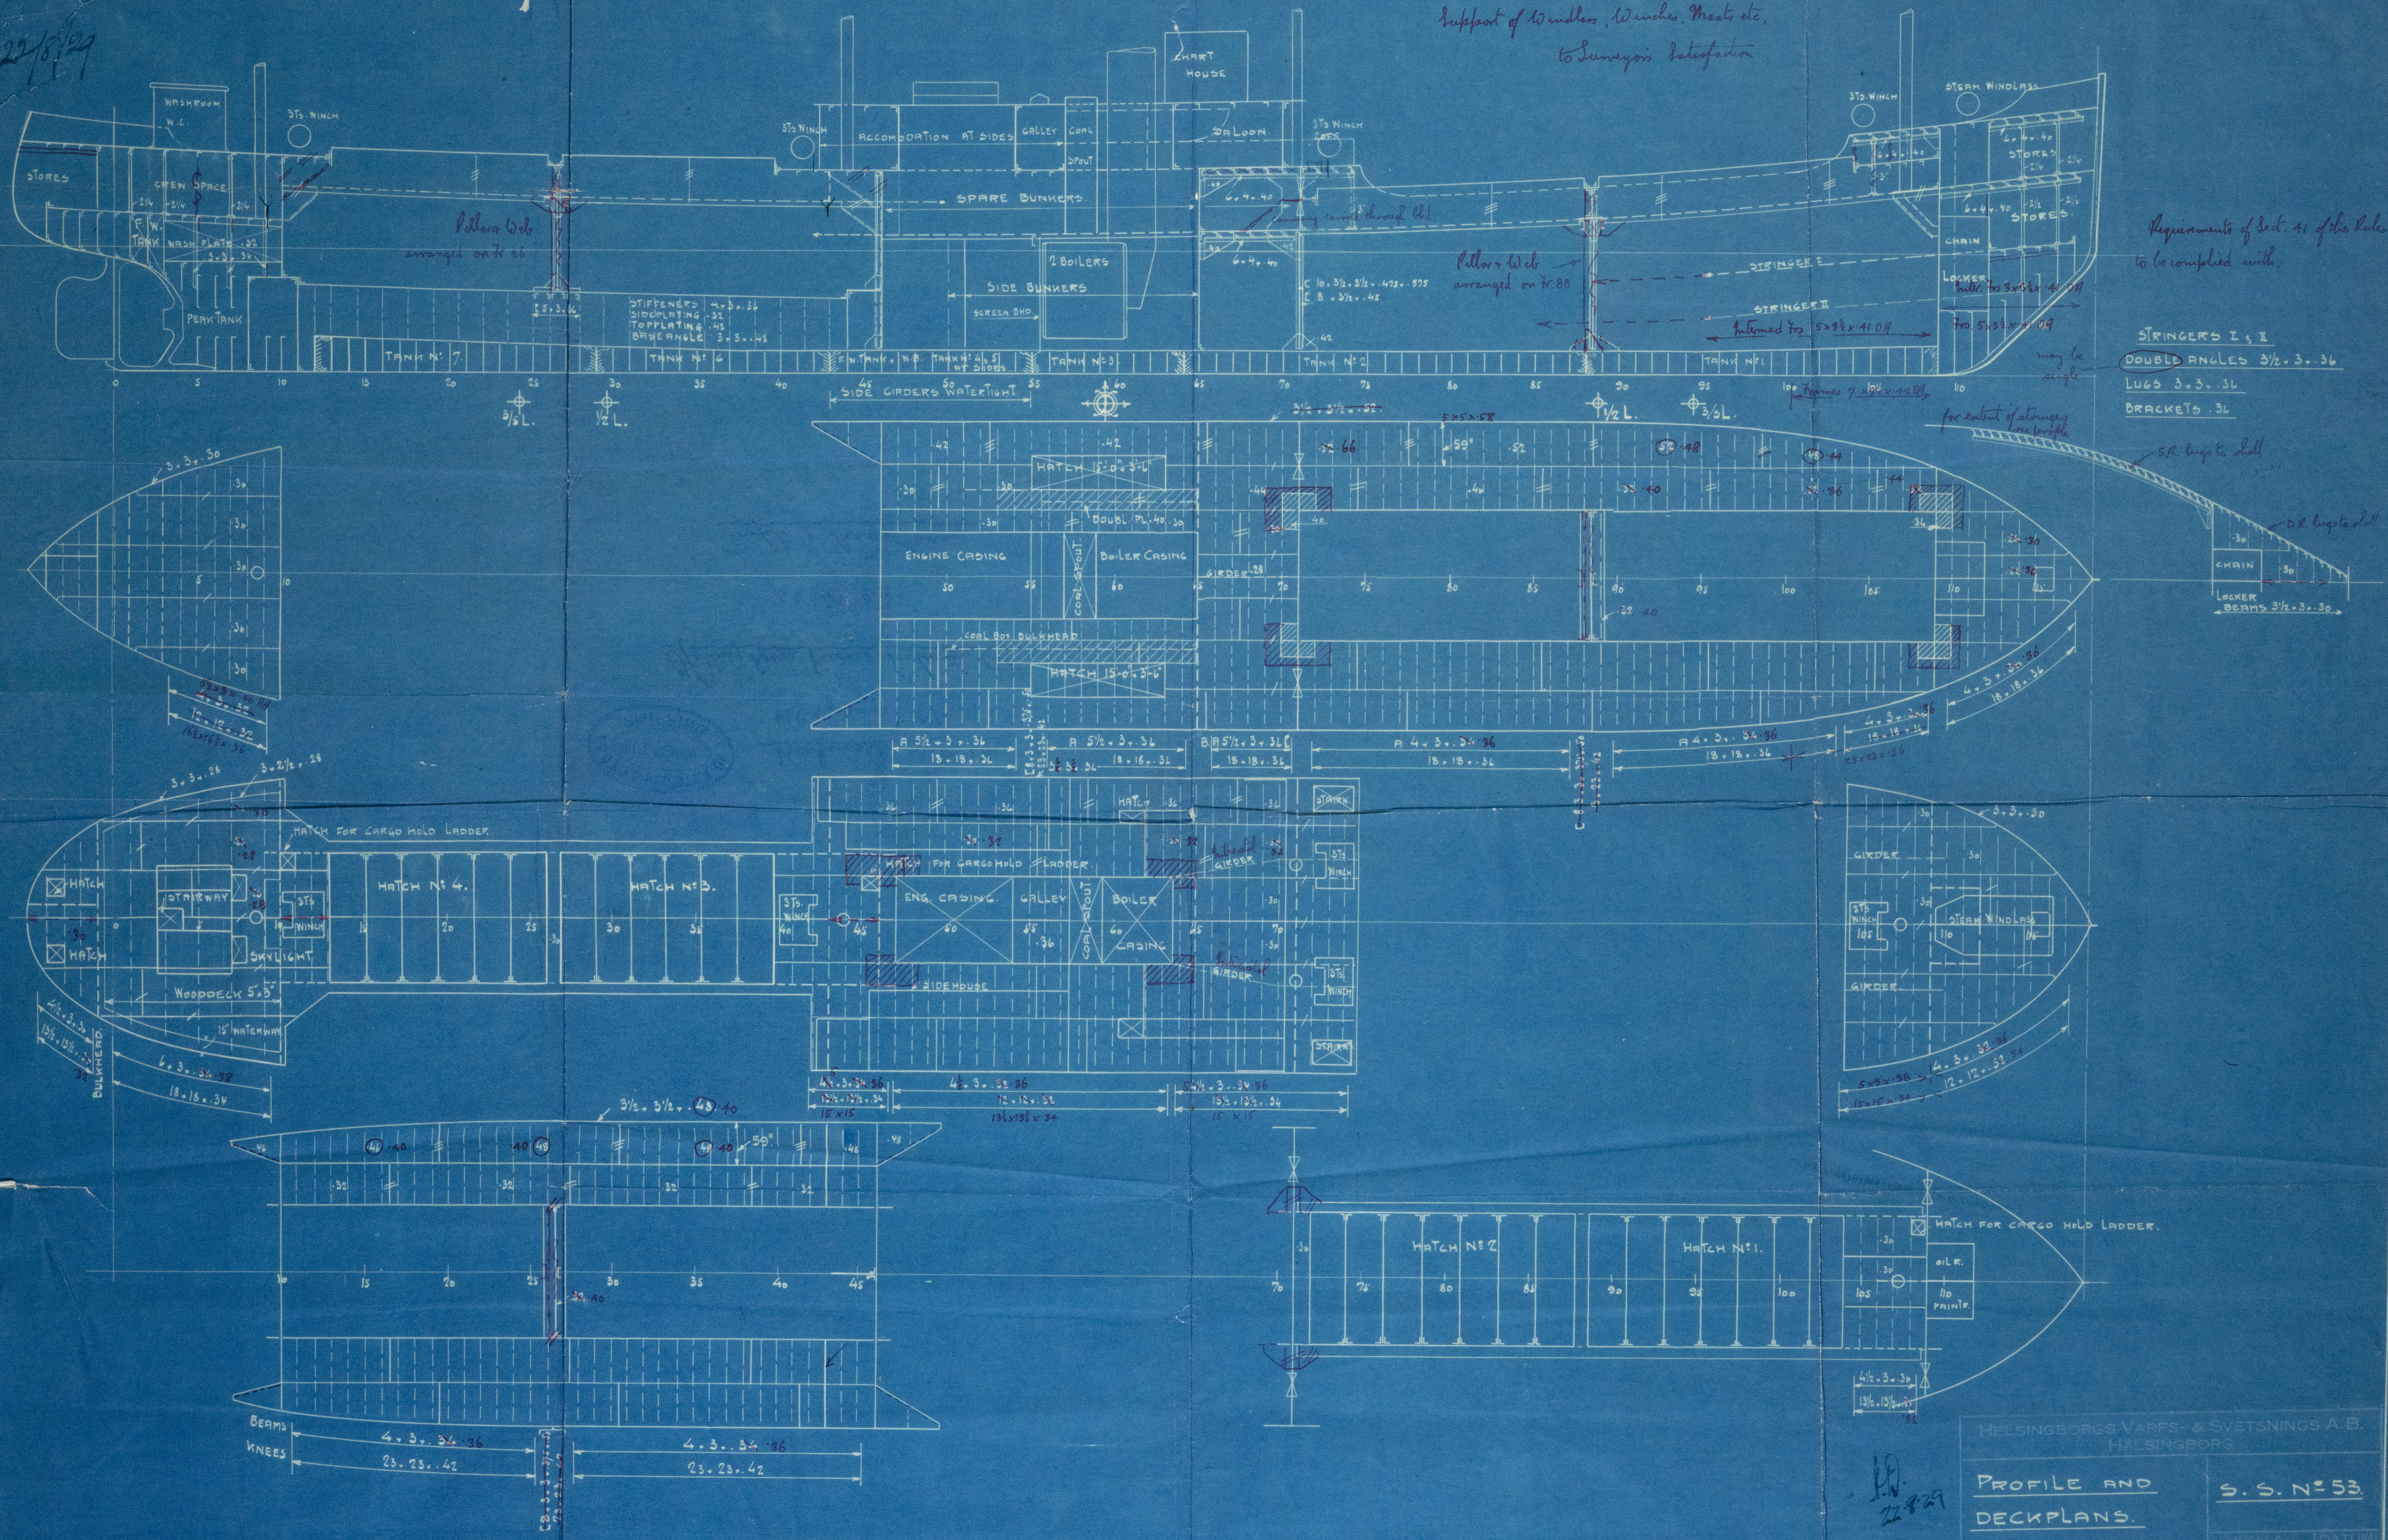

Requirements of Sect. 41 of this Rule
to be complied with.

STIFFENERS I & II
DOUBLE ANGLES 3 1/2 x 3 x 3/16
LUGS 3 x 3 x 3/16
BRACKETS .3L

SR Lugs to shell
DR Lugs to shell
CHAIN
LOCKER
BEAMS 3 1/2 x 3 x 3/16

for extent of stringing
see profile

for extent of stringing
see profile

HELSEBORGSKA VARF- & SVETSNINGS A.B.
HALSINGBORG

PROFILE AND
DECKPLANS.

S.S. N° 53

SCALE: 1:100

DATE: 5-8-29

W.B.

SHIP No. 53-3

SHIPPING



Kalmarsund IX.

Hbg rept No. 460.

Helsingborgs Varvs- & Sjöfart AB.

S.S. Nr 53.

Profile & Deckplans.



© 2021

Lloyd's Register
Foundation

W1034-0097

56.36
2.52
2
54.84



© 2021

Lloyd's Register
Foundation