



2.1.98

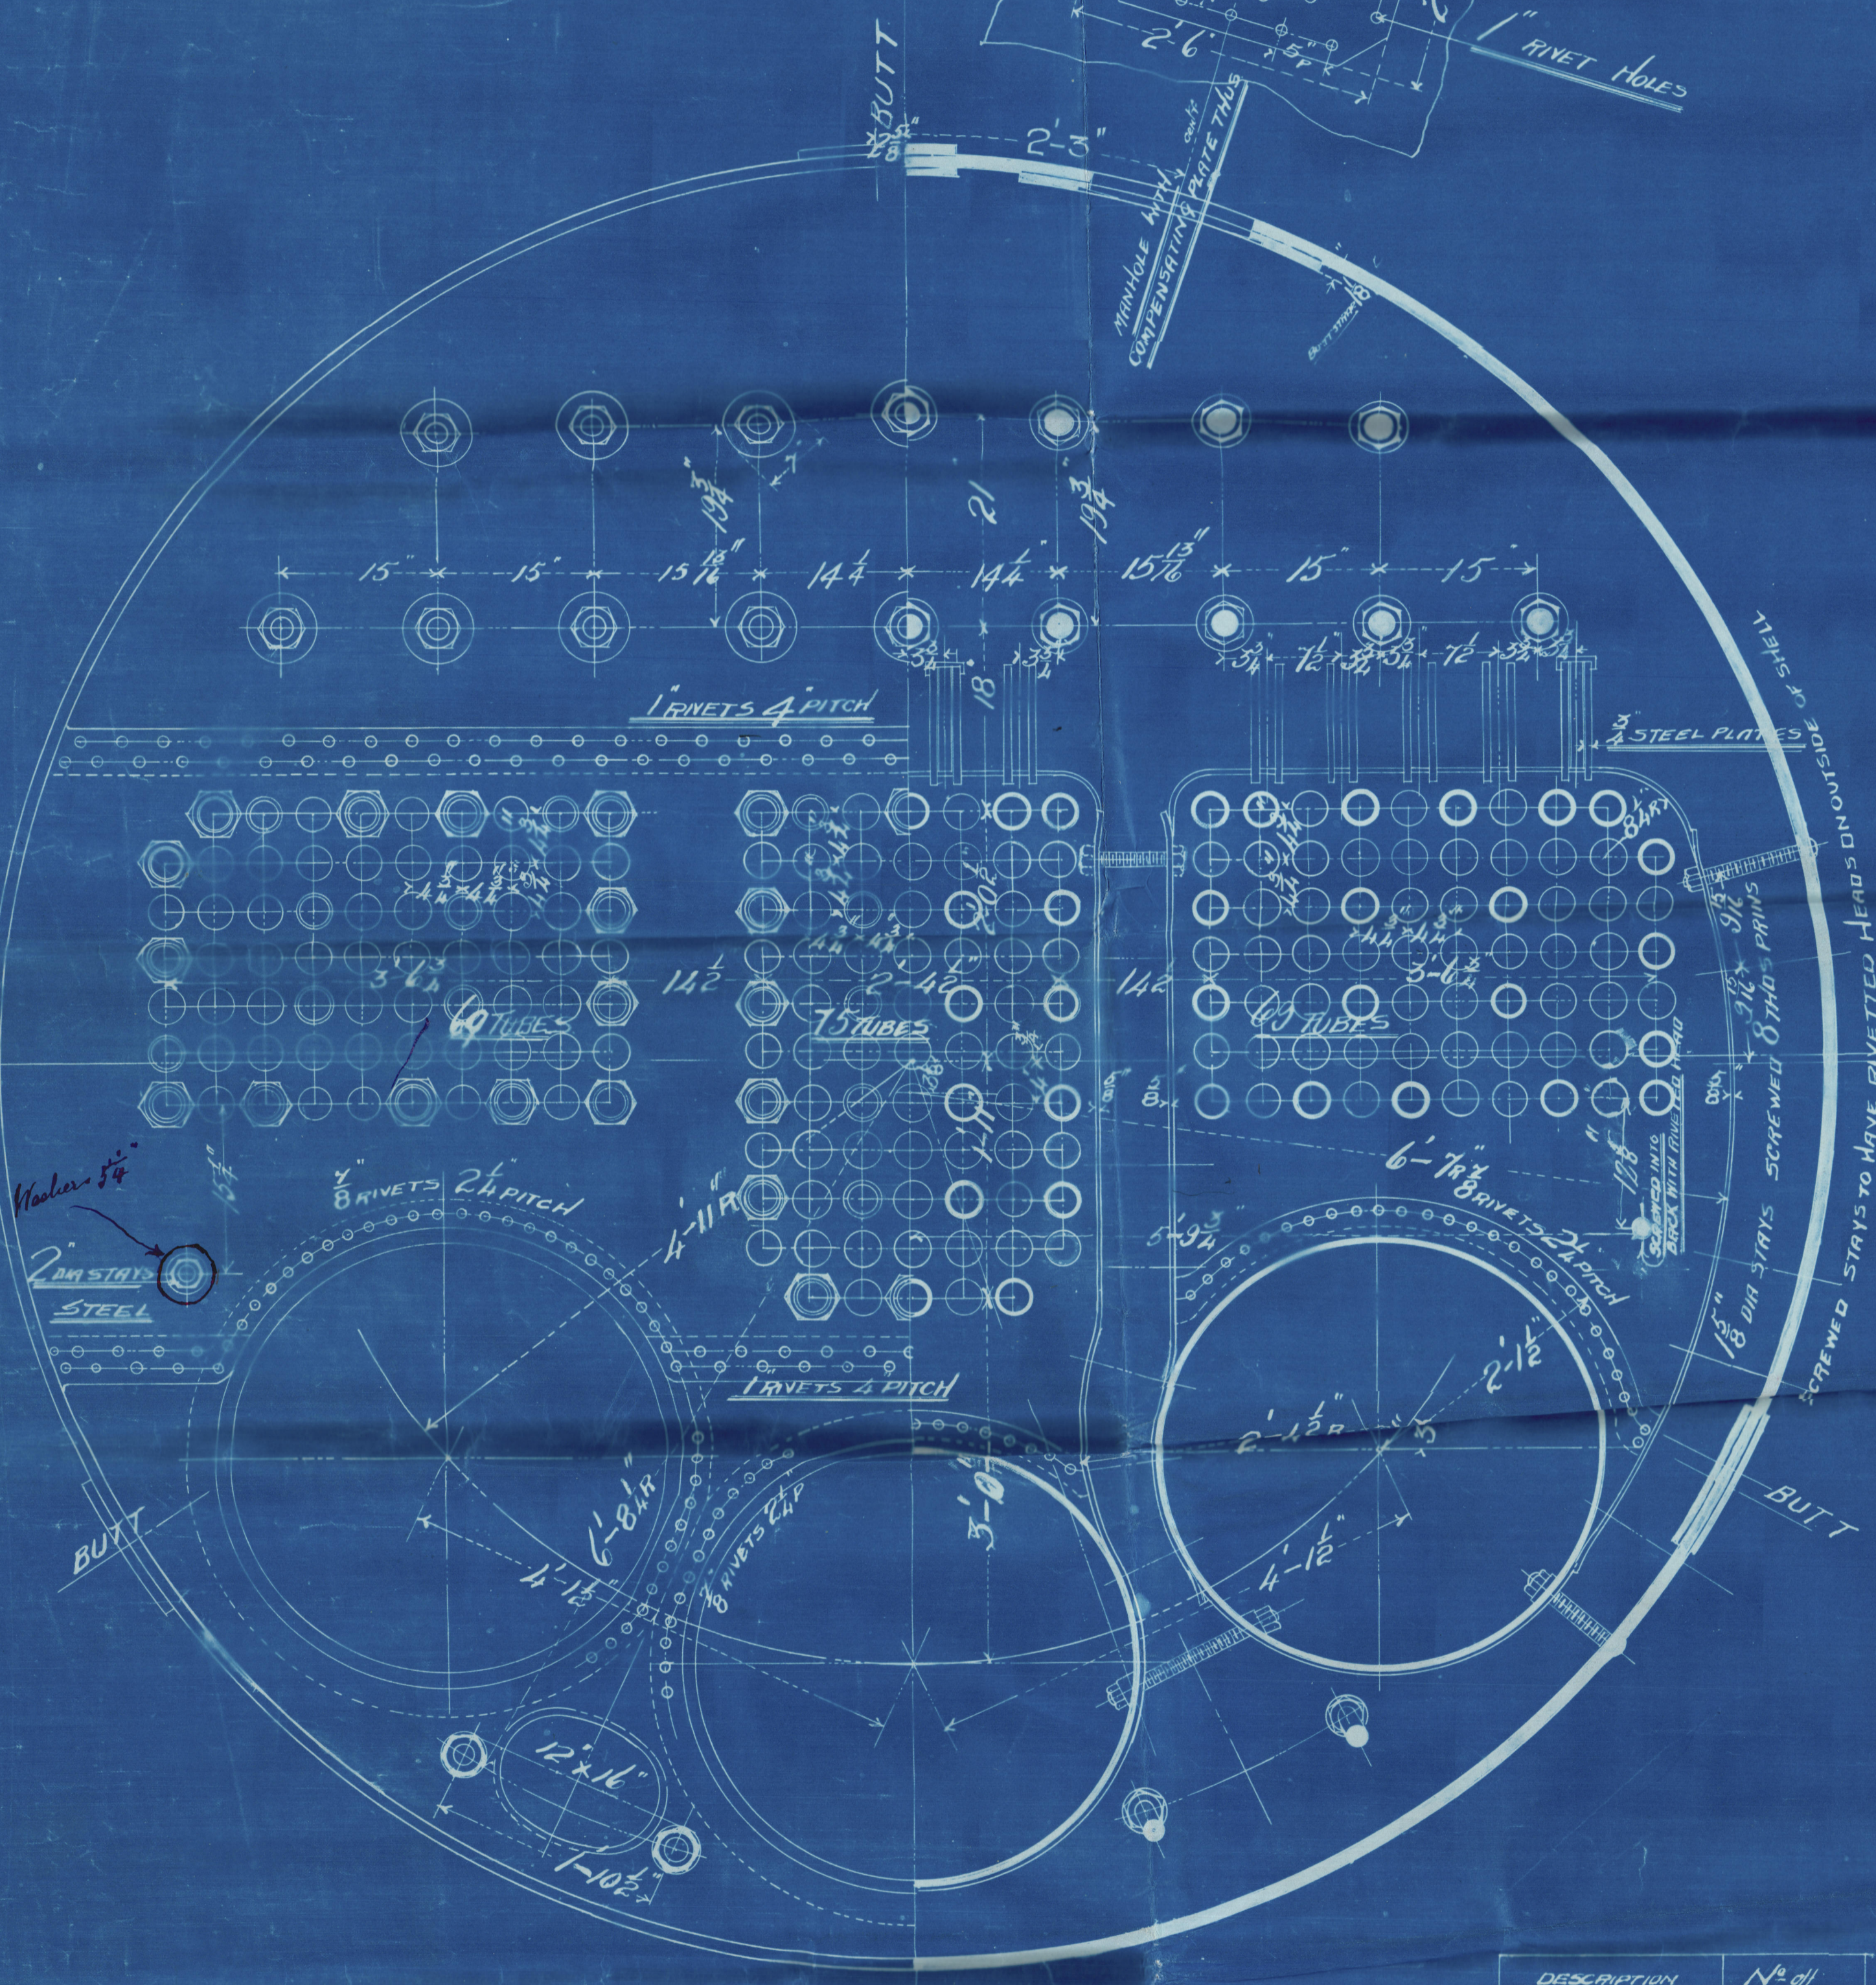



DESCRIPTION	No of
Stay tubes 3/8" thick	48
" " 1/2" "	16
Plain tubes 3/8" "	149

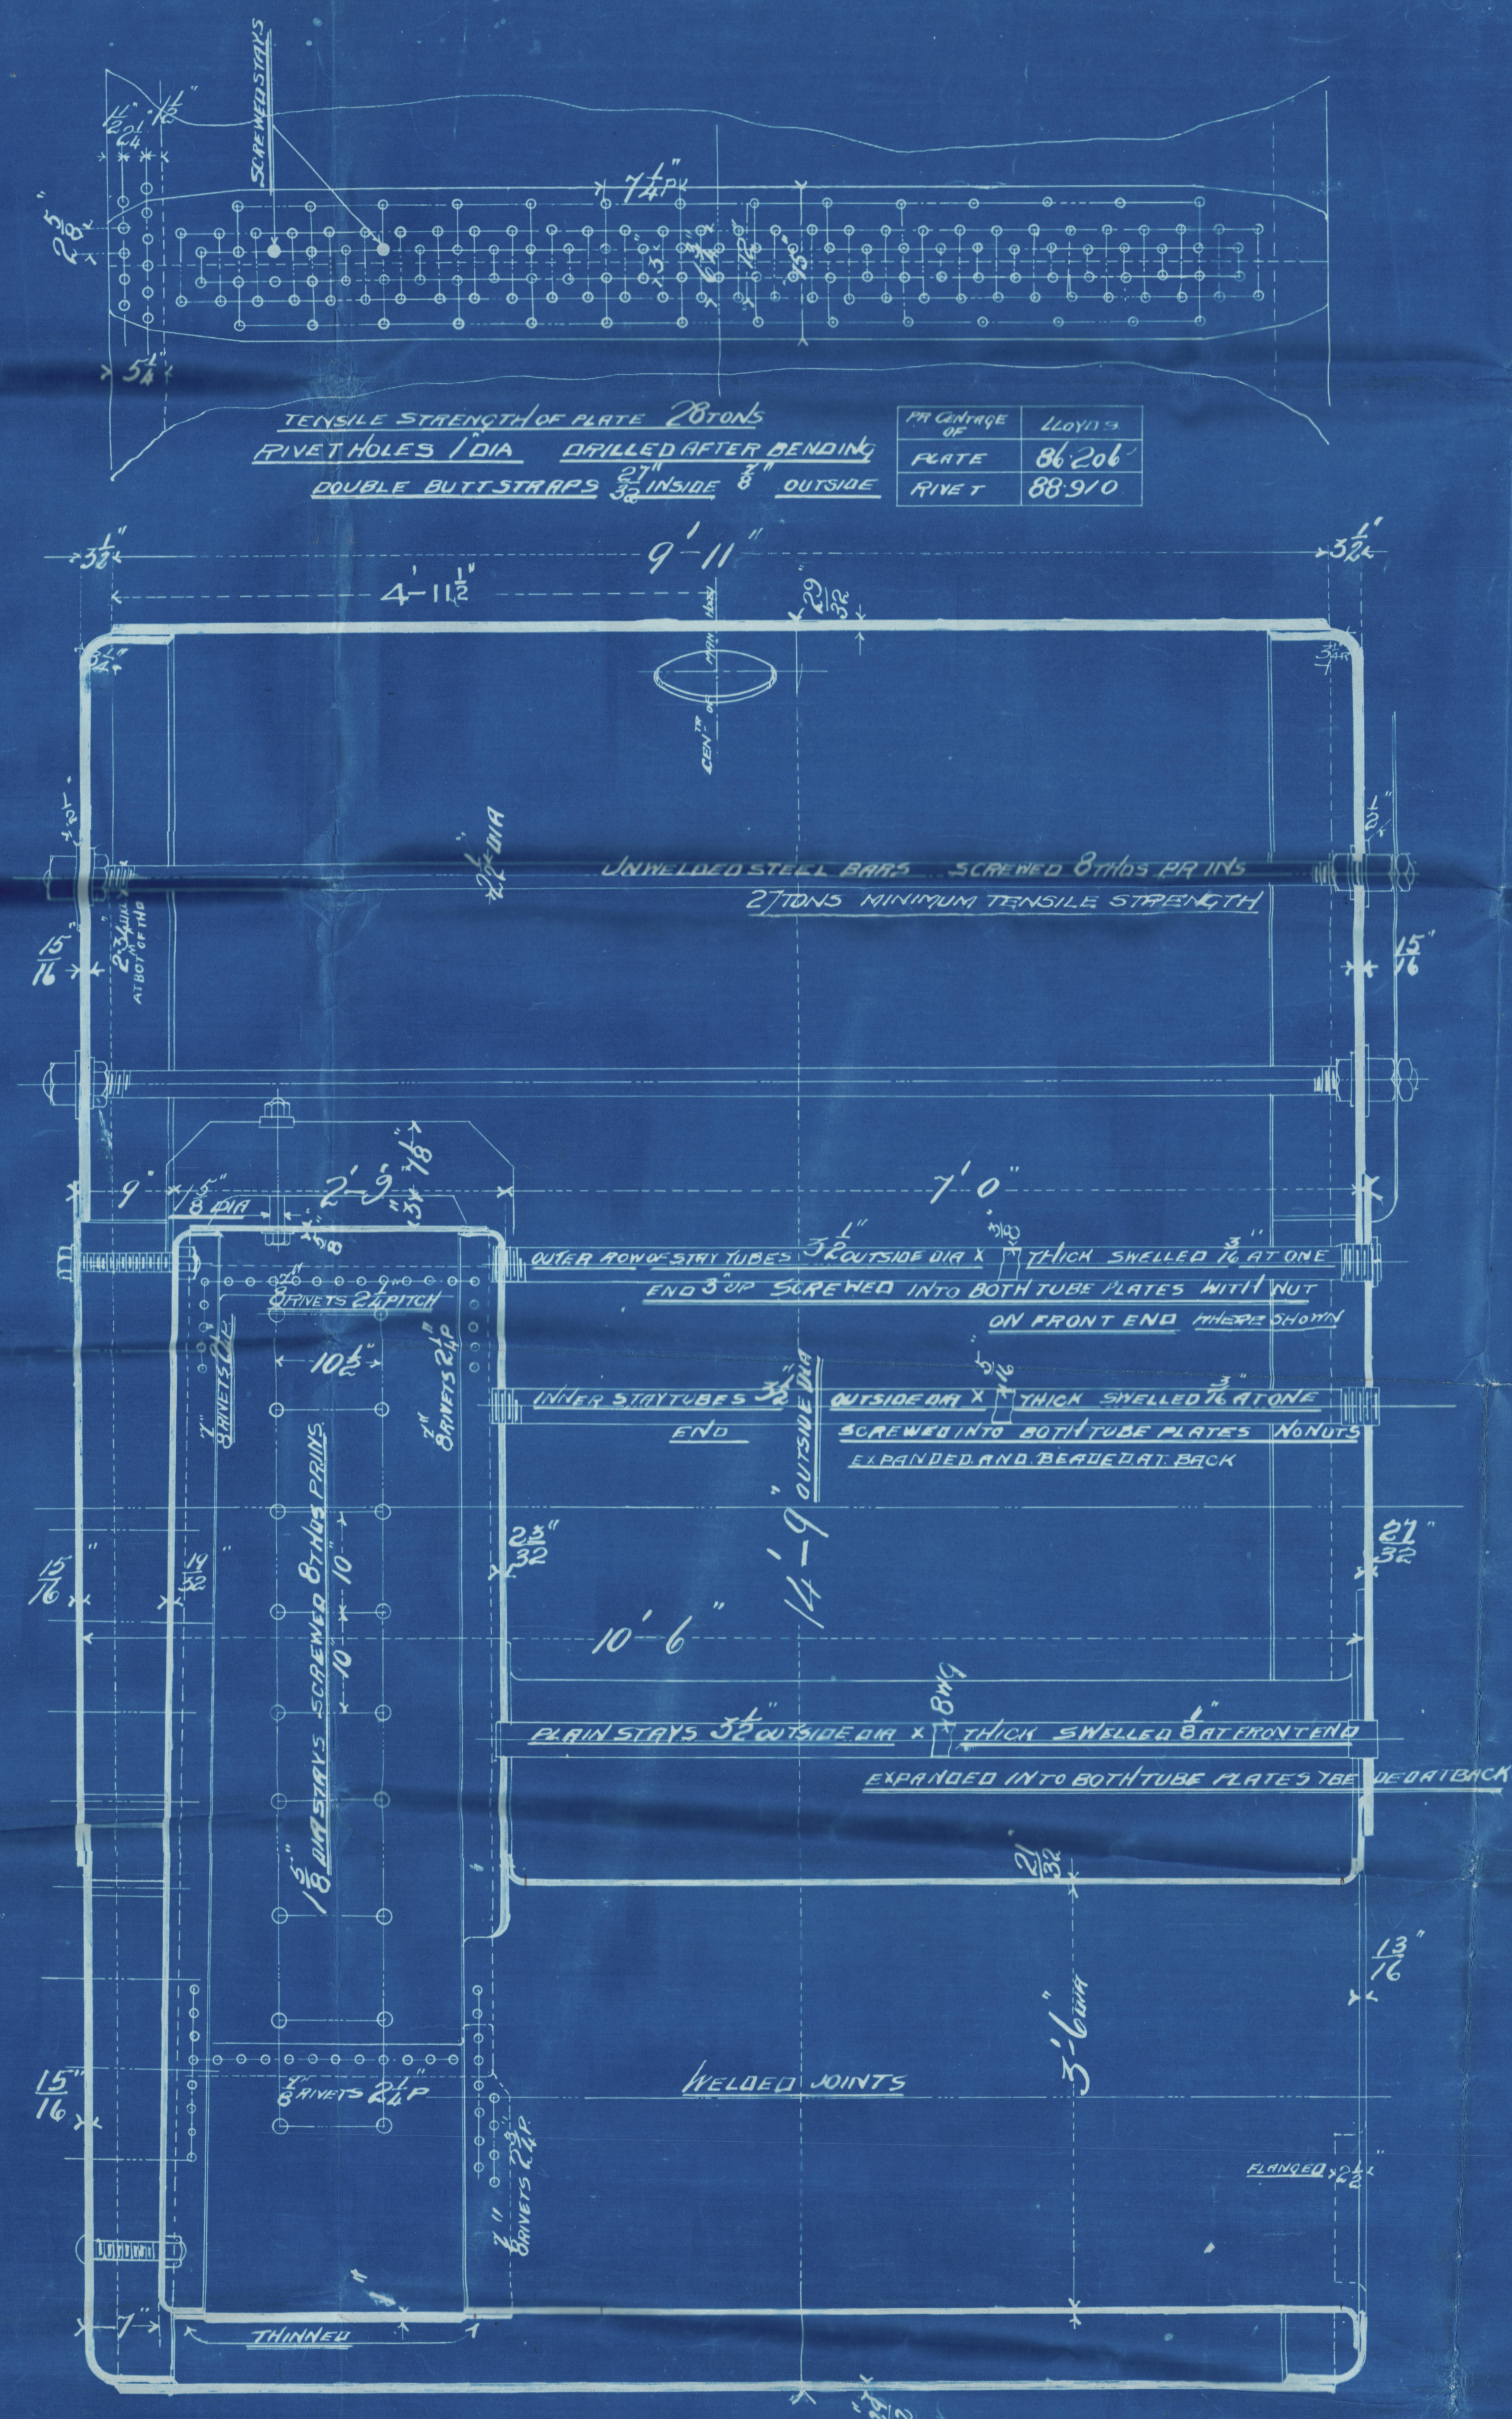

TO PASS LLOYDS

WORKING PRESS 130 LBS  
TEST " 260 "

N<sup>o</sup> 787 BOILER  
FOR  
MESSRS MCKIE & BAXTER  
14' 9" OUTSIDE DIA X 10' 6"  
N<sup>o</sup> 134  
Scaler pr ft.

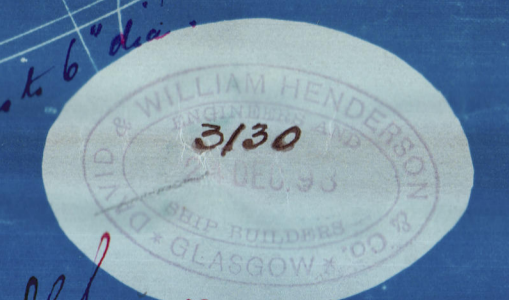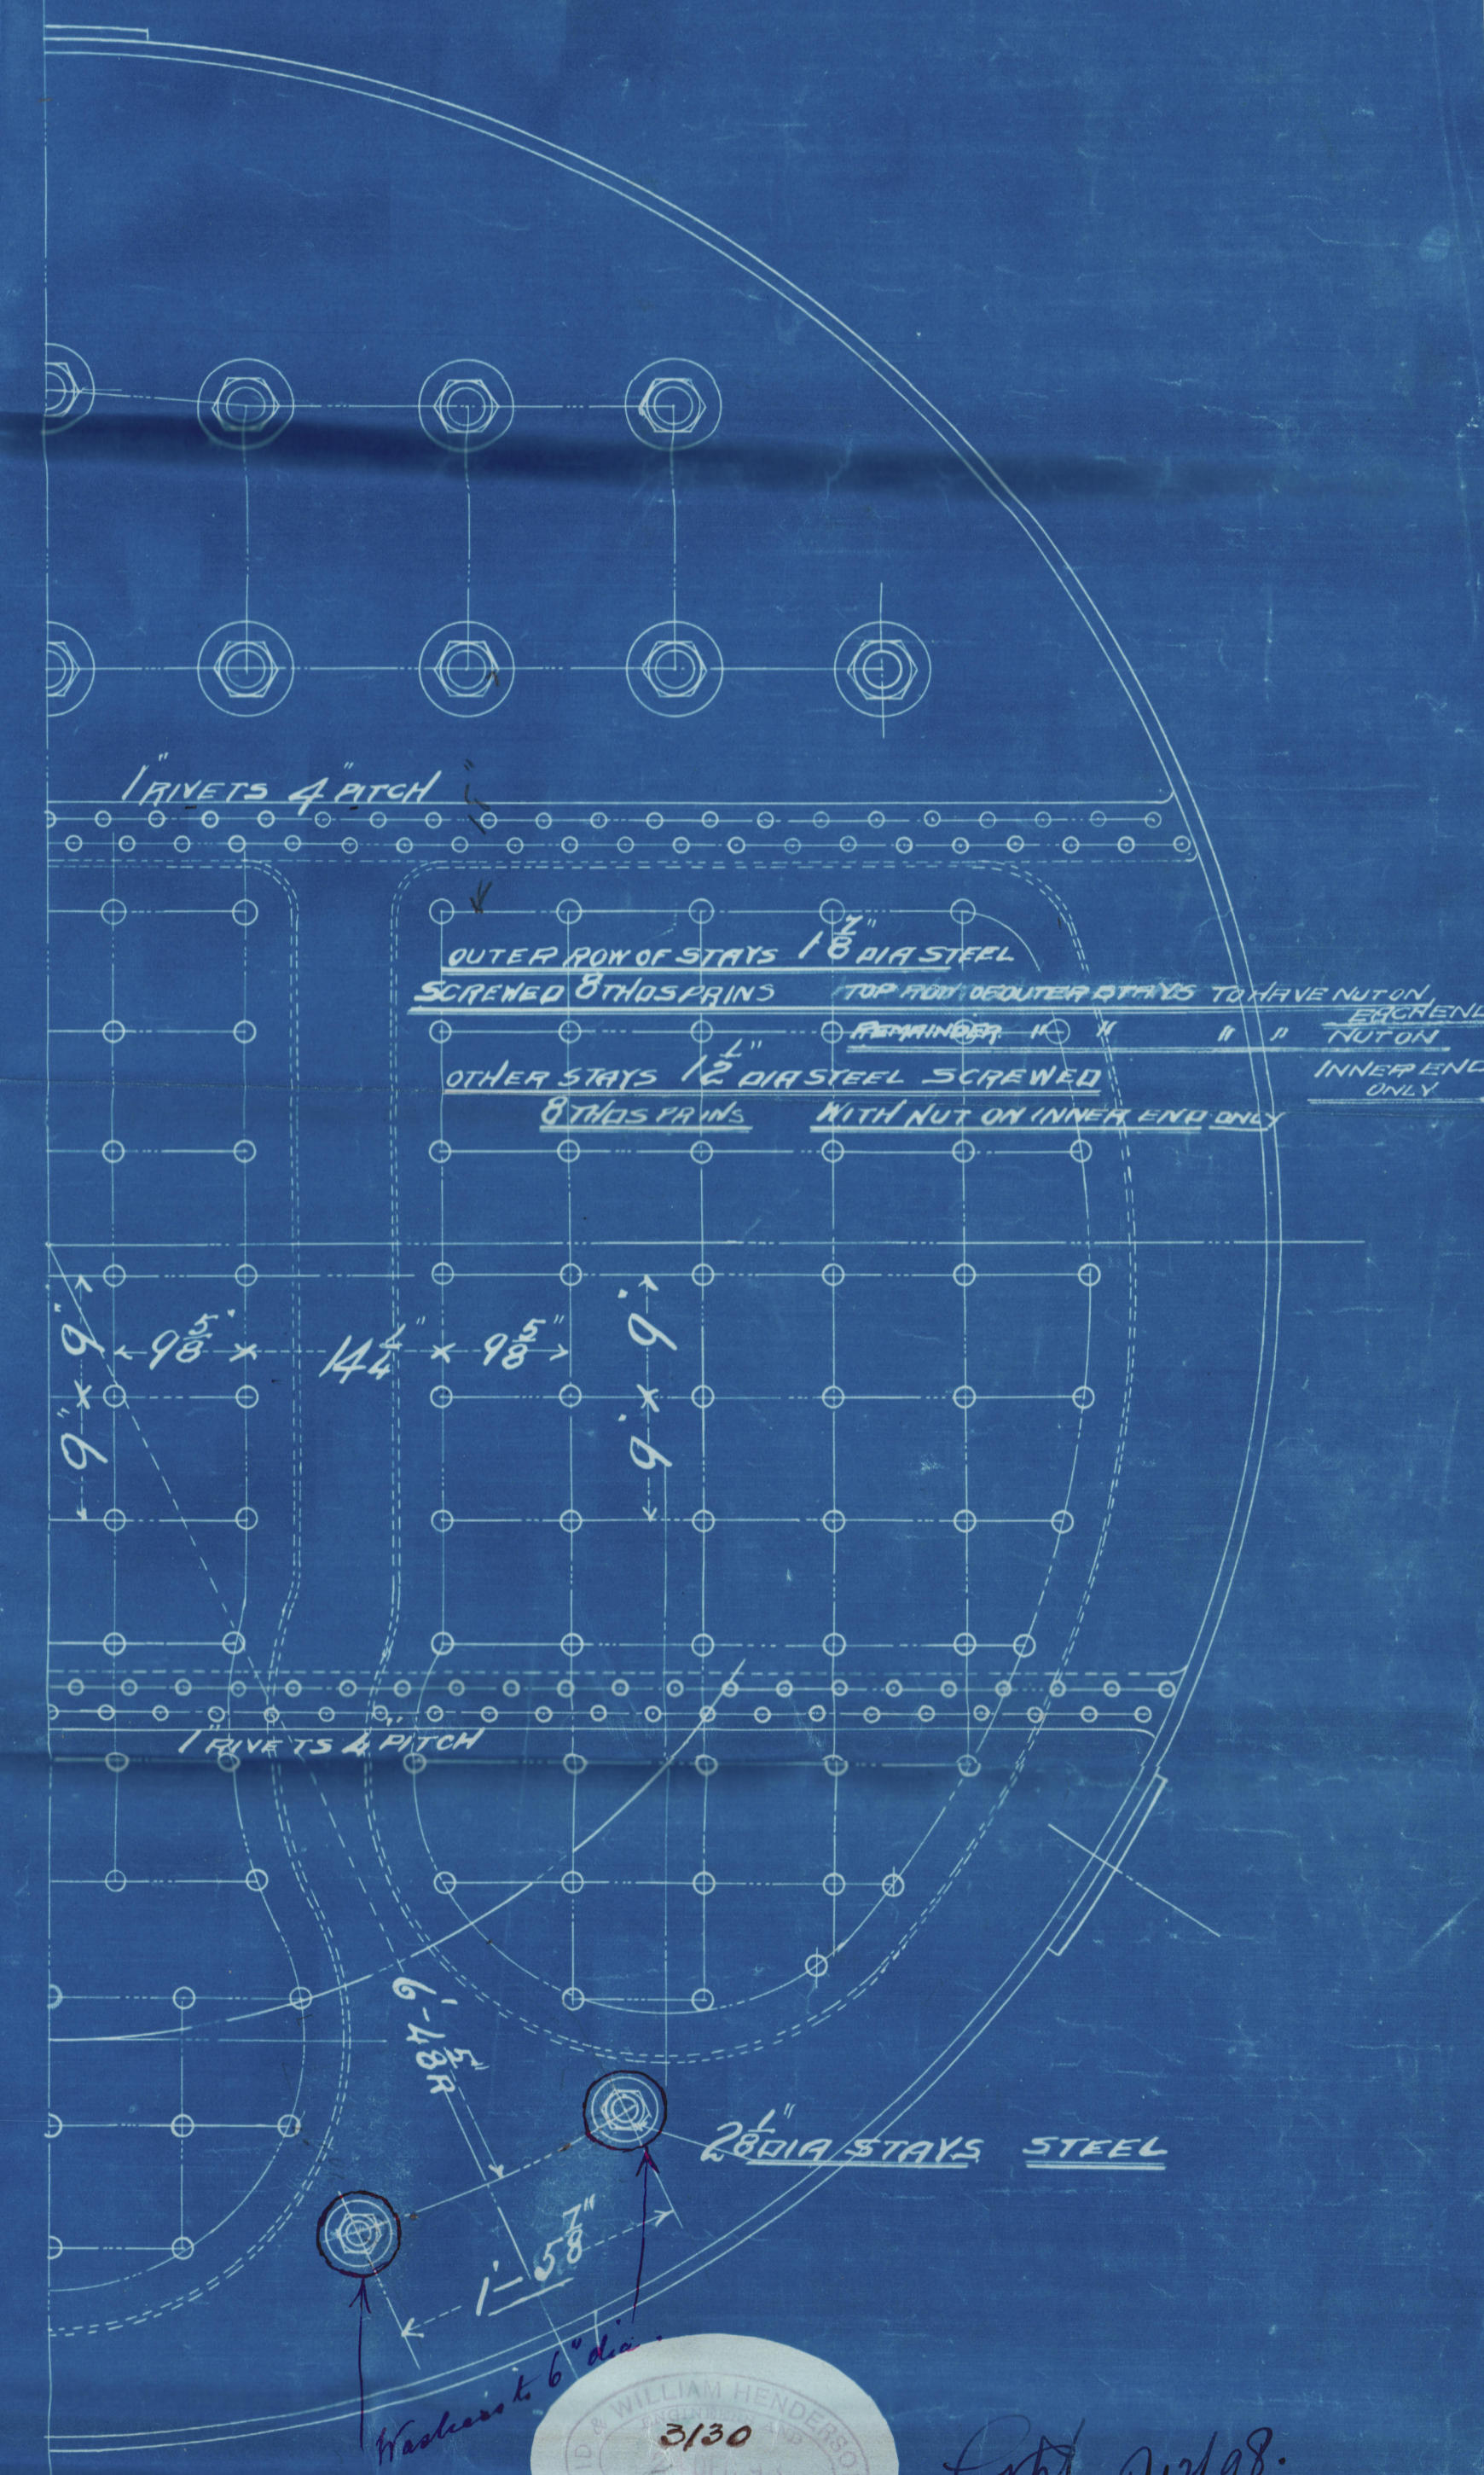

30.12.98

N<sup>o</sup> 789 BOILER  
FOR  
MESSRS MCKIE & BAXTER  
N<sup>o</sup> 148  
23.12.98

D. H. Henderson & Co 789  
 McKie & Baxter 148  
 Aikman 113 85

Tested 27/1/00  
 Leandroo  
 ex

S. S. "Heswick"

Glo Rpt no 17787

W1035-D260



W1035-0260

RETAIN



© 2020

Lloyd's Register  
 Foundation