

SCALE $\frac{1}{2}$ INCH = 1 FOOT.

TO CLASS 100 A.1. (STEEL) RAISED QUARTER DECK BRIDGE & TOP FORECASTLE

EQUIPMENT (?)

2 BOWER ANCHORS 12 cwt. EX STOCK } COLL^E WT. OF { 15 cwt. STOCKLESS } COLL^E WT.
1 _____ 10 1/2 _____ } 3 1/2 cwt. OF { 12 3/4 _____ } 4 2 3/4 cwt.
1 STREAM _____ 4 _____ }
1 KEDGE _____ 2 _____ }
195 FATHOMS 1 3/16" STUD CHAIN CABLE (MIN. WT. 141-0-16)
60 _____ 13/16" STREAM CHAIN OR 3" STEEL WIRE.
75 _____ 8 1/2" TOWLINE OR 2 3/4" STEEL WIRE.
90 _____ 6" WARP.


Heswick

PROPORTIONS.


DEPTH TO LENGTH ---- 12.29

BREADTH TO ---- 6.39

FORECASTLE DECK BEAMST BULG $5 \times \frac{6}{20}$ on all $\frac{1}{2}$ frames.
 _____ STRINGER $20 \times \frac{20}{20}$ to $16 \times \frac{20}{20}$. ANGLE $2 \frac{1}{2} \times 2 \frac{1}{2} \times \frac{20}{20}$.
 _____ TIES $8 \times \frac{6}{20}$. DECK $2 \frac{5}{8}$ PINE.
 BRIDGE DECK BEAMS ANGLE $5 \times 3 \times \frac{20}{20}$ on all $\frac{1}{2}$ frames.
 _____ STRINGER $20 \times \frac{20}{20}$. ANGLE $2 \frac{1}{2} \times 2 \frac{1}{2} \times \frac{20}{20}$.
 _____ TIES $8 \times \frac{6}{20}$. DECK $2 \frac{5}{8}$ PINE.

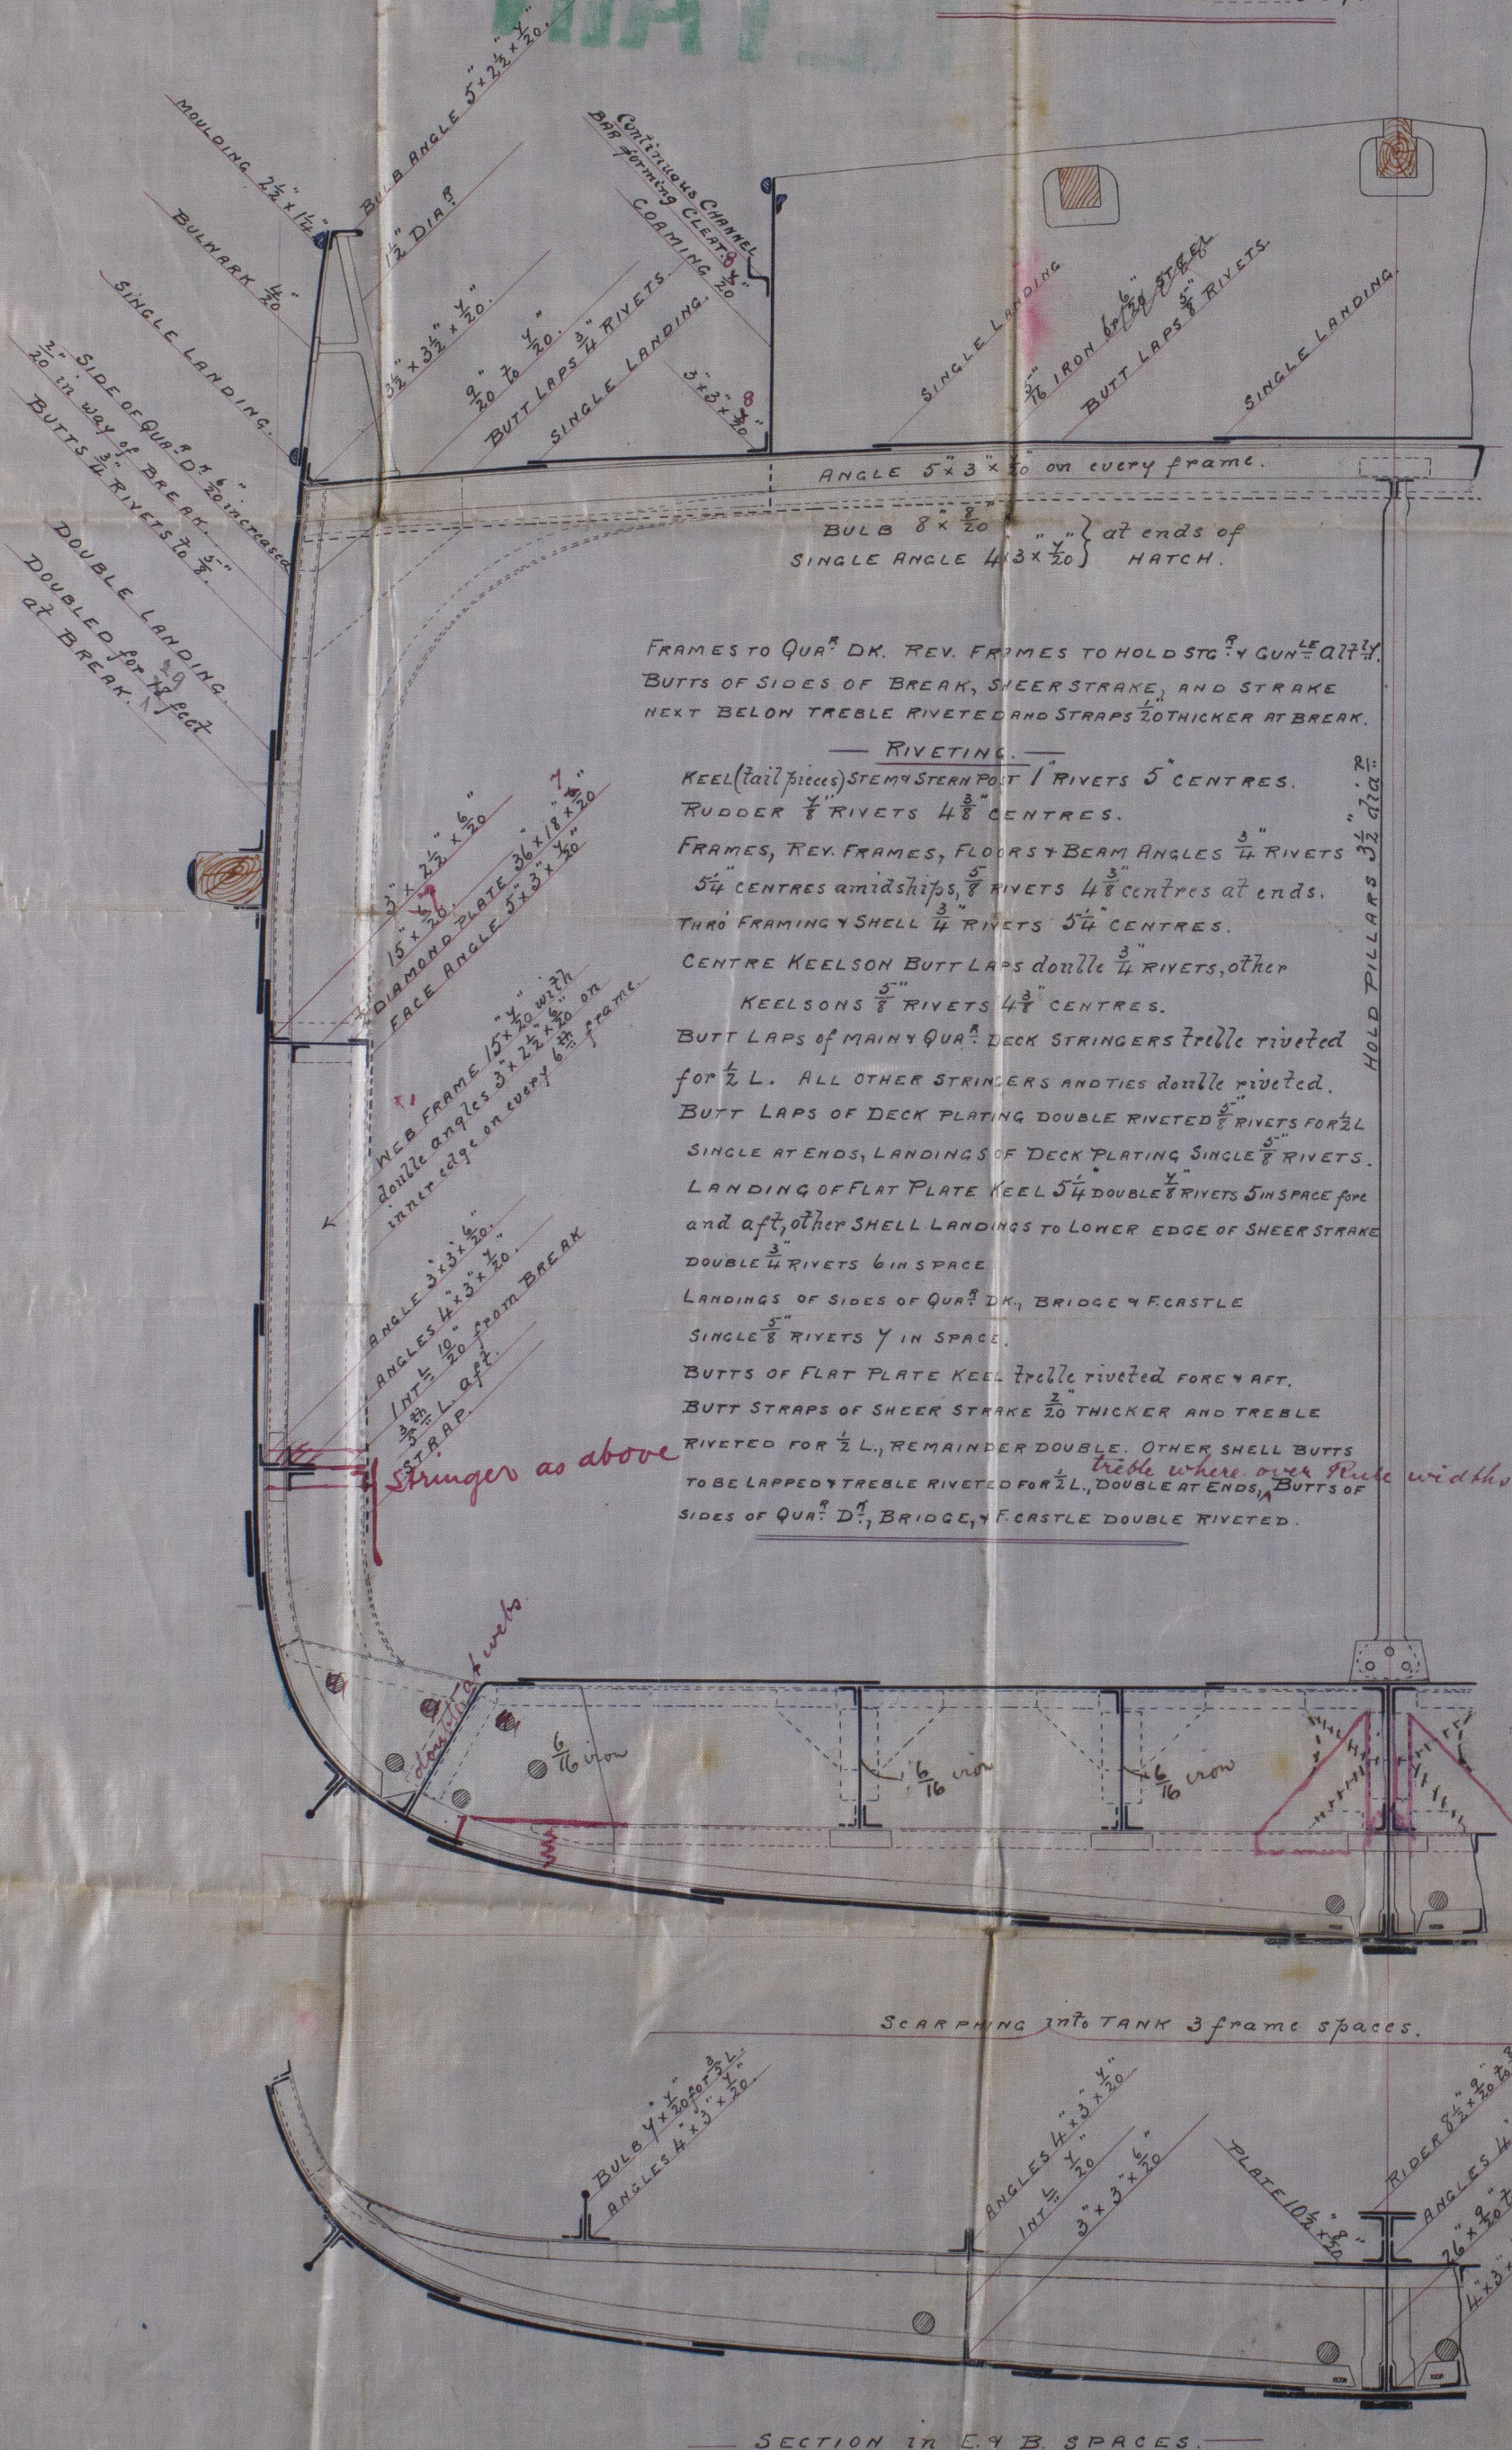

SECTION IN E. & B. SPACES.

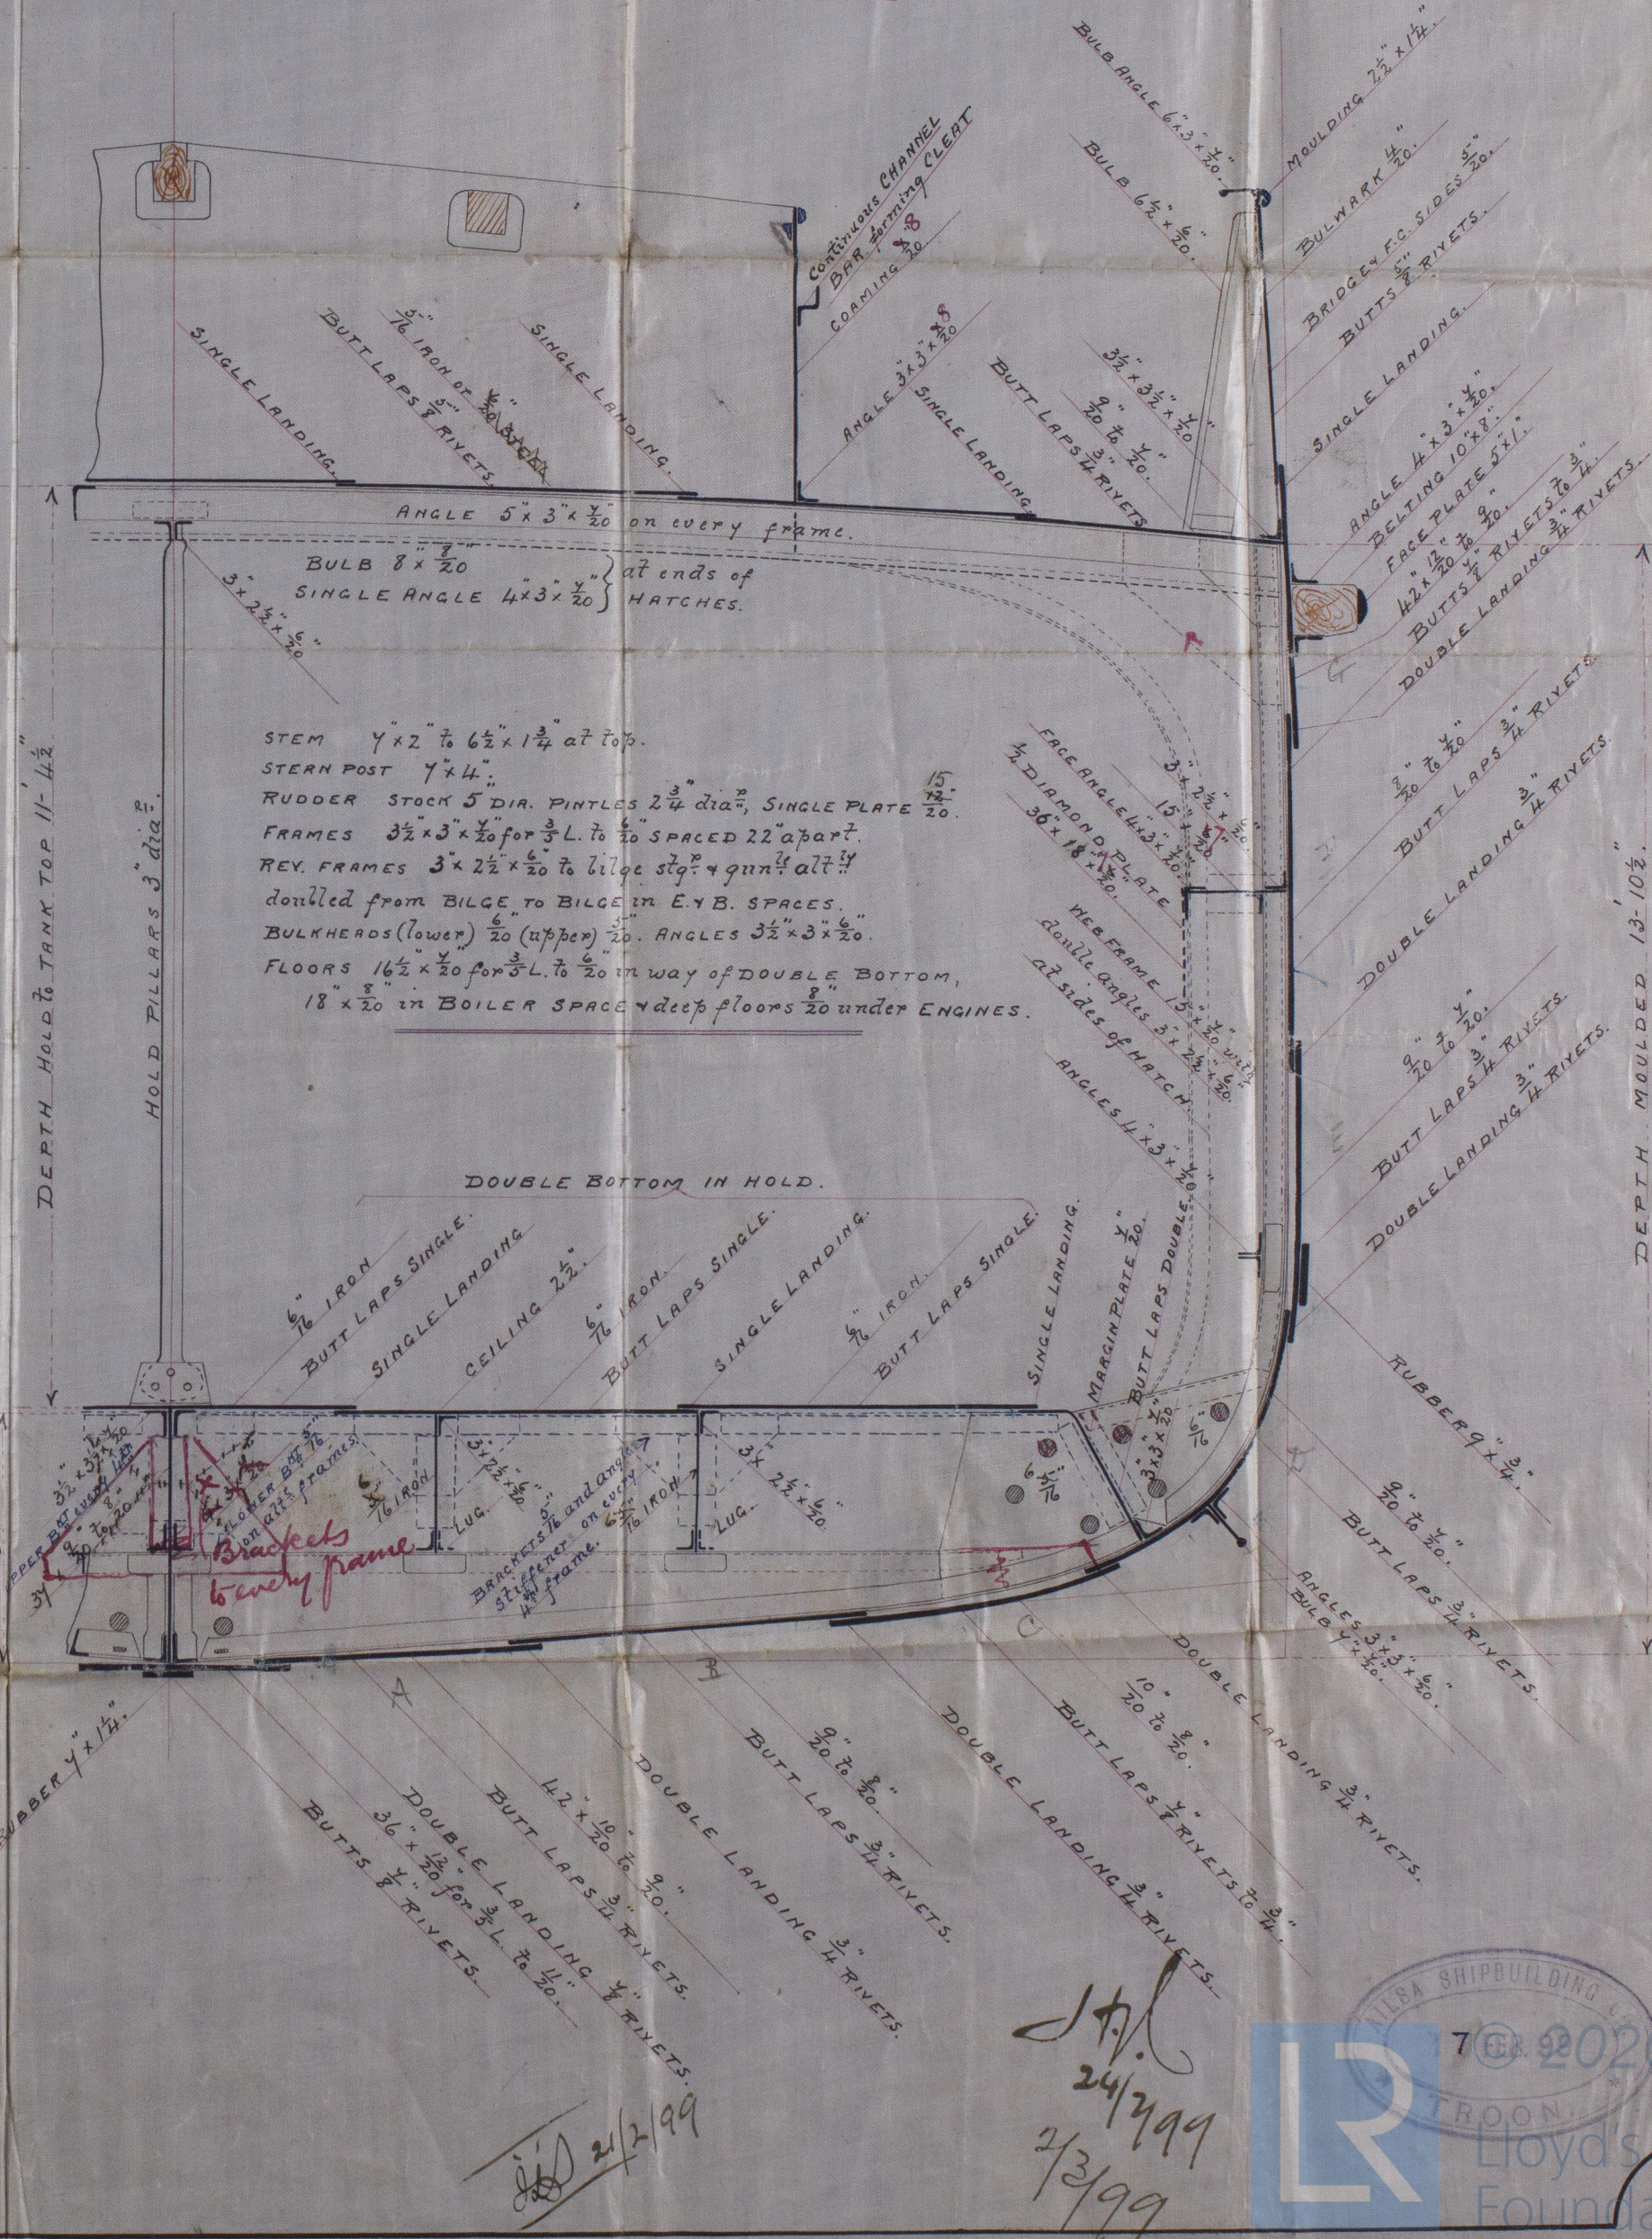

13-10 $\frac{1}{2}$

W1035-0261

Ailsa S.B.C.

No. 85. 3/4 Fleswick

Chs. Rpt. No. 17787

N.N. "LEANDROS"

W1035-0261



85-

PP: 3-10

RETAIN
Midship section



© 2020

Lloyd's Register
Foundation