


Surveyors satisfaction
1877-1878

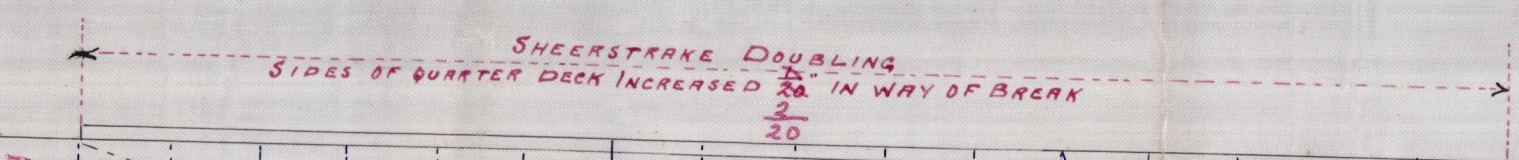

24/299
23/99

W1035-0264

Ailsa S. S. S.

"Leandro"
No 885/s. Hewick

Gls Rpt. No 17787

RETAIN



© 2020

Lloyd's Register
Foundation

