


C.L. OF BOILER.

C.L. OF BOILER

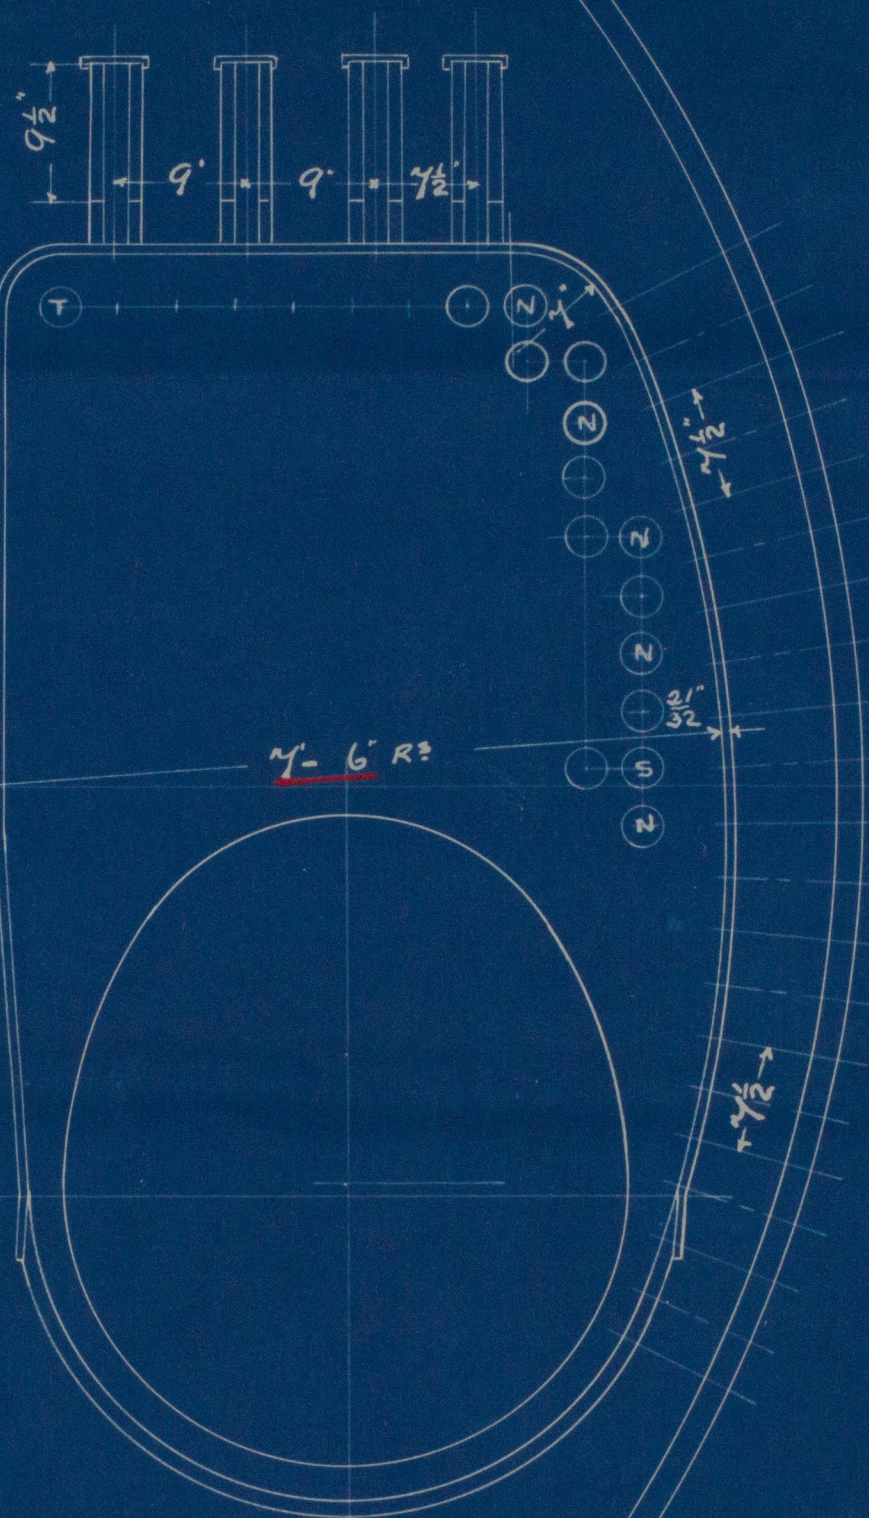

Nº 409 S.E. BOILER.

SKETCH SHEWING ALTERATION TO CHAS SIDES & STAYS

(FLY TO DRAWING Nº 8711)

DIMENSIONS THAT ARE ALTERED ARE UNDERLINED IN RED.

SCALE. 1" = 1'-0"

