

6.8.09  
16.9.09  
11.11.09

# MIDSHIP SECTION

PROPOSED S.S. 477'-0" x 62'-9" x 35'-3" TOP OF KEEL TO UPPER DECK BEAMS.

TO CLASS 100 A-1 AT LLOYDS SHELTER DECK CLASS.


SCALE 1/2" = 1 FOOT

## NUMERALS

B + D = 62.75 + 34.33 = 97.08  
L (B + D) = 97.08 x 477 = 46307  
46307 LONG. 10808. 30405. 32048. 288F 51035. EQUIPMENT. N°

## PROPORTIONS

9.4 DEPTHS TO BRIDGE DECK.  
11.1 " " SHELTER ---  
13.9 " " UPPER ---  
7.6 BREADTHS TO LENGTH.

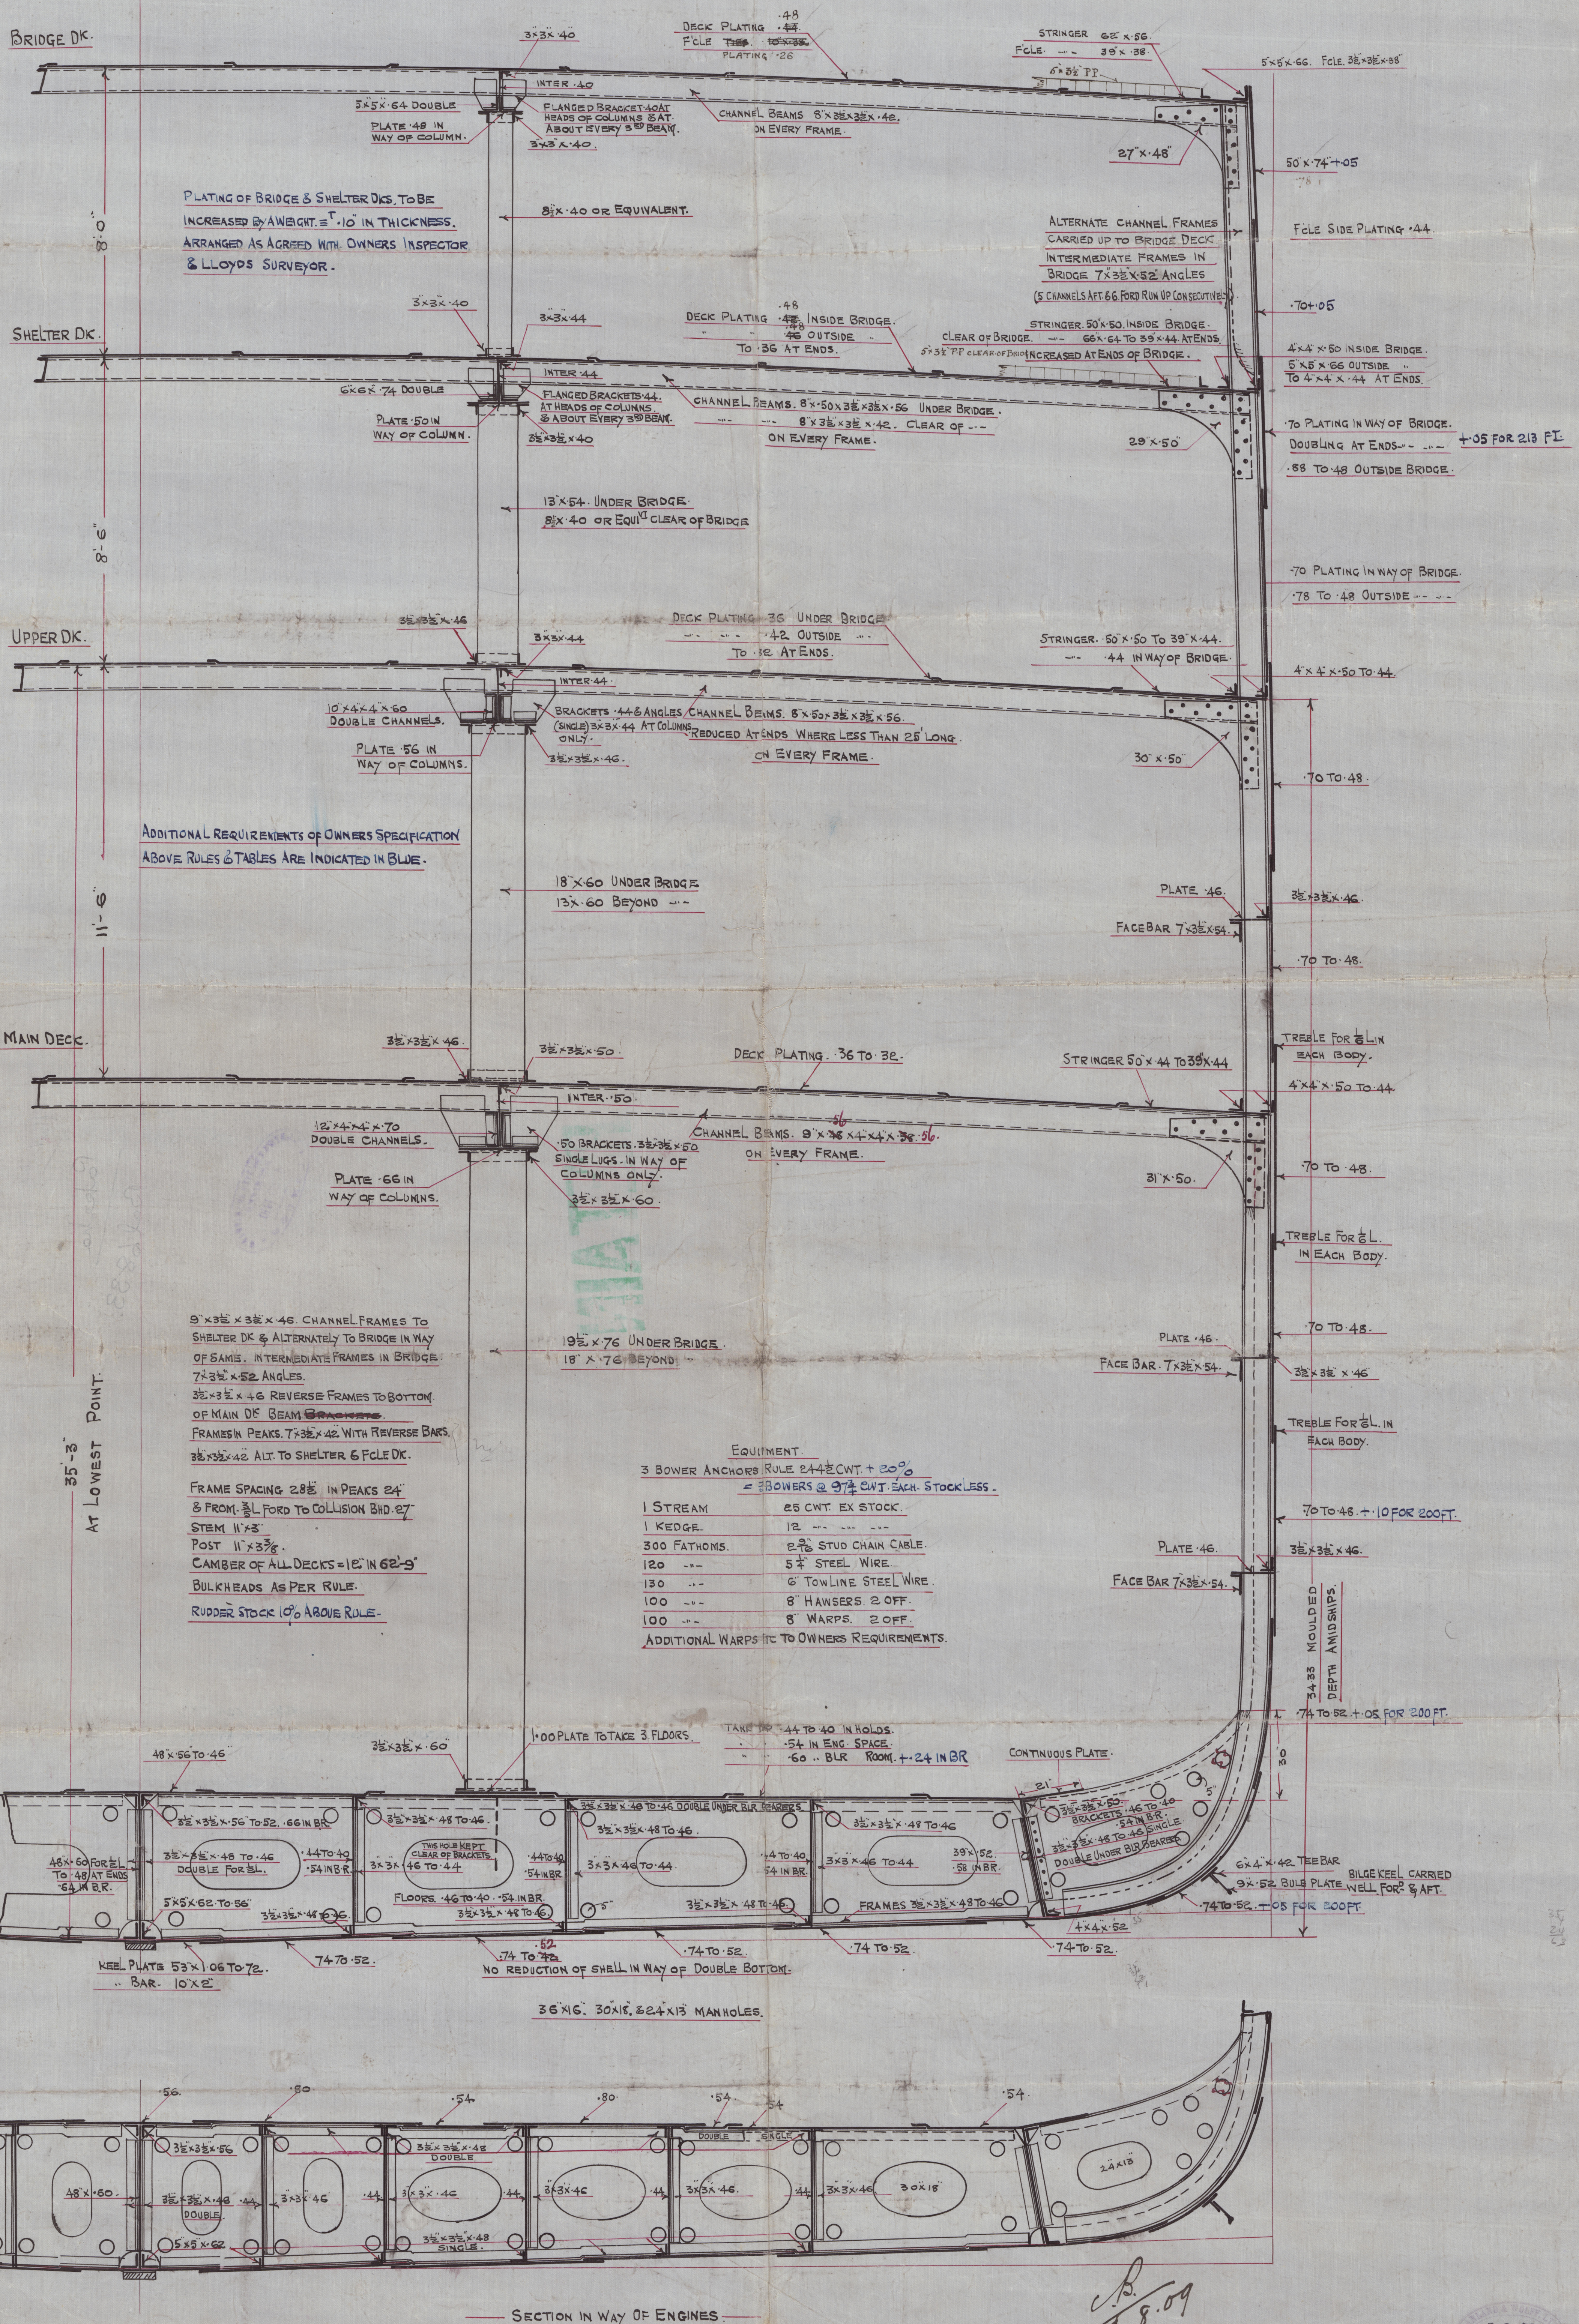




①

Amended Midship Section

Patcha

Pakeha

Bel 6833.

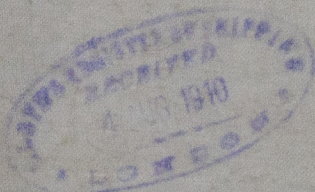

Lloyd's Register  
Foundation

21035-0041