


21.4.14
25.6.14





- PROFILE SHOWING SCANTLINGS OF TUBE PILLARS GIRDERS ETC. -

SCALE $\frac{1}{8}$ IN = ONE FOOT.

- Upper Deck Under Details -

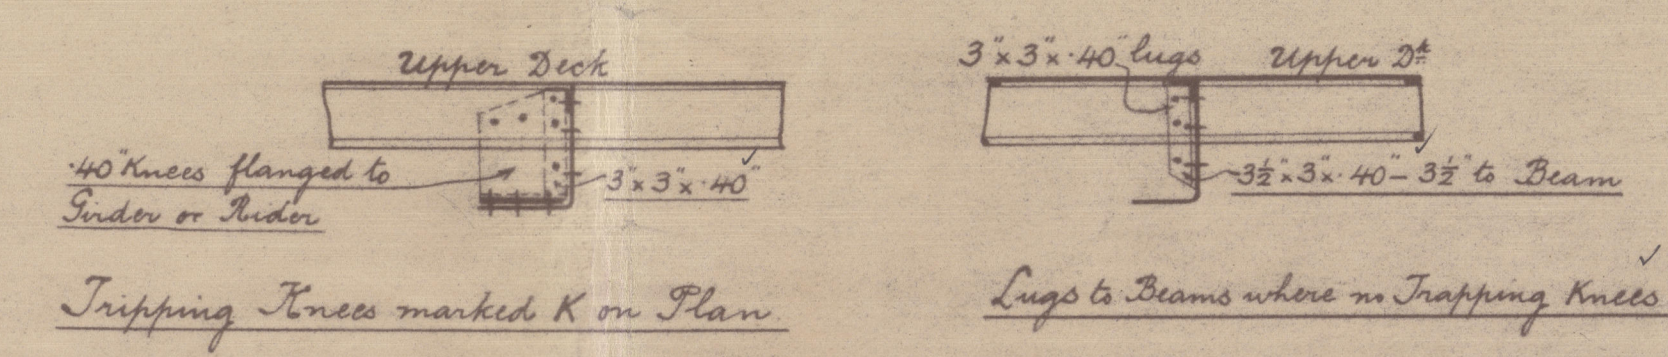

- Shelter Deck Under Details -

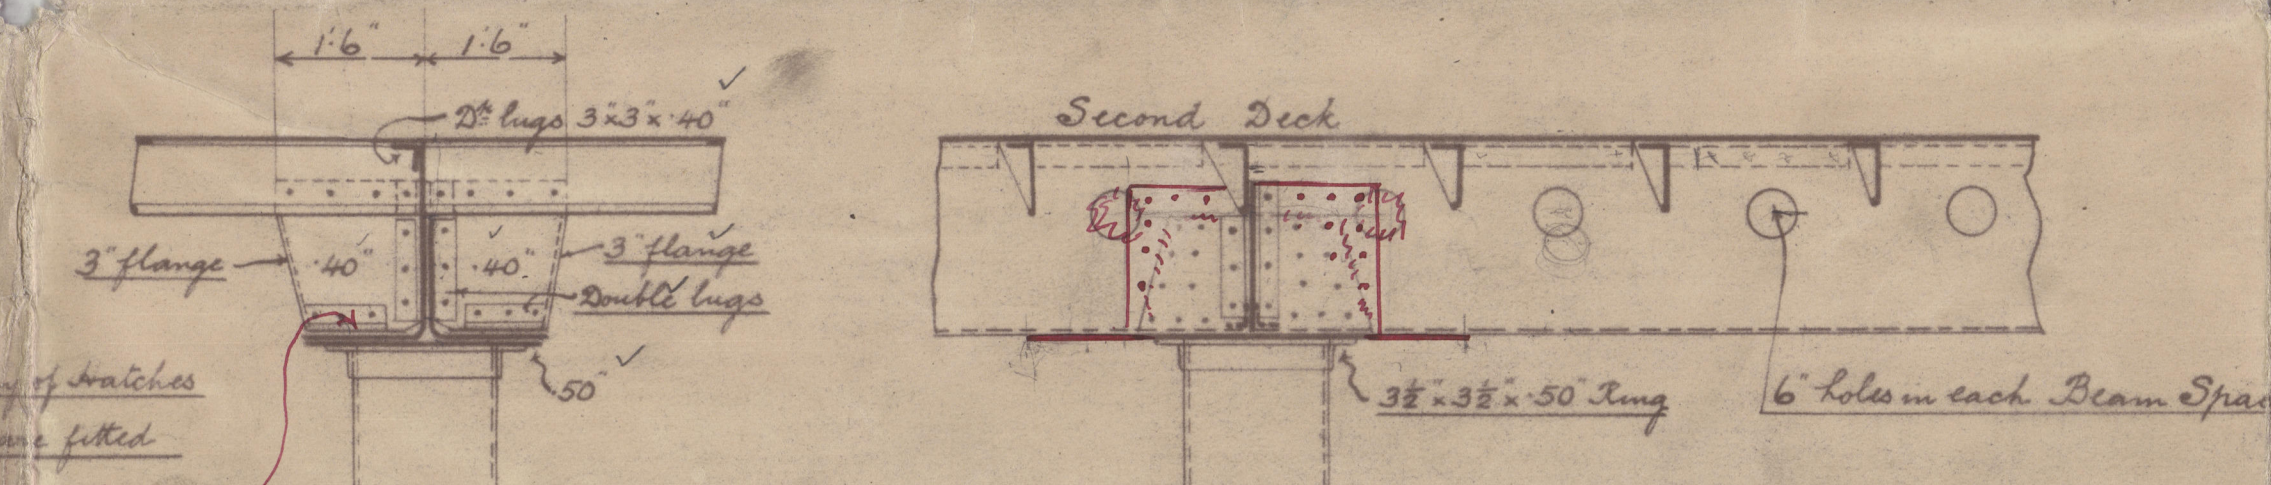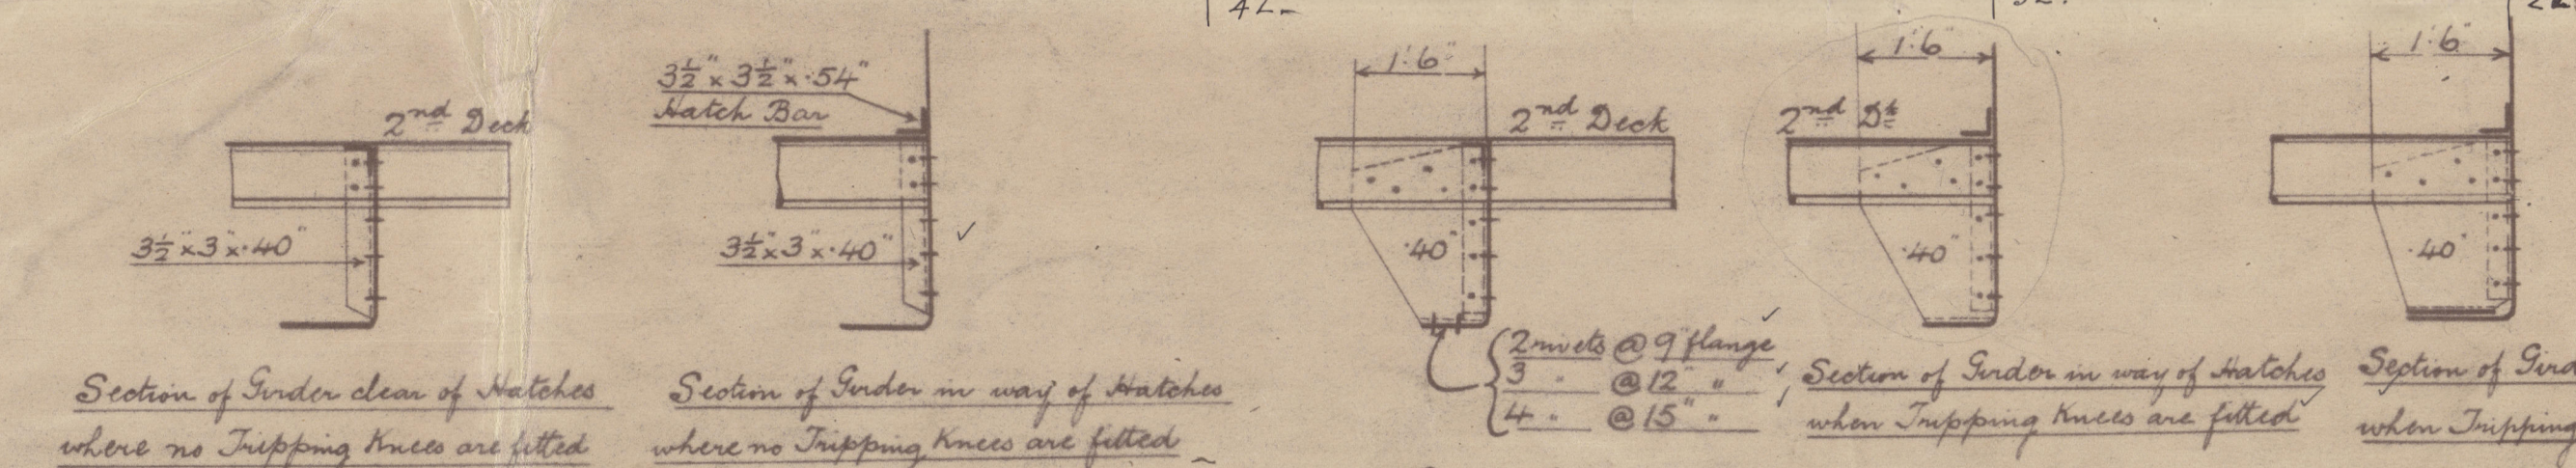 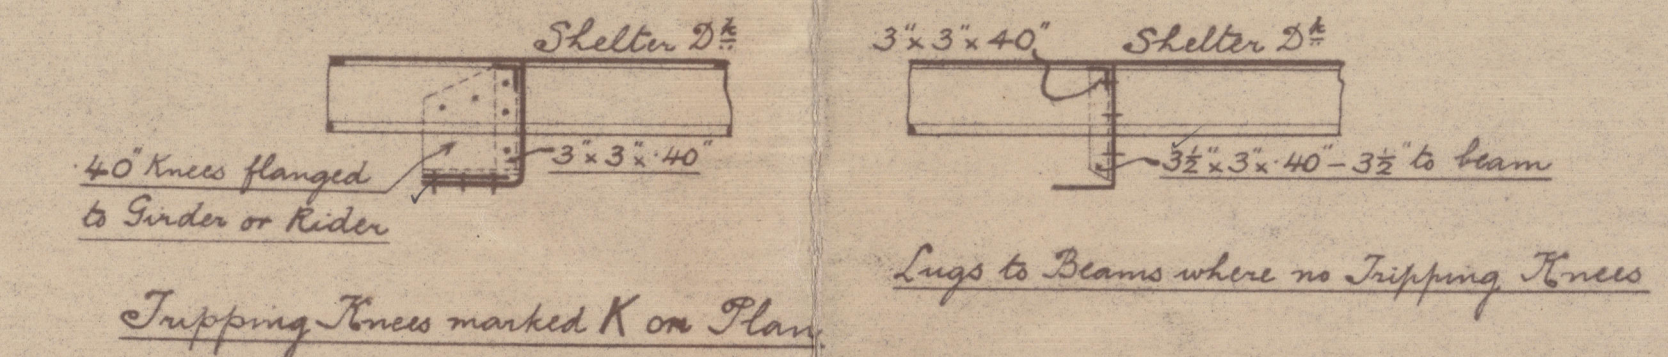


Where rider plates are fitted they are in all cases to be extended beyond the pillars at the ends of their spans.

Partial floors to be under hold pillars to be fitted as per detail plan.

Note: Trapping knees fitted to alternate beams.

C7
21.4.14

- Section at A185 Frame -

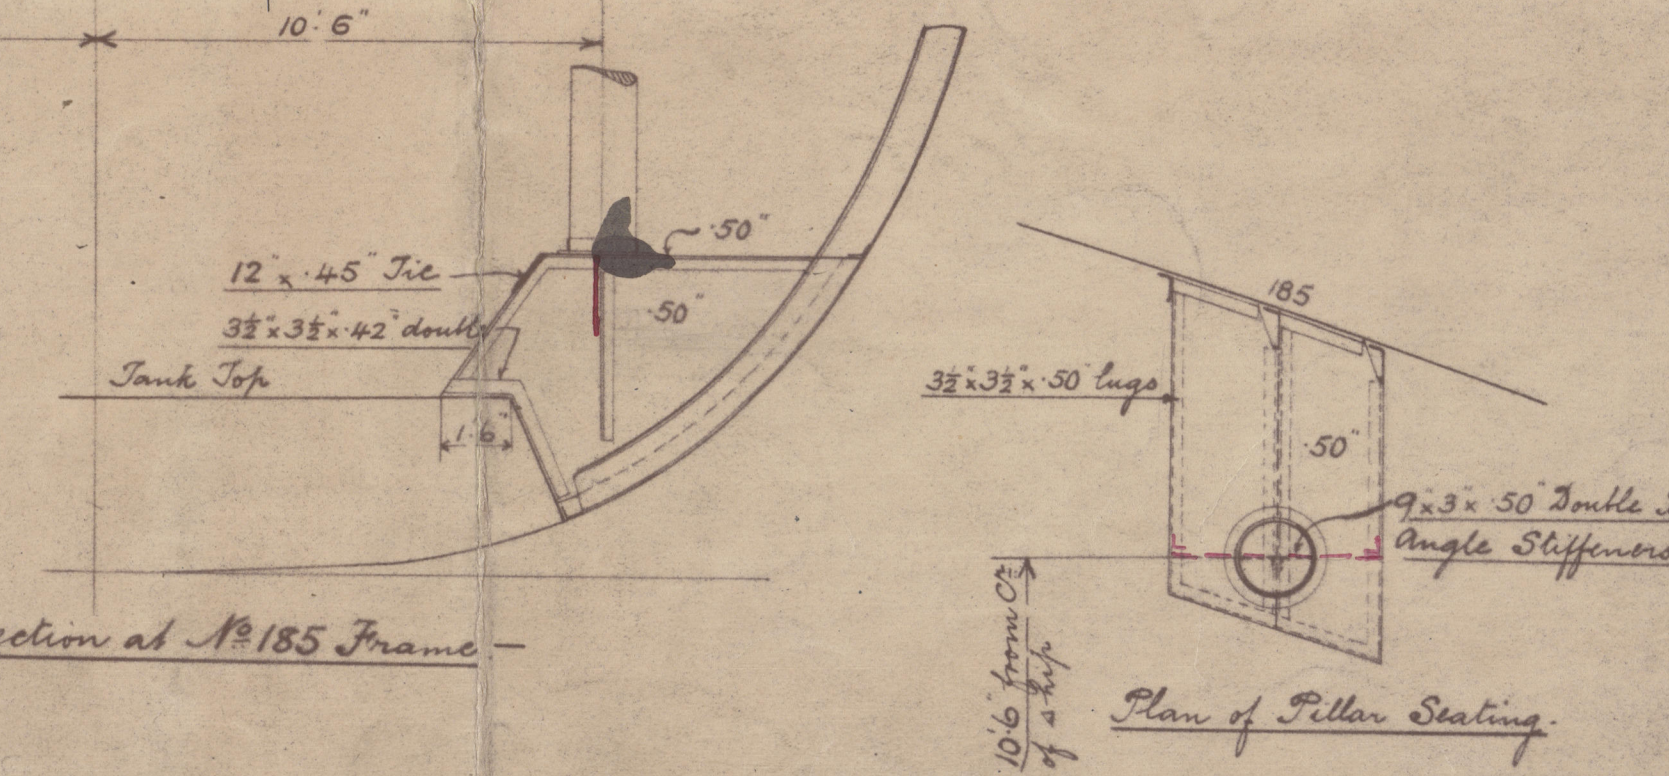


W. GRAY & CO LIMITED
IRON & STEEL
SHIP BUILDERS
MARINE ENGINEERS
AND
REPAIRERS
WEST HARTLEPOOL

Profile. showing scantlings of tube
tubular pillars girders etc.


Messrs Wm. Gray & Co., Lim.

s/s. *N^o 847*

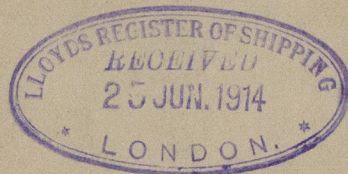


S. S. "Niwana"

W. Appl. Rph. No. 15015

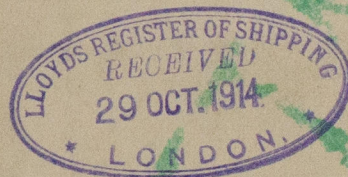

Chs

Chs Gray

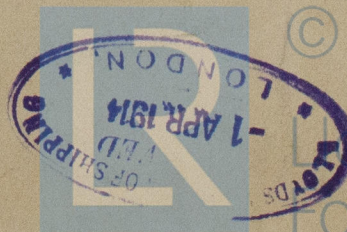

© 2020

Lloyd's Register
Foundation