


29.9.08  
 5.10.08  
 9.10.08  
 17.10.08  
 27.10.08  
 27.10.08  
 16.11.08  
 25.3.09

—FREEBOARD PARTICULARS.—

LENGTH OF LOAD LINE.	398.6
MOULDED DEPTH TO UPPER DECK.	23'-6 1/4"
TONNAGE UNDER DECK.	4570
LENGTH OF ERECTIONS.	201'
MEAN SHEER OVER TOTAL LENGTH.	80"
SHEER FORWARD.	110
AFT.	56
AT 1/2 LENGTH FROM STEM.	61
STERN.	27 1/2
MEAN SHEER AT 1/2 LENGTH.	44 1/4


Pos'n 27  
 BRIDGE 120  
 MOULDED 44 ON L.W.L.  
 201

—PROFILE.—  
 —N<sup>o</sup> 327-SS—  
 —SCALE 1/8" = 1' 0".—  
 TO CLASS 100-A.1. AT LLOYDS. SPAR DECK STRENGTHENED.

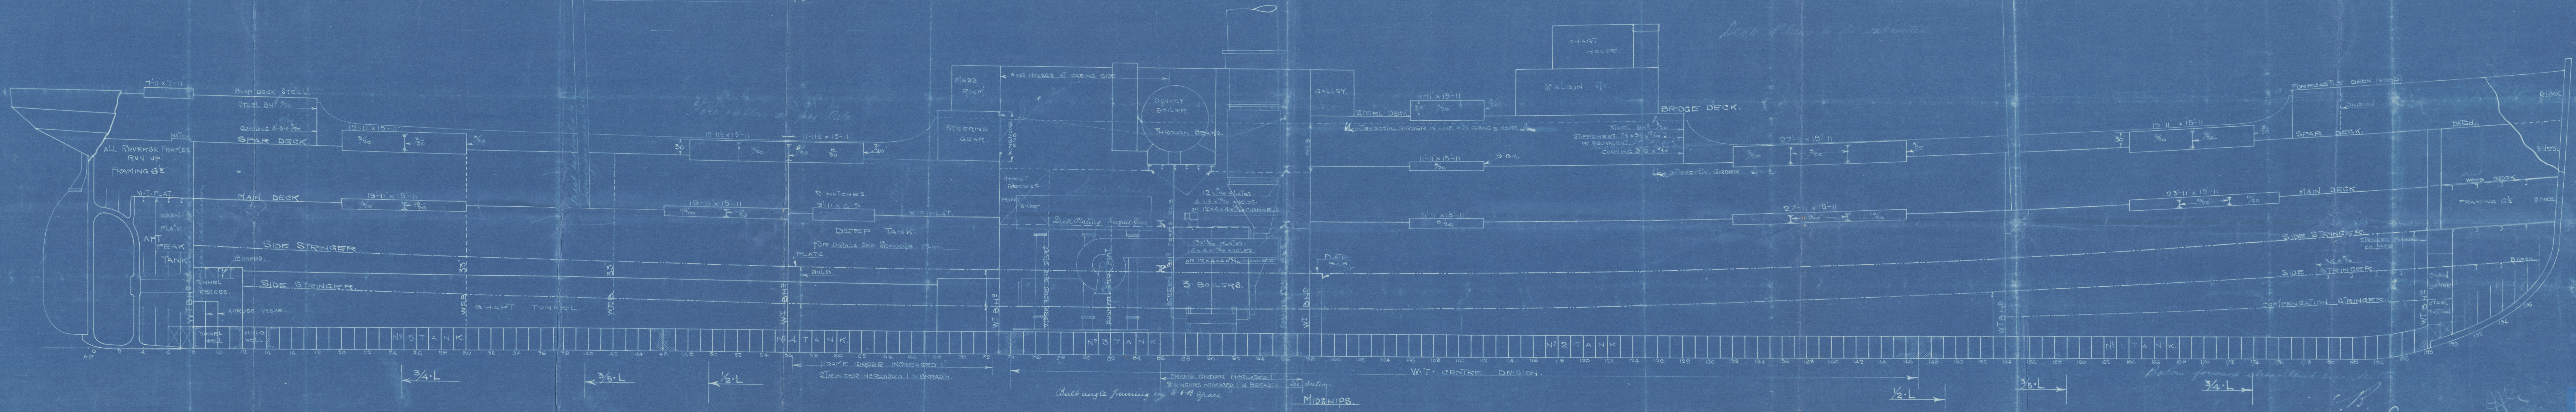

61-350-1-2  
 of wire  
 of canvas



Orion   
est

Glenshiel

Dec 28004.

---



Copy of  
Profile

N<sup>o</sup> 326 S/s

"GLENCLUNY."

Glasgow Report

N<sup>o</sup> 27448

Lloyd's Register  
Foundation

W1036-0148