


Mr. Blair
Lloyds

S.S. "ACCRINGTON" CABIN ARRANGEMENT

SCALE 1/4" = ONE FOOT

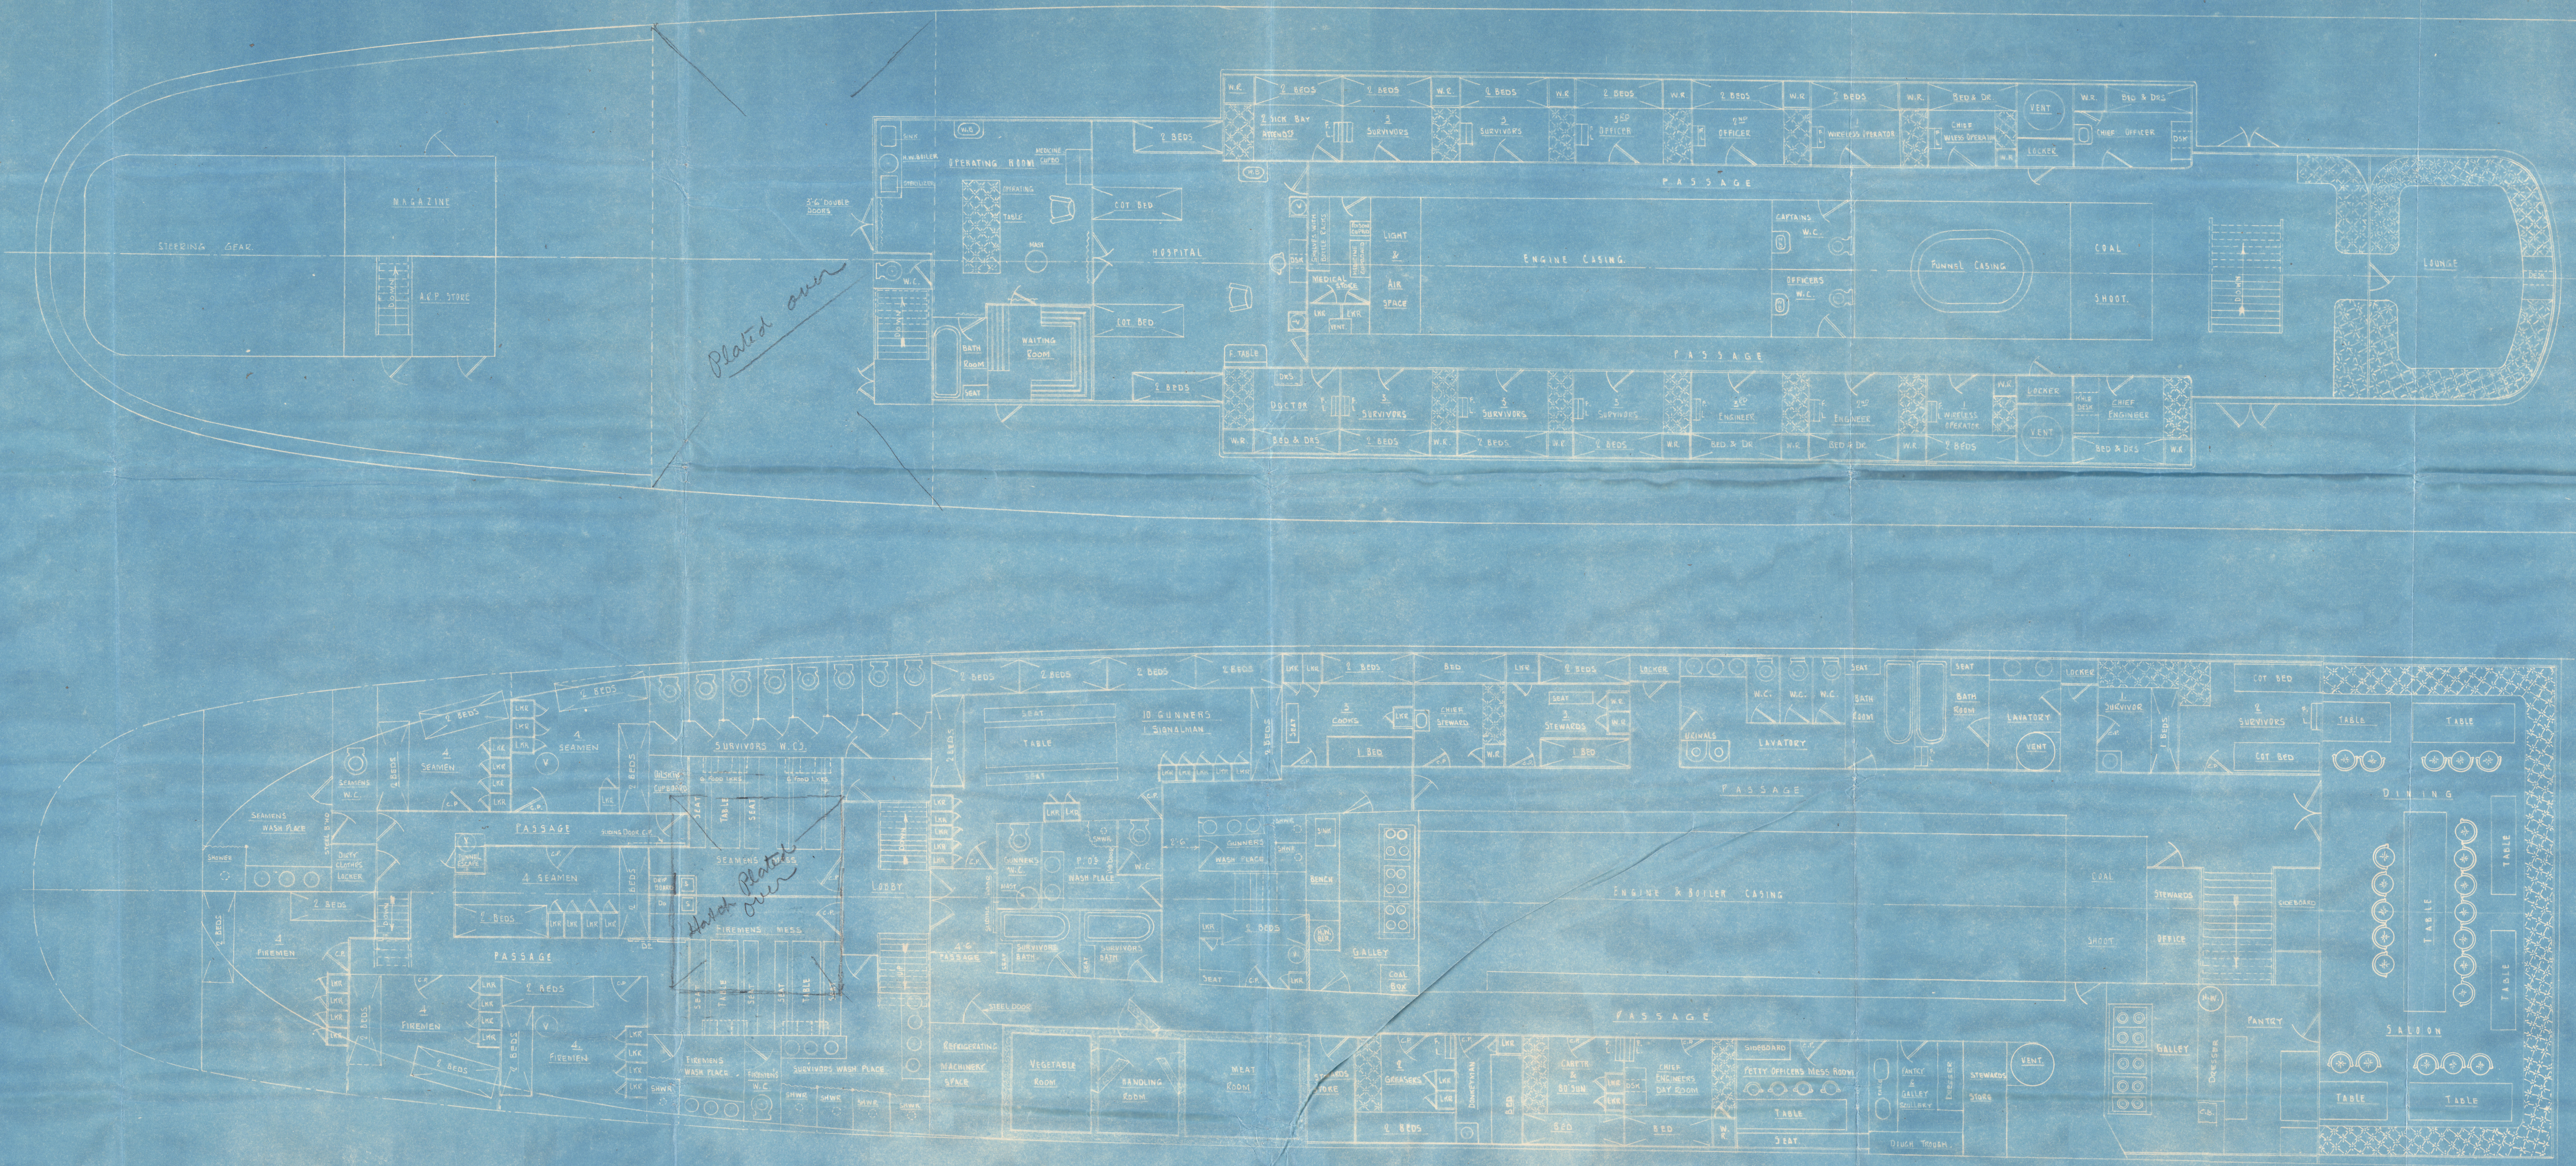

2/5 Accrington
General arrangement
Showing alterations

Hpl. 18319.

W1032-0019

RETAIN



© 2020

Lloyd's Register
Foundation