

2.5.12
16.5.12
22.5.12

LONGITUDINAL SECTION

S.S. N^{os} 519 & 20.

SCALE $\frac{1}{4}$ INCH = 1 FOOT

1st N^o 47-22

2nd N^o 7269-04





Masts supported to Surveyors satisfaction

Pillaring throughout to Surveyors Satisfaction

*See Pierhead Lmk
for 12/11/11 (4.10.11)
for alterations to Budget
Feb Accommodation*

Supported equal to 2 rows of pillars

*Bottom strengthened forward as per Rub
+ to Surveyors Satisfaction*

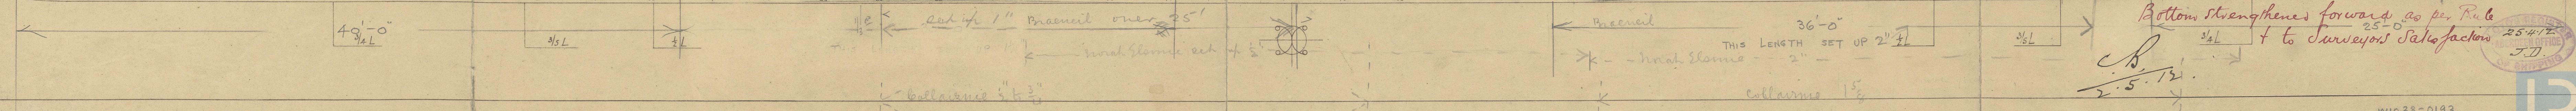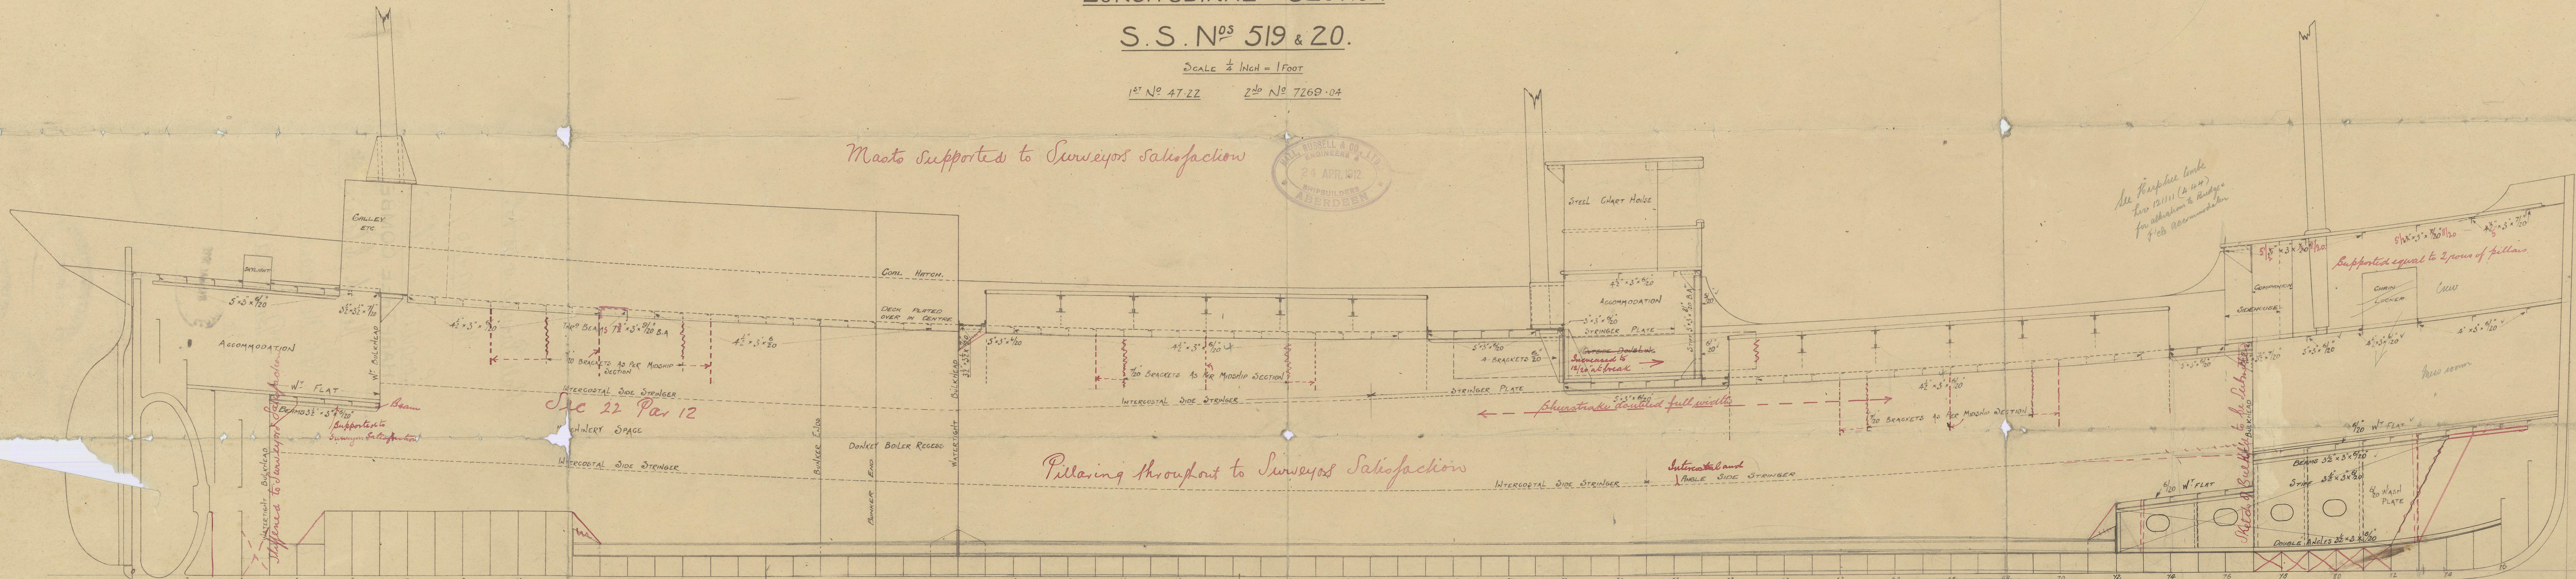

© 2020



Lloyd's Register Foundation

Hall Russell & Co. Ltd.

Nos. 519 + 20

* CLAIR T. w/s 590
- Longitudinal sections -

"HARPTREE COMBE" EX

519

S.S.

"Norah Elsmie" *







Abn. Rpt. No. 11010

520

S.S.

"Braeneil"

Abn. Rpt. No. 11011

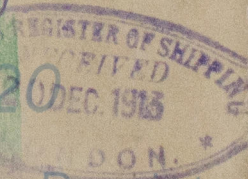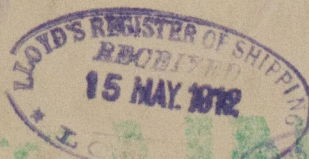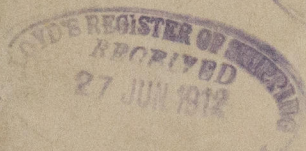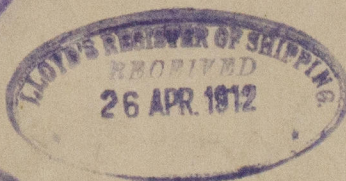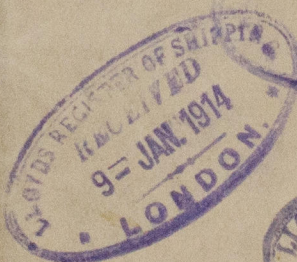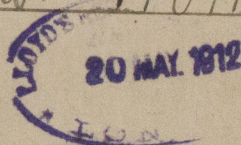

18 SEP 1912

Lloyd's Register
Foundation