

DECK PLAN  
S. S. N<sup>os</sup> 519 & 20.

SCALE  $\frac{1}{4}$  INCH = 1 FOOT

Coastline Comb - Liv. 12/11, 45 44  
Budge brethhouse extended from  
F's old shack replaced with steel  
chain locker moved & F's old  
pulled out for cement

C.B.  
2-5-12



© 2020  
Lloyd's Register  
Foundation  
W1038-0196



W1038-0196

Hall Russell & Co. Ltd.

Nos. 519 & 20.

- Deck Plans.

HARPTREE COMBE EX

519

S.S.

"Norah Elmie"

Abn. Rpt. No. 11010


520

S.S.


"Braeneil"

Abn. Rpt. No. 11011.

CLAIRE. T.  
w/s 590.

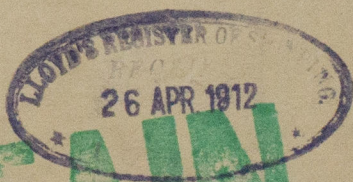

RETAIN

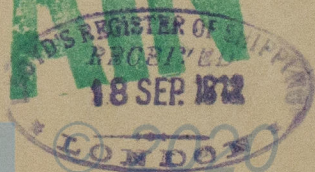

Lloyd's Register  
Foundation