

2.5.12  
16.5.12  
22.5.12

# MIDSHIP SECTION

SS N<sup>os</sup> 519 & 20



## RIVETING

BUTTS OF SHELL INCLUDING SHEERSTRAKE AND GARDBOARD OVERLAPPED AND TREBLE RIVETED FOR 2L.  
DOUBLE AT ENDS  
BUTTS OF ~~MAIN~~ QUARTER DECK STRINGER PLATES DOUBLE RIVETED THROUGHOUT, *main treble riv. for 1/2 len.*  
BUTTS OF DECK PLATING DOUBLE RIVETED FOR 2L.  
SINGLE AT ENDS

## SCALE 1/2 INCH = 1 FOOT

## DIMENSIONS

LENGTH BETWEEN PERPENDICULARS	155' 0"	TRANSVERSE N <sup>o</sup>	17' 22"
BREADTH MOULDED	25' 0"	LONGITUDINAL N <sup>o</sup>	72' 63' 04"
DEPTH	11' 8"	4/B	6' 15"
		4/D	12' 65"



## CLASS 100 A.I.

## LLOYD'S NUMERALS

HALF BREADTH	12' 5"	EQUIPMENT N <sup>o</sup>	
HALF GIRTH	22' 5A"	QUARTER DECK	31' 35' 2" 637' 00"
DEPTH	12' 18"	BRIDGE	8' 75' 7' 15" 91' 87"
TRANSVERSE N <sup>o</sup>	17' 22"	FORECASTLE	22' 6' 25' 15" 206' 75"
LENGTH	155' 0A"	EQUIPMENT N <sup>o</sup>	820A' 16"
LONGITUDINAL N <sup>o</sup>	72' 63' 04"		

## EQUIPMENT

2. POWER ANCHORS EACH	10L CENTS	STOCKLESS
1	8 1/2	
1 STREAM	3 1/2	EX. STOCK
1 KEDGE	1 1/2	
165 FATHOMS	1/16	STUD LINK CABLE
60	2 1/4	STEEL WIRE
75	7 1/2	TOWLINE
90	5 1/2	HANSER

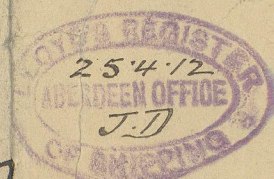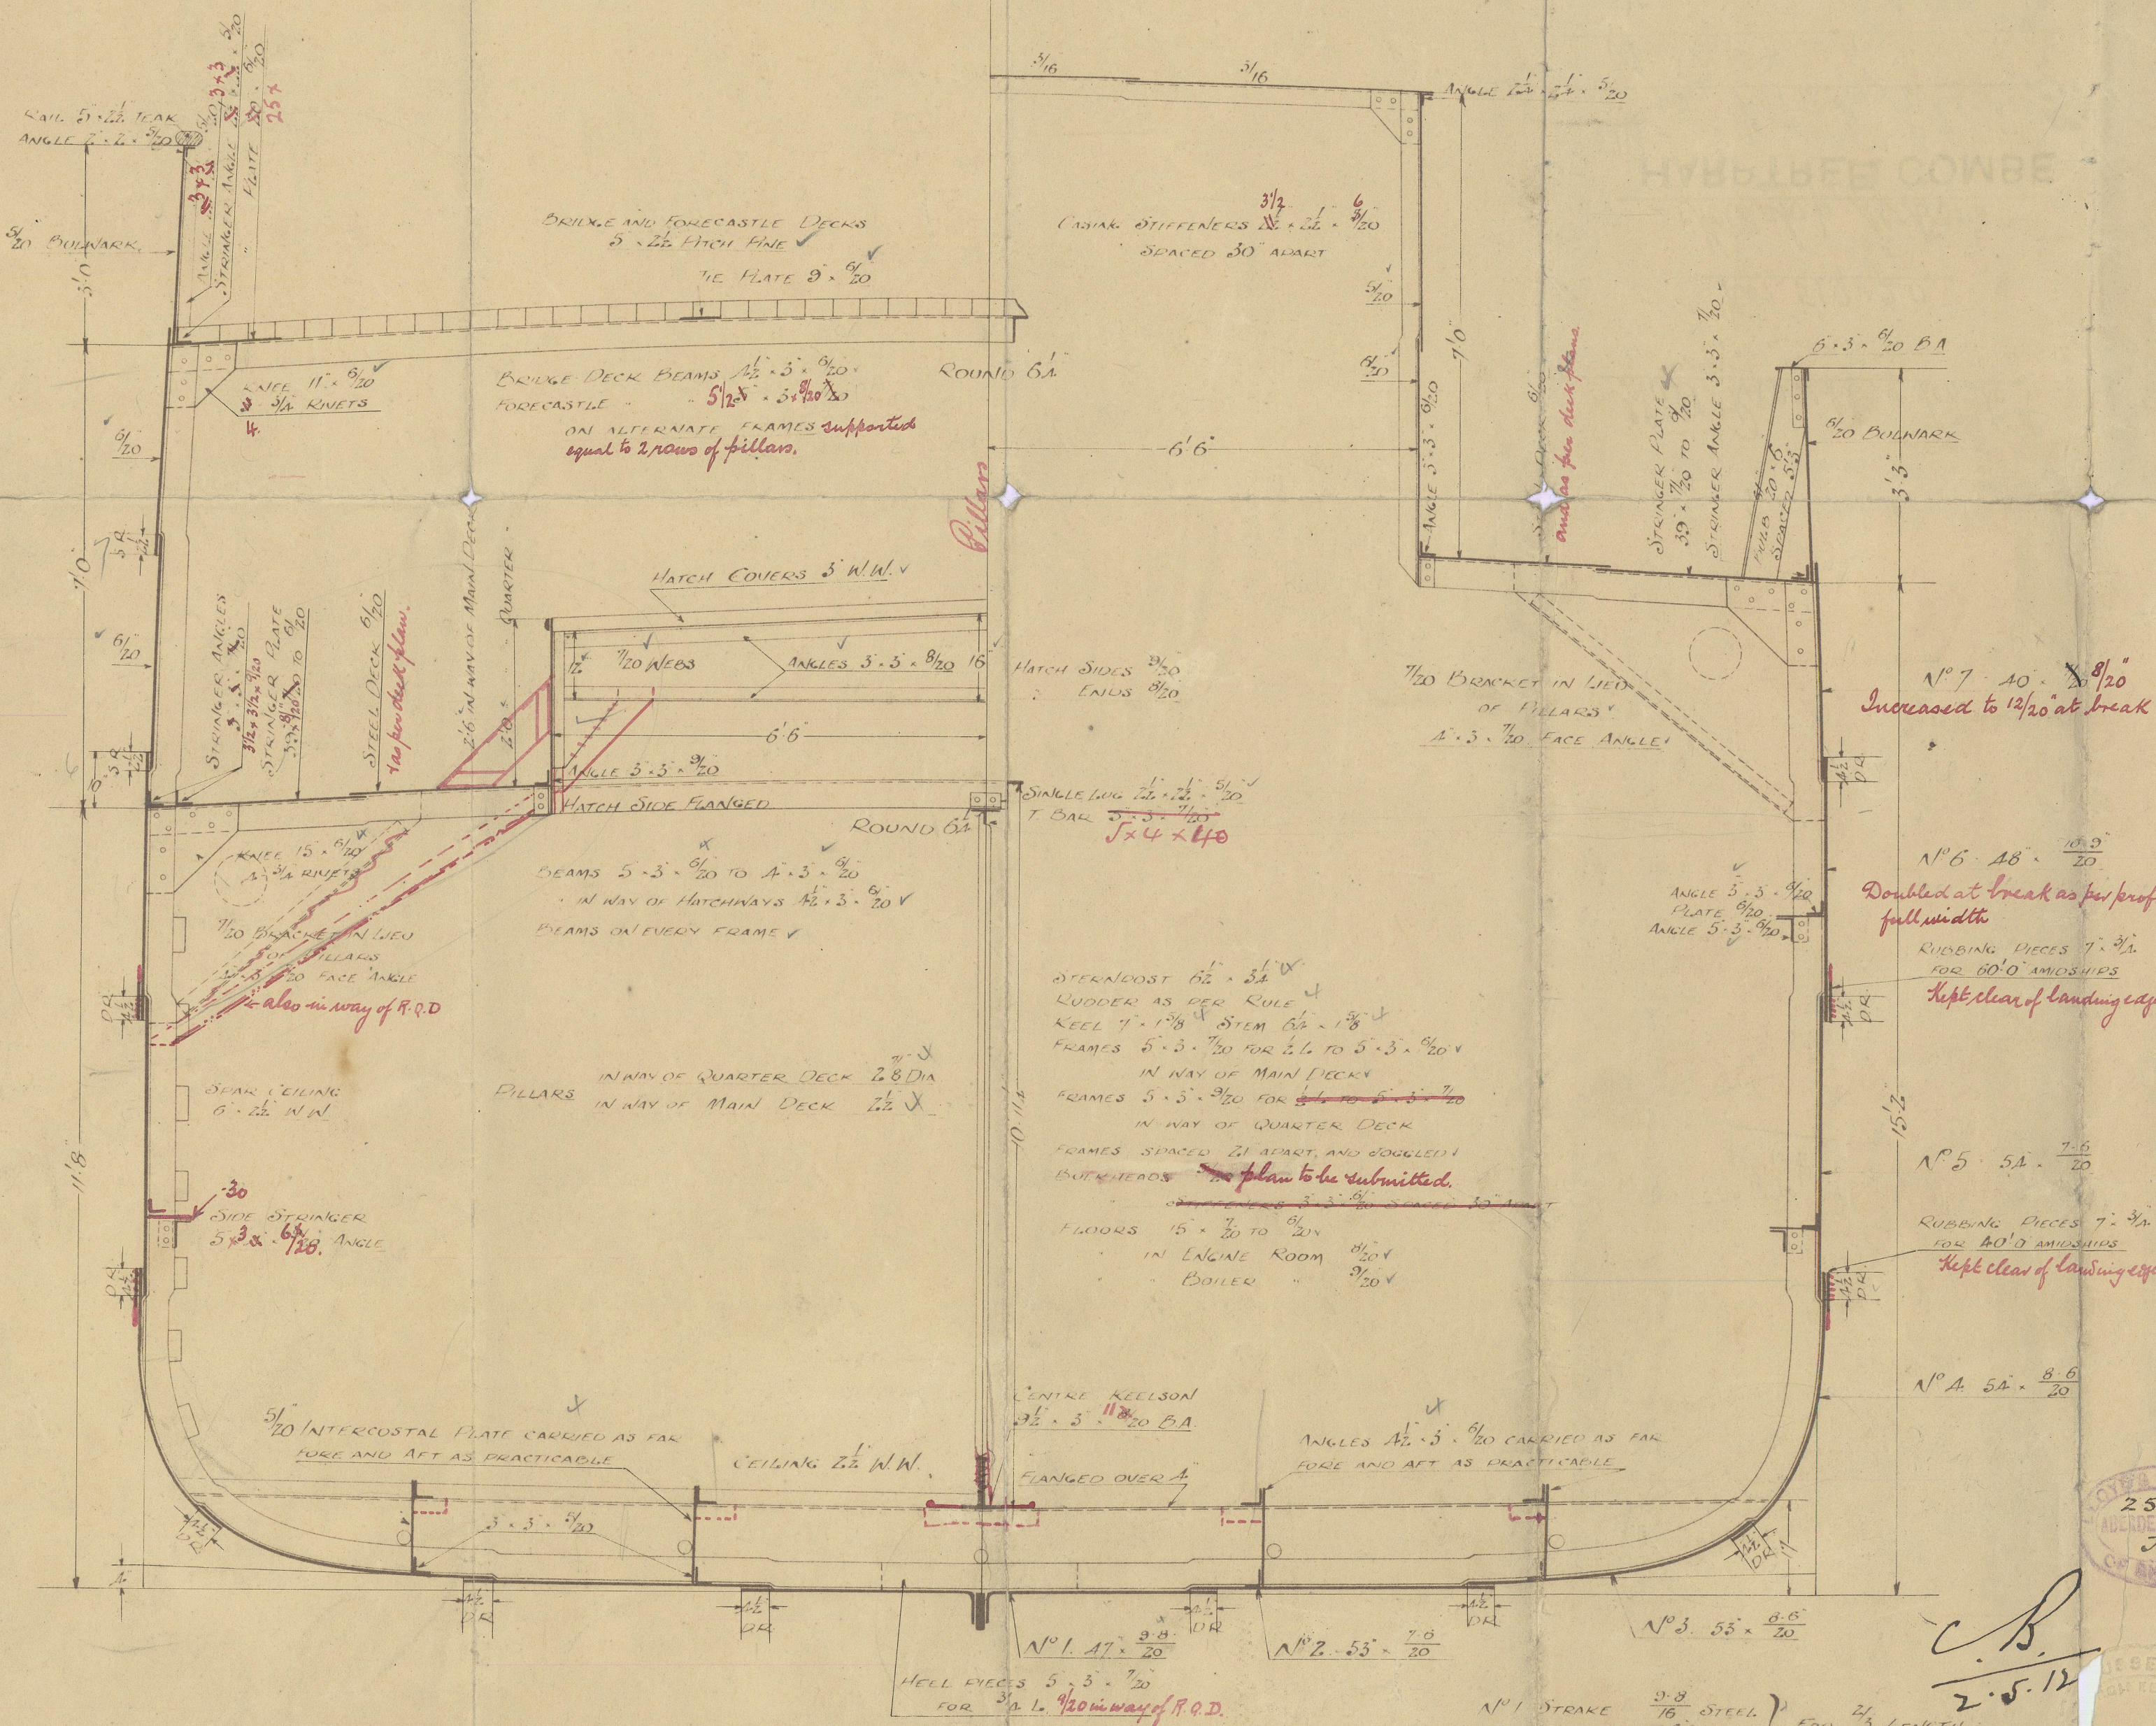

W1038-D 2020




Hall Russell & Co. L<sup>d</sup>

Nos. 519 &amp; 20.

- Midship Section -  
"HARPTREE COMBE

519.

S.S. "Norah Elsmie" 







Abn. Rpt. No. 11010

520

X. CLAIRE T.

S.S. "Braeneil" w/5590

Abn. Rpt. No. 11011

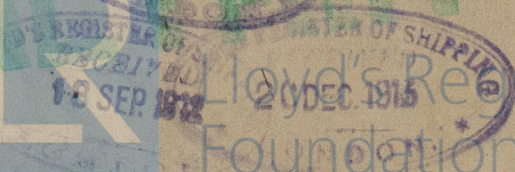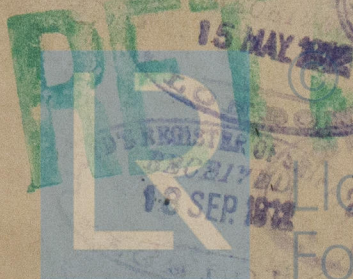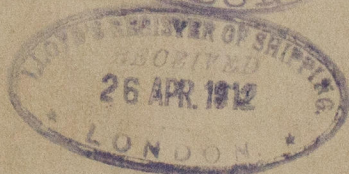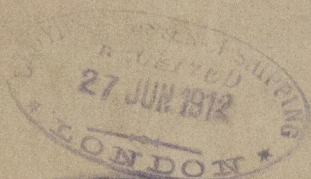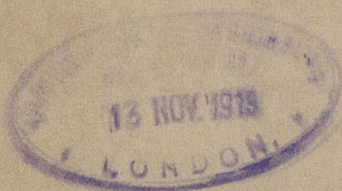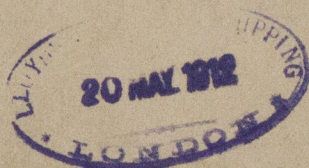

Lloyd's Register Foundation