


14.9.09  
21.10.09

TO CLASS 100 A


$$185_{\text{FT}} \times 29^1-6^{\text{H}} \times 13-3_{\text{MLD}}$$

- 8. 9. 09 -

RAISED QUARTER DECK 4FT. HIGH

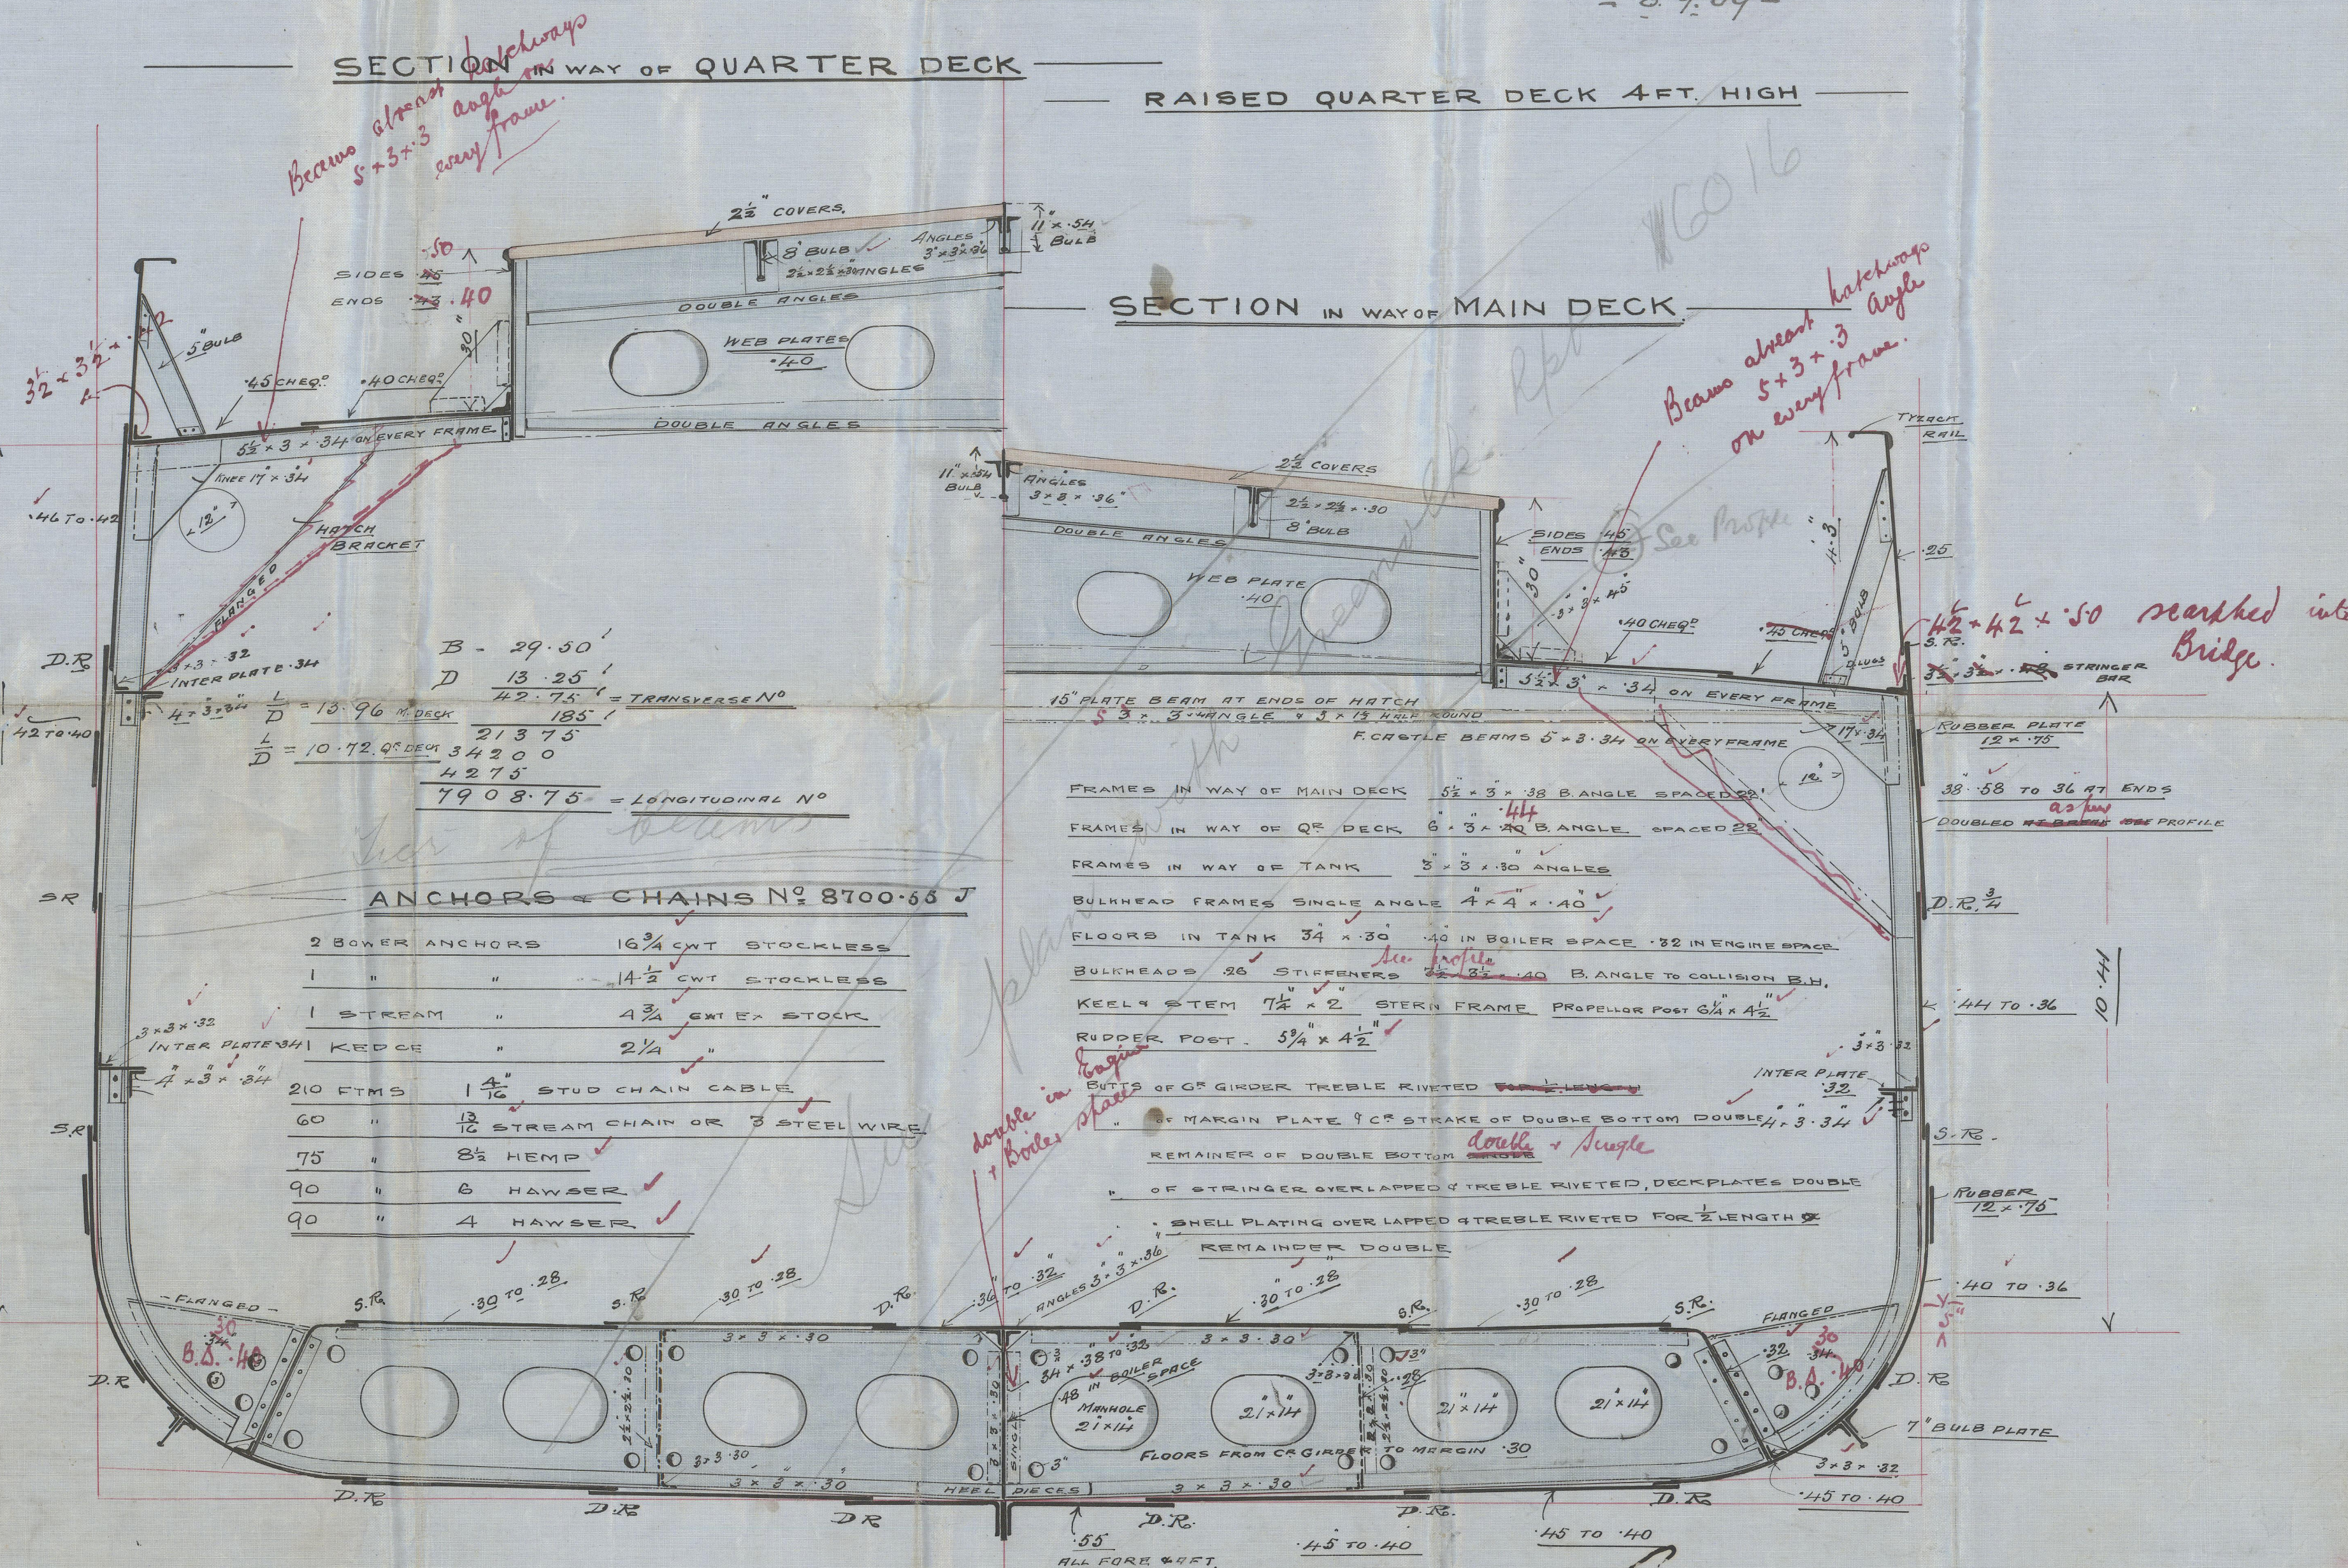

SCALE  $\frac{1}{2}$ " = ONE FOOT —

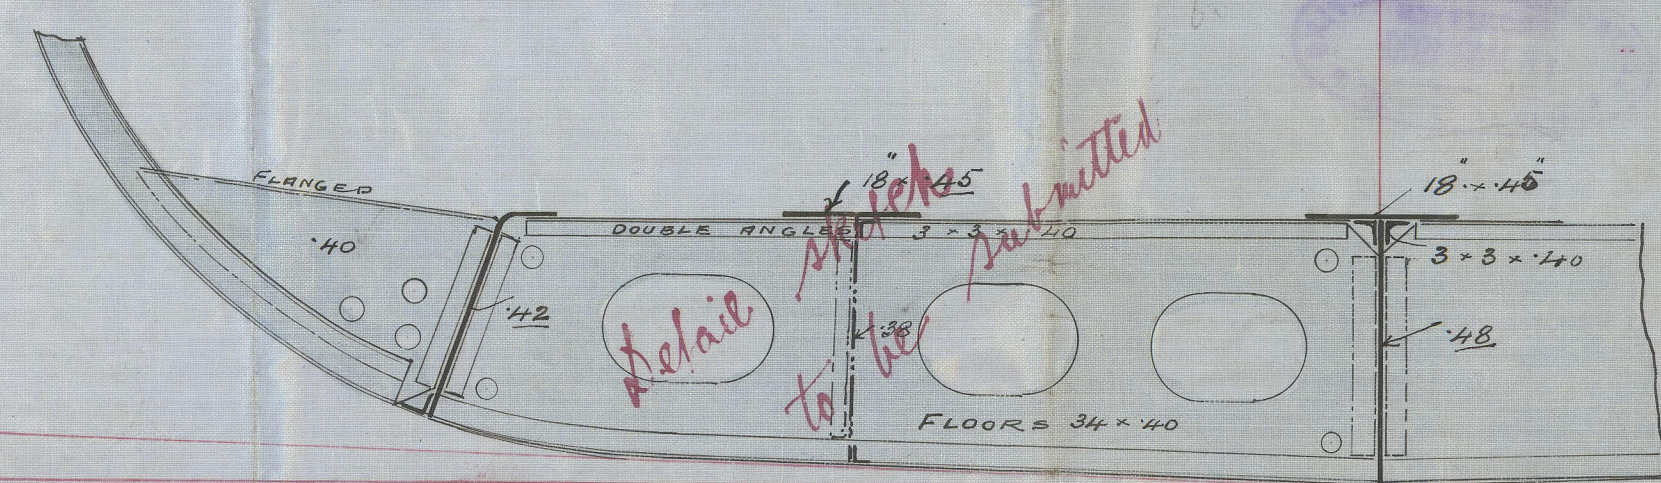

C.B.  
14.9.09.

-8. 9. 09-



W1038-0229

Scott's Sons


No. 219

Midship Section

"Amethyst"

GLASGOW REPORT No. 28637

now  
Pringle  
John

 

RETAIN



© 2020

Lloyd's Register  
Foundation