



S.S. "STAL"

POSITION OF NEW BULKHEADS

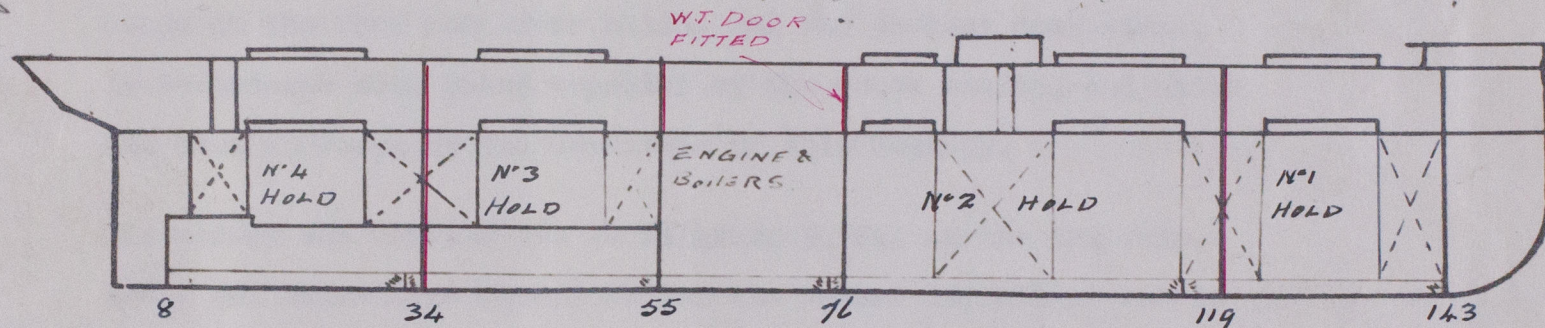

frames Nos. 34 and 119, and also in the shelter deck space on frames Nos. 55 and 76, the latter being extensions directly

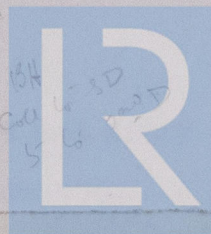

© 2020

Lloyd's Register
Foundation