

Counted from aft.

Longitudinal bulkheads S.B.
LANGSSCHOT. S.B.


TANK I

TANK II

TANK III

TANK IV

TANK V



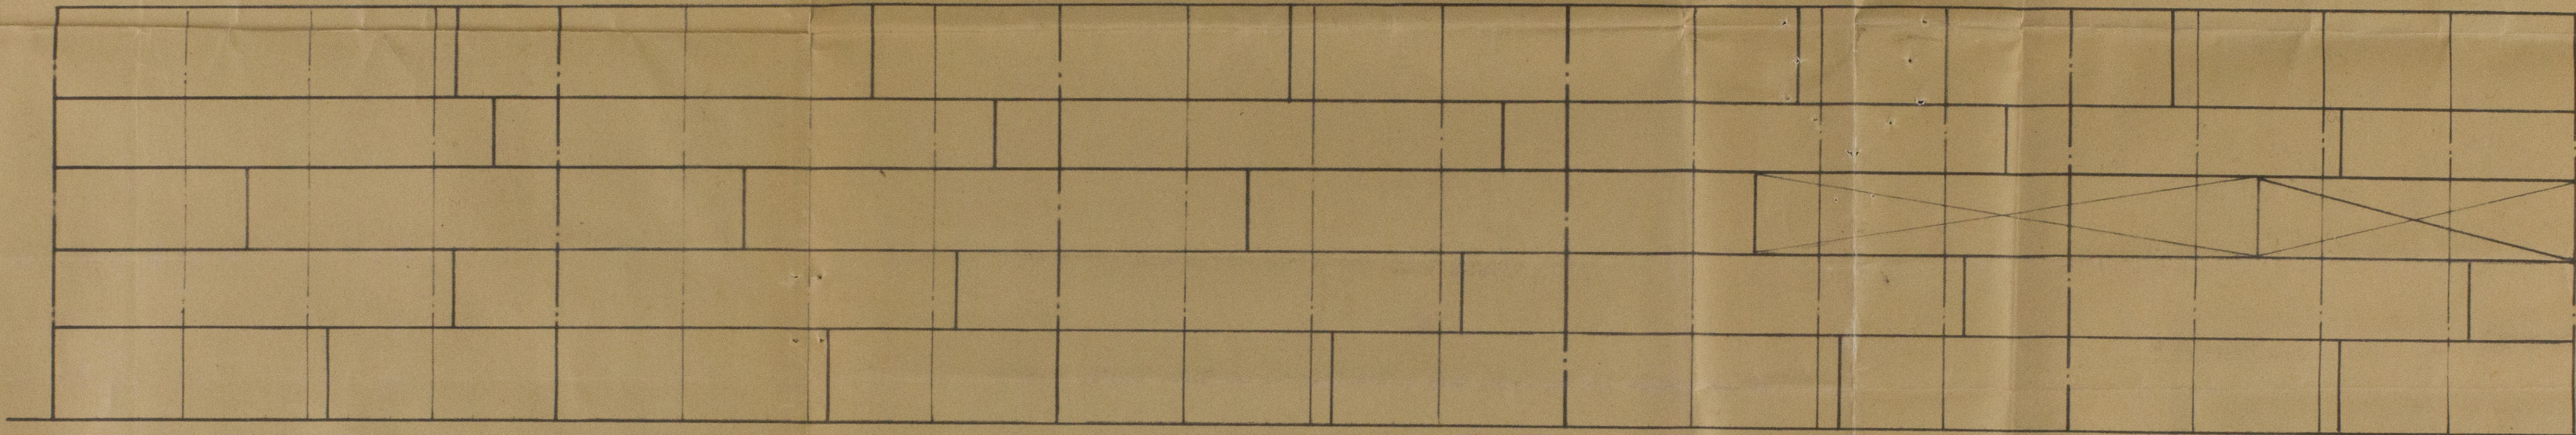


Transverse bulkheads in wing tanks
DWARSSCHOTJES IN WINGTANK

TUSSEN TANK I-II

TUSSEN TANK III-IV

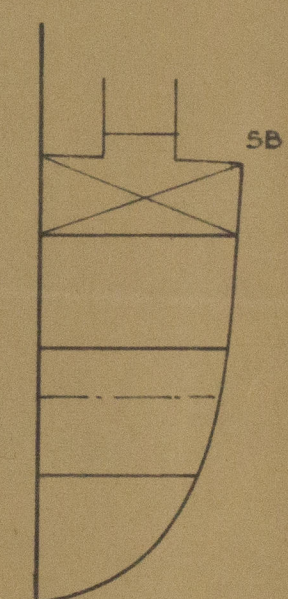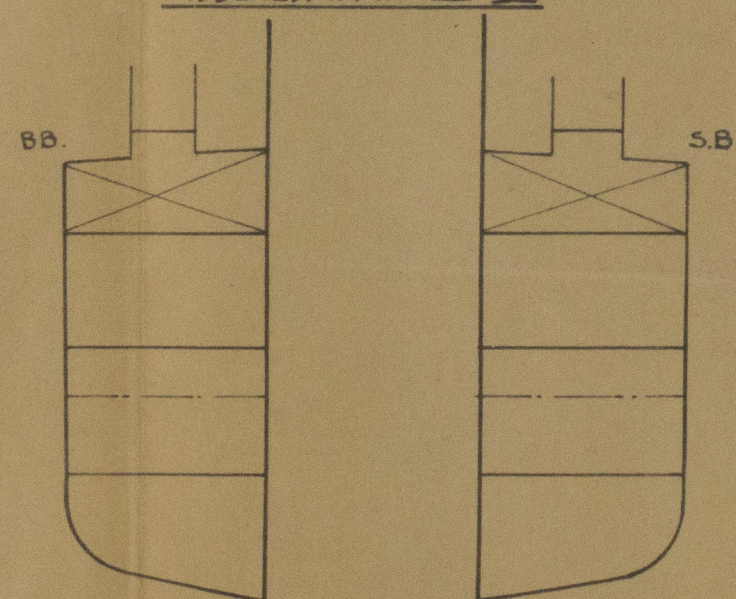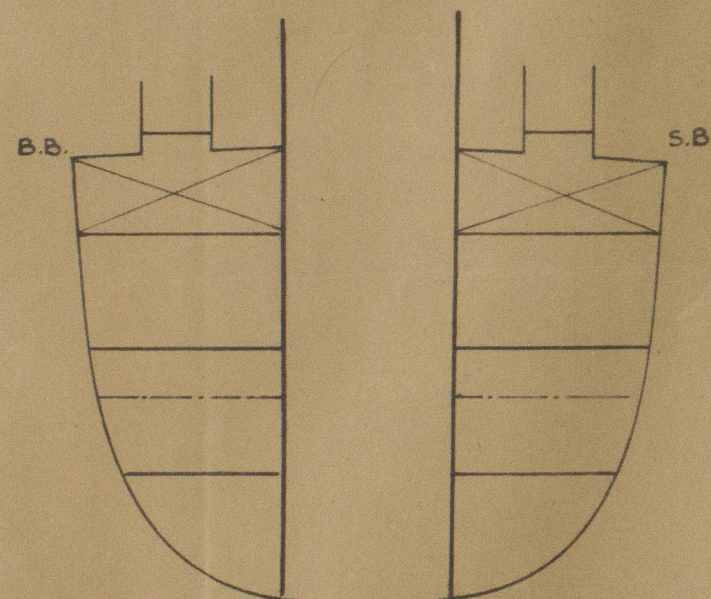

TUSSEN TANK IV-V



Longitudinal part
LANGSSCHOT B.B.
TANK V



H^o VROUWES

 *new plates*
VERNIEUWDE PLATEN
 *LAPPEN OPGEZET*
doublings.

N.V. DROOGDOK MII, SOERABAJA	
M.S. ANASTASIA	REPARATIE
	M.S. "ANASTASIA" 2020
ORDER	2/8-41
NO.	D.4348

Lloyd's Register
 Foundation

W1043-0064