


Office copy
NOT LEAVE HERE

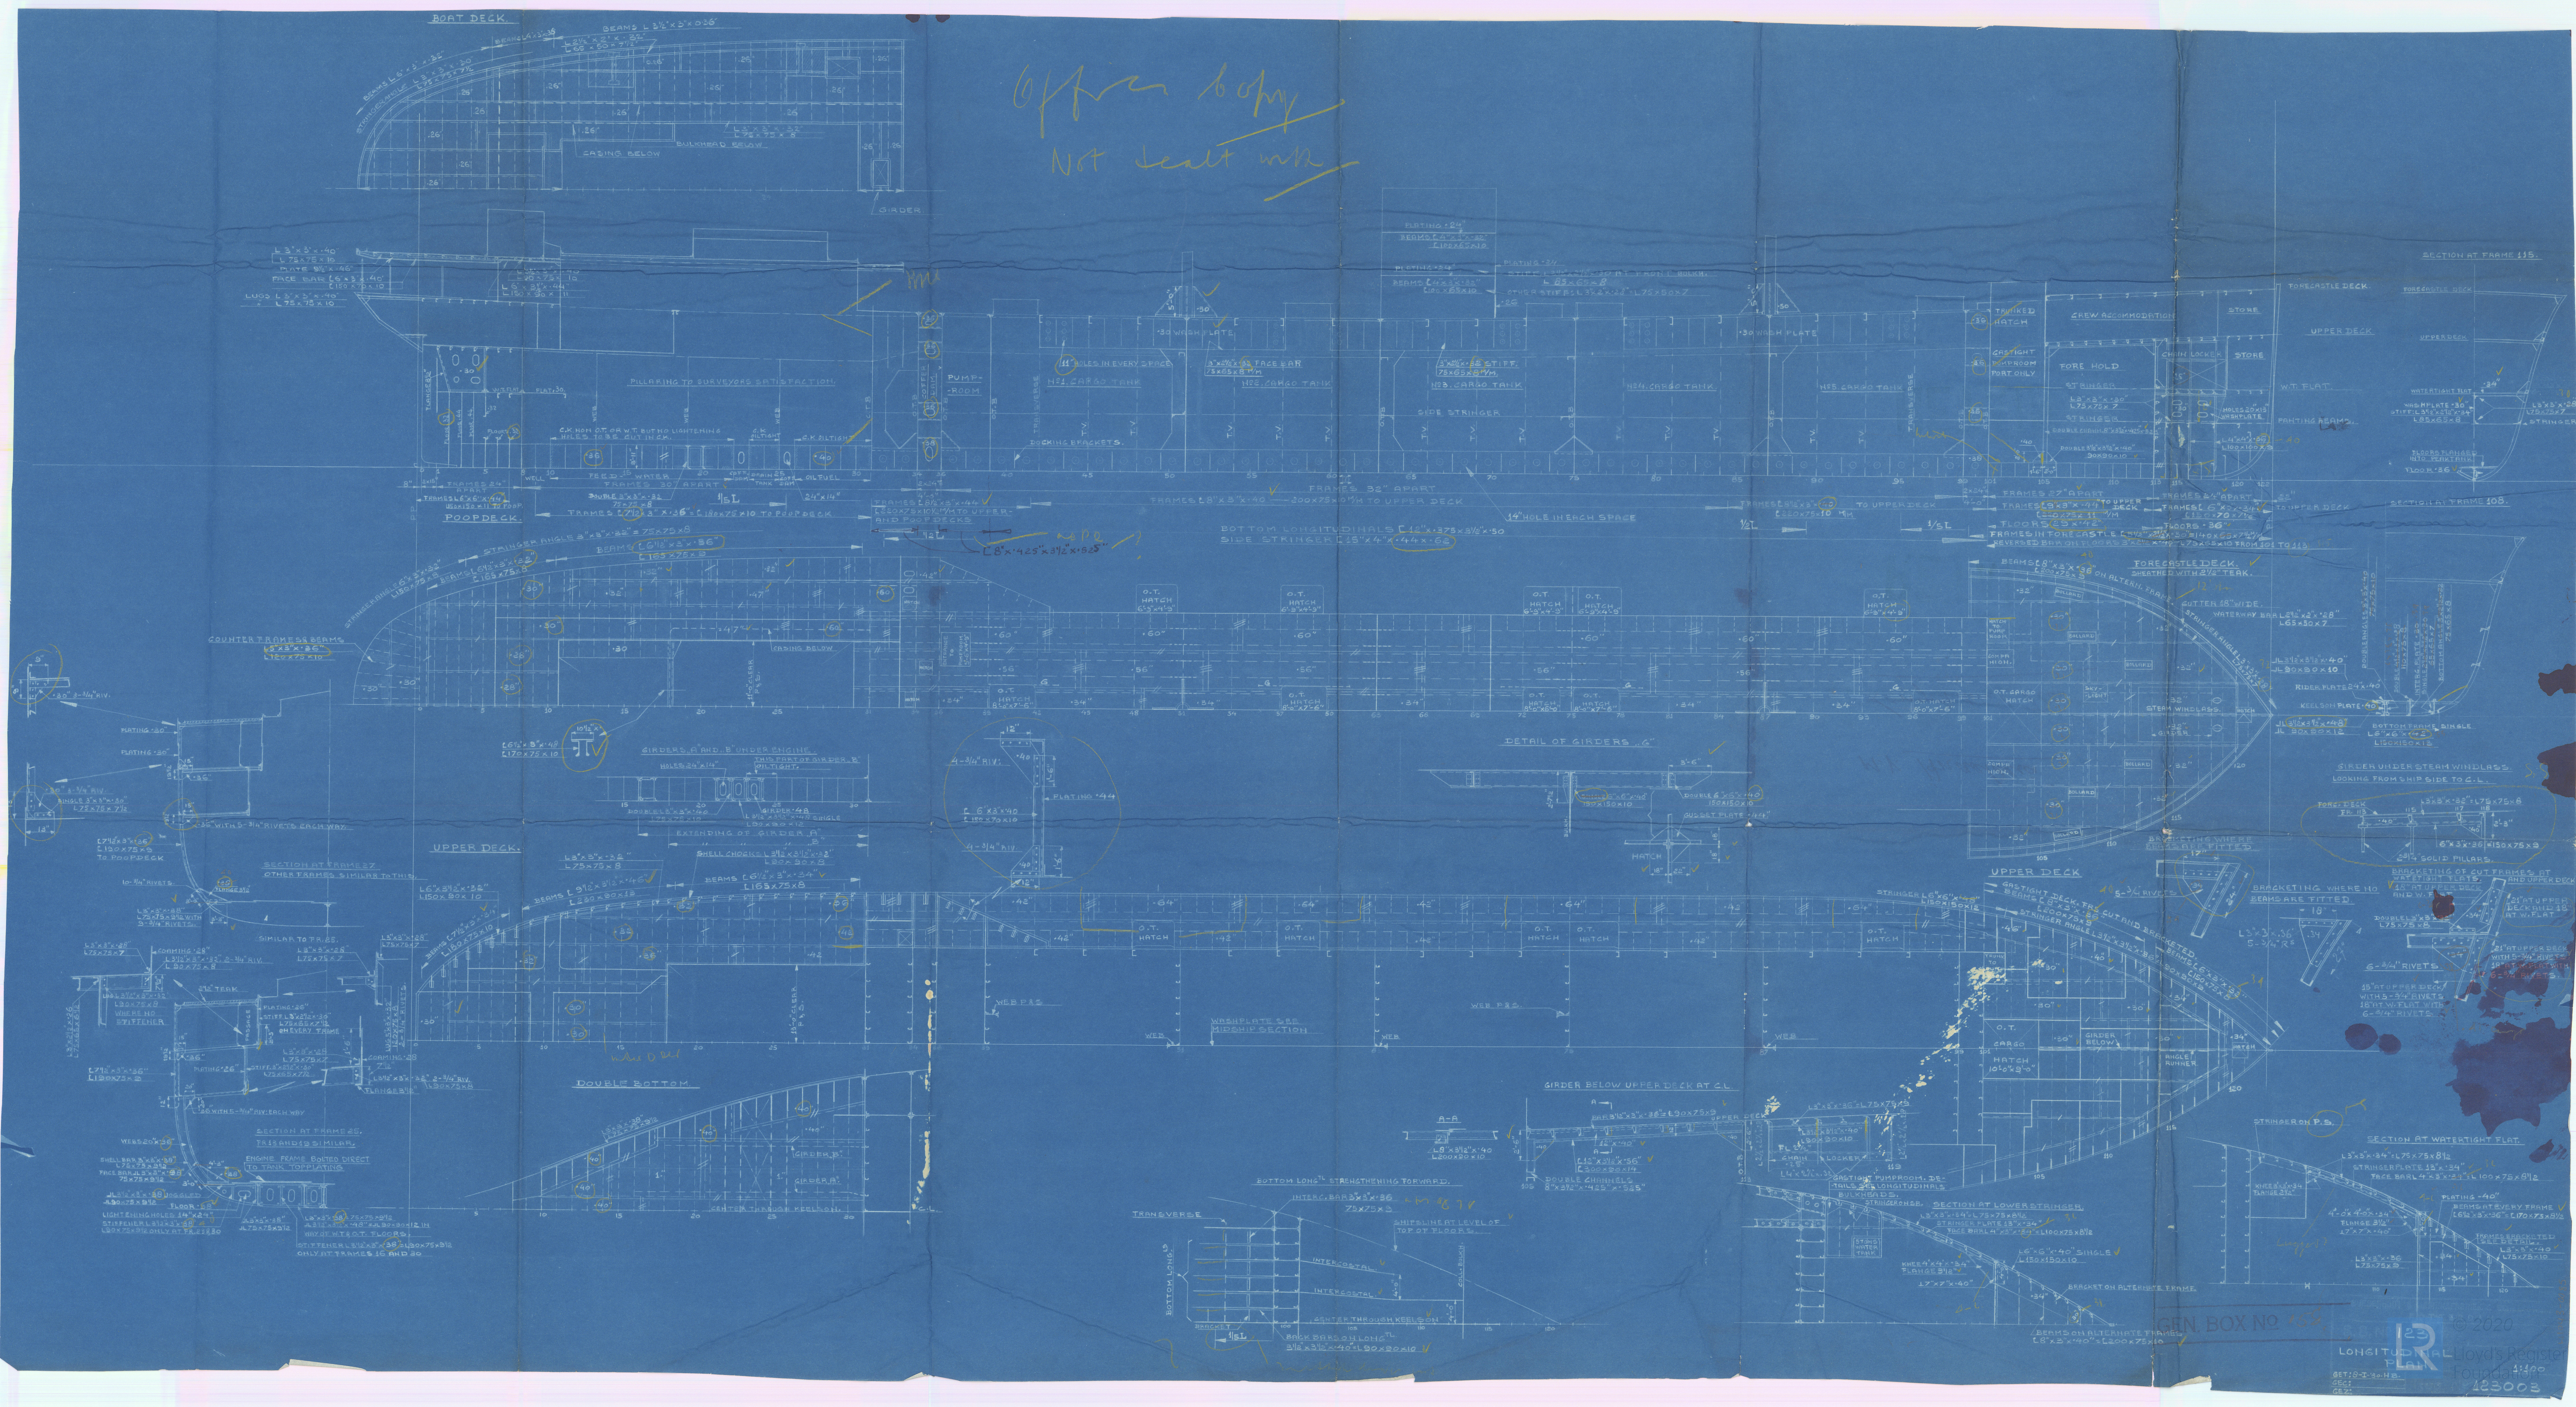

M.V. "Anastasia"

Longitudinal Plan

RETAIN

RETAIN



© 2020

W1043-0085

Lloyd's Register
Foundation