



NO 751 PROFILE & DECK PLAN SCALE 1/8" = 1 FOOT.

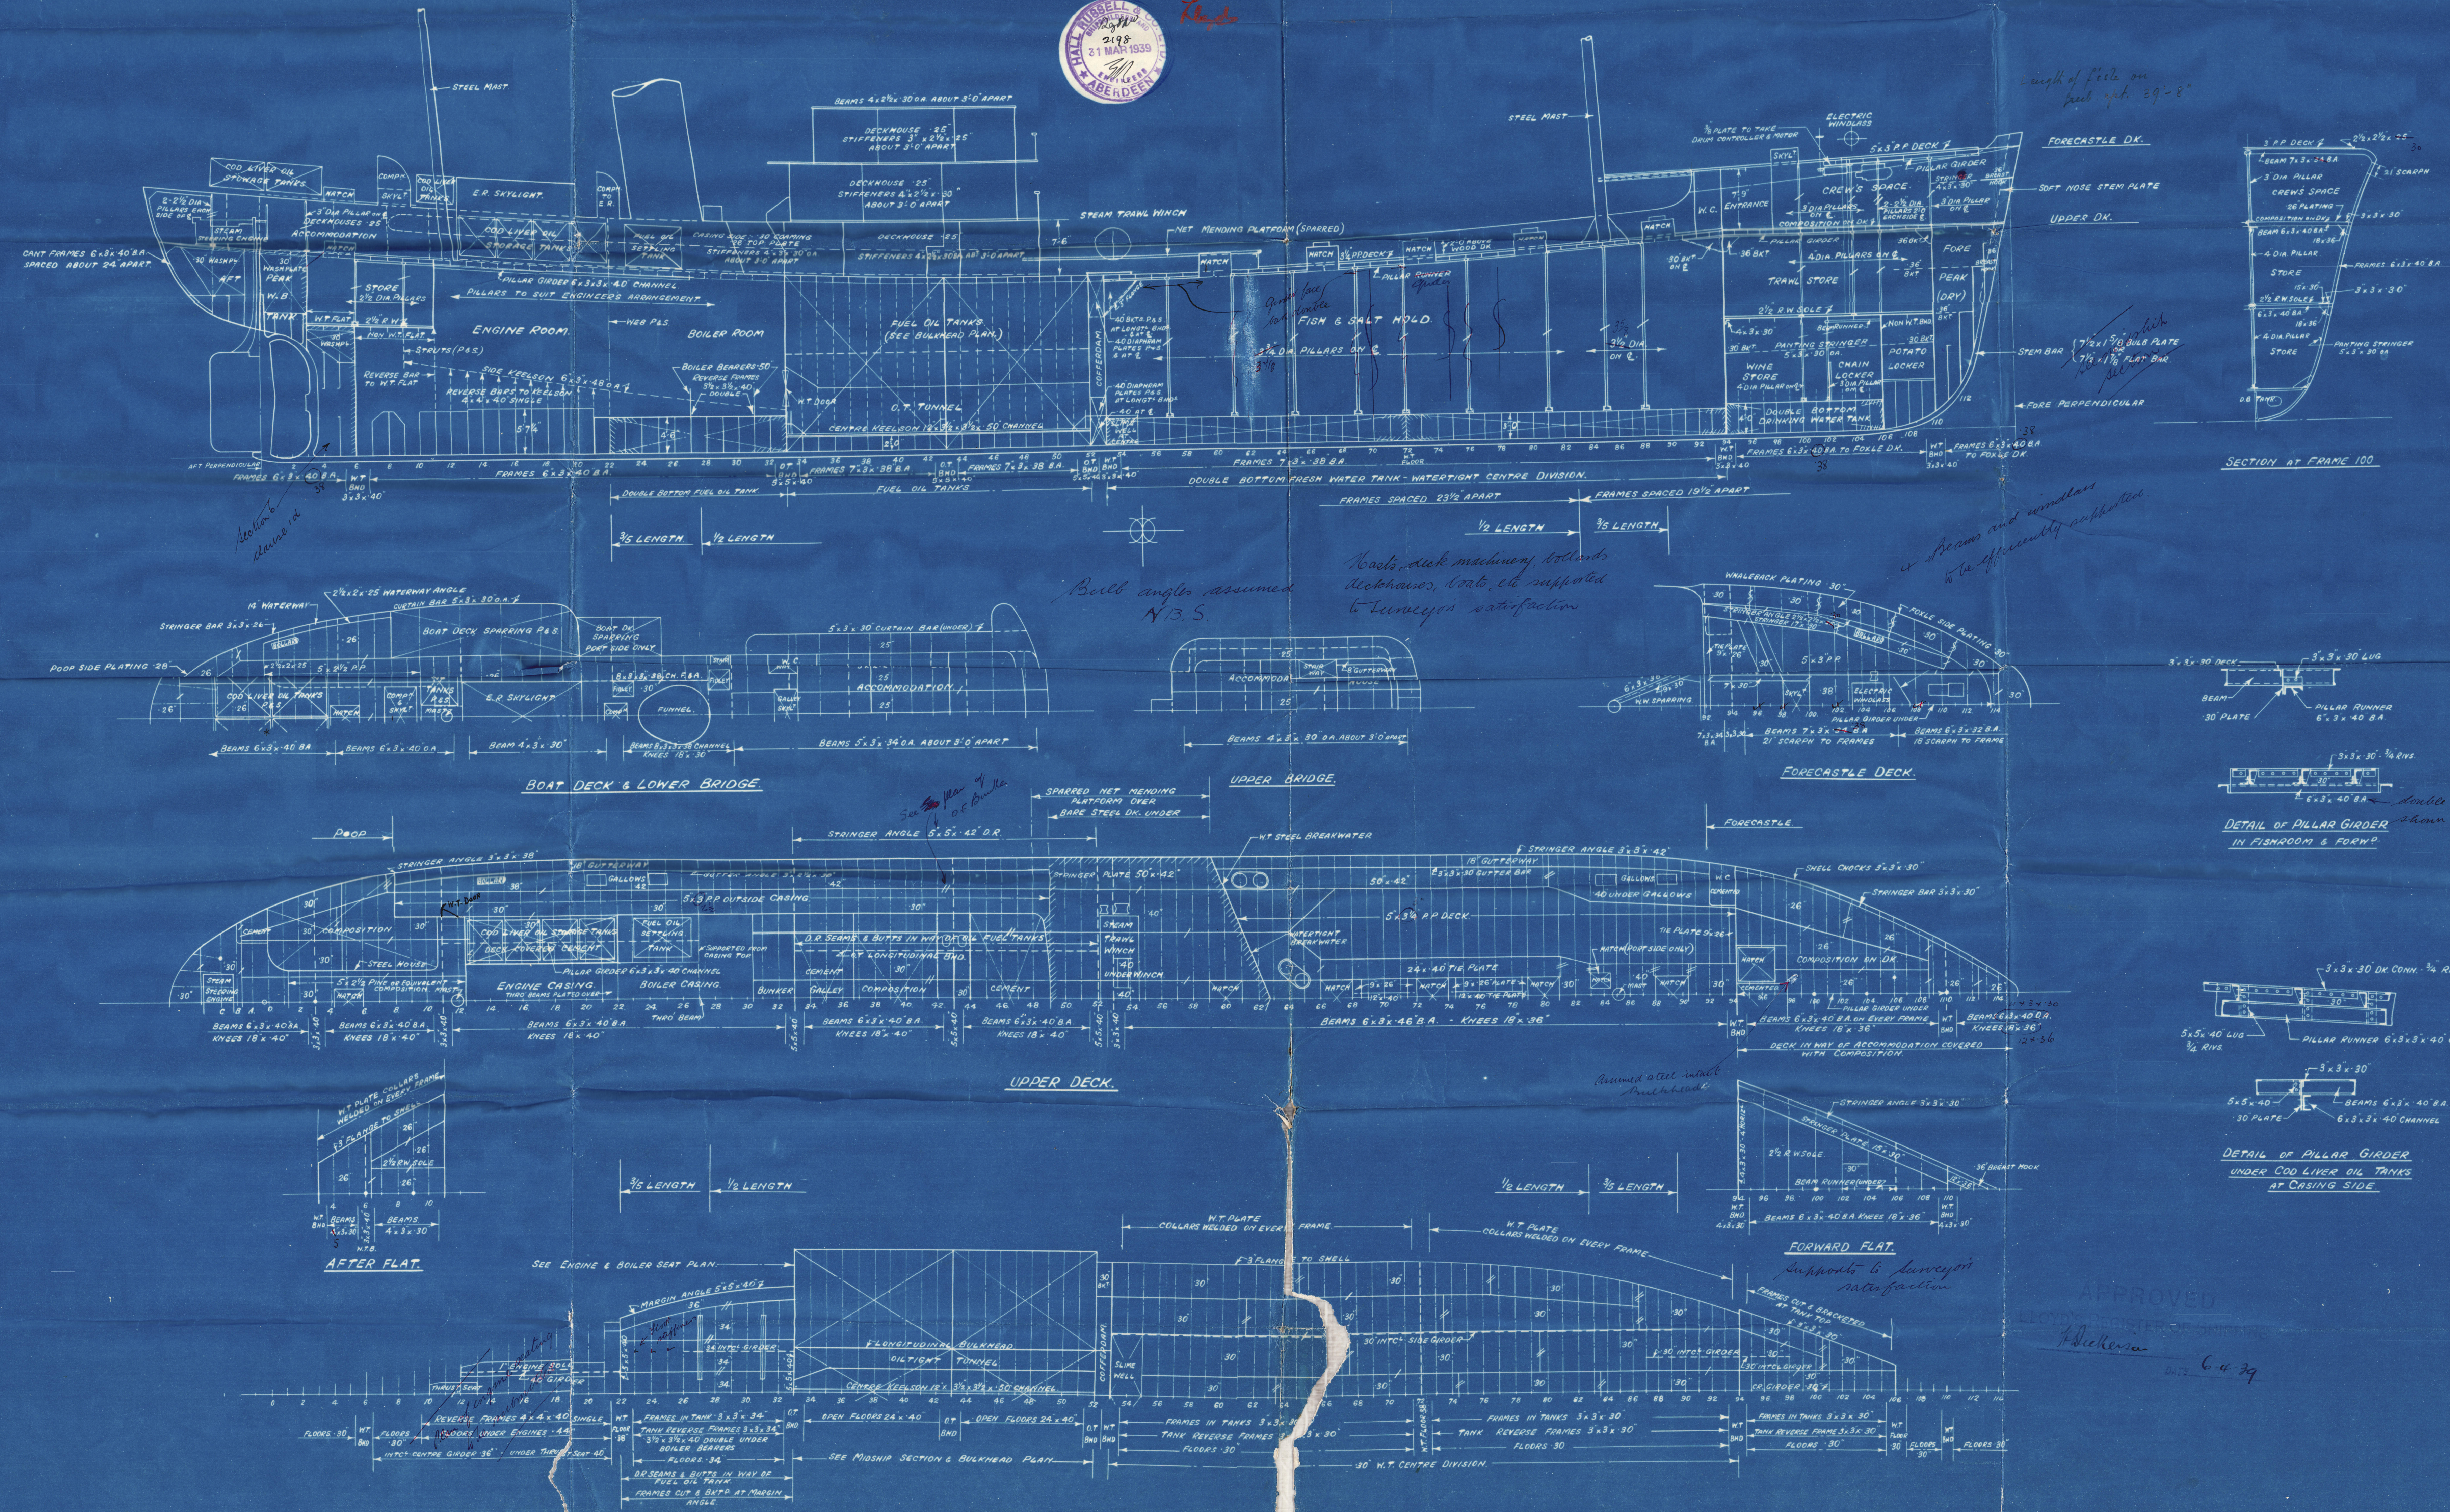




Length of feet on
 feet 39'-8"

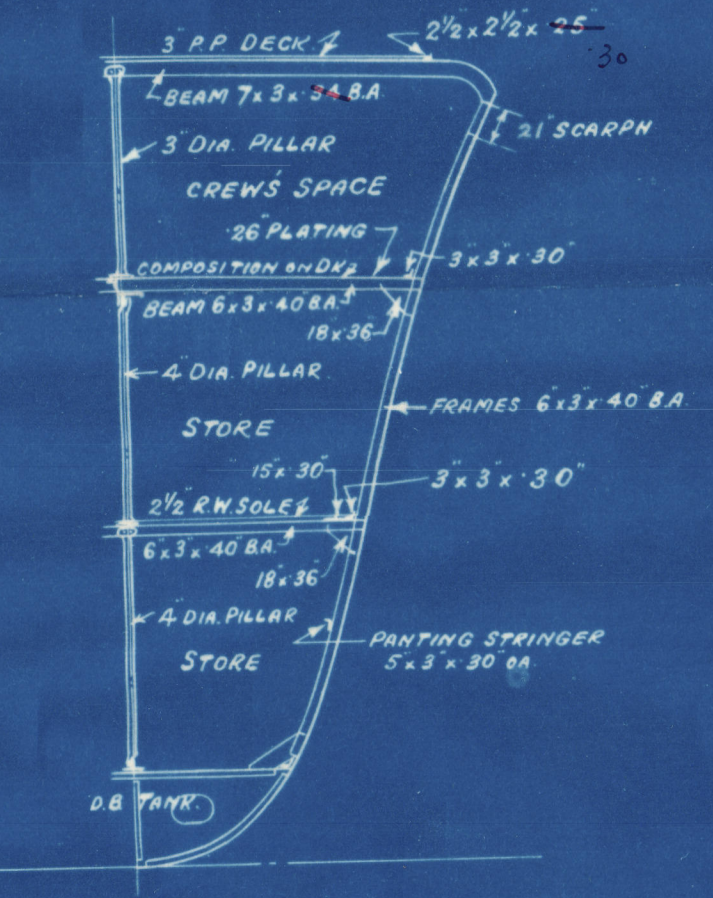

Built angles assumed
 N.B.S.

Boats, deck machinery, bollards
 dockways, boats, etc. supported
 to Surveyor's satisfaction

Beams and ironwork
 to be sufficiently supported.

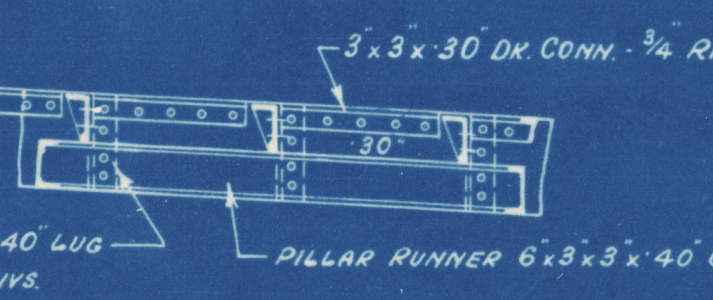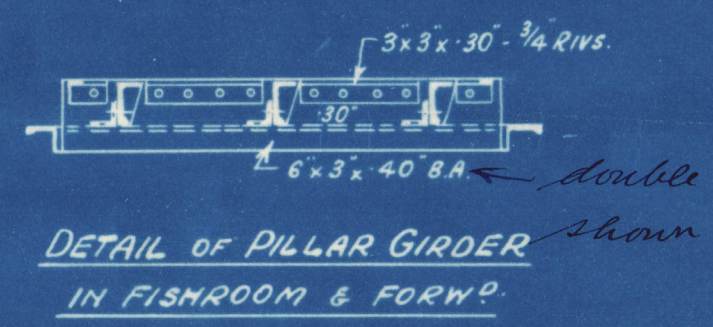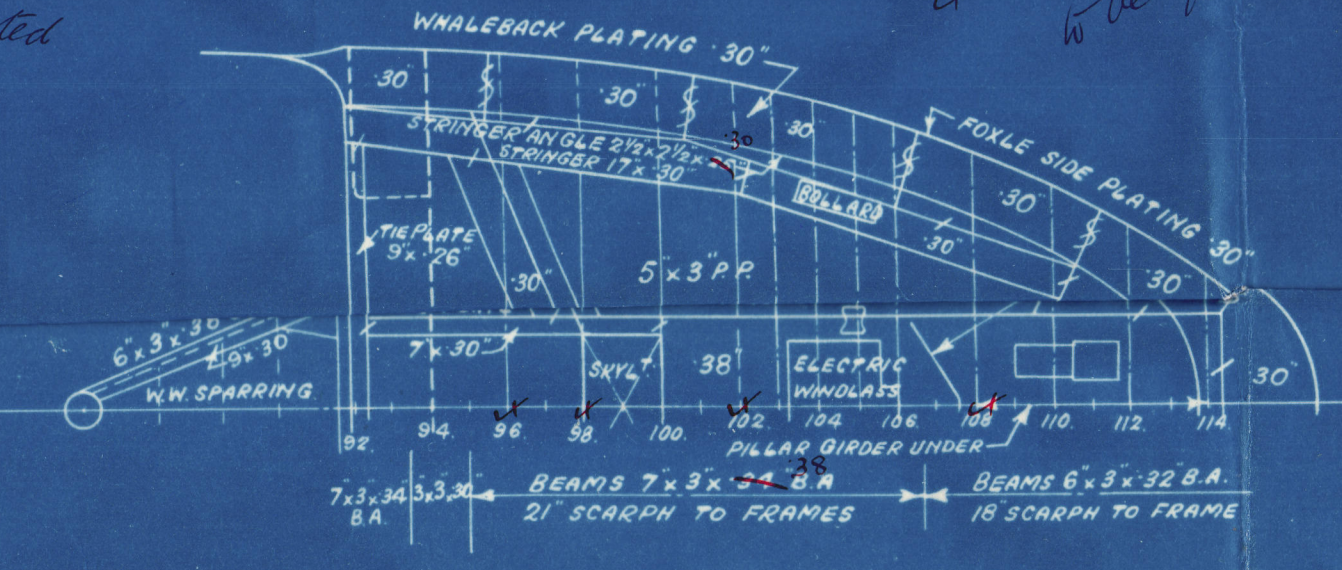

$$\frac{9}{4} + \frac{3}{8} + 2\frac{1}{2}$$

© 2020

Lloyd's Register
Foundation

Nº. 751.

Hall Russell & Co. Ltd.

Profile & Deck Plan.

S.S. "BOIS ROSE".

abn. Report 20231

RELEASE



© 2020

Lloyd's Register
Foundation

W1044-0018