

REGISTER OF SHIPS
8.2.12

112 19 57 + 2 Dead
121 31
Submarine
as per plan of 1st part
"Heron" 30mm 30"
27/1/12
VICTORIA

"Channel Queen"


N°151

ELEVATION

DIMS: 175-0" x 28-0" x 13-5" MLD:

SCALE 1/8" = 1 FOOT.

SECTION IN WAY OF STRINGER
FRAMES 70 to 85.

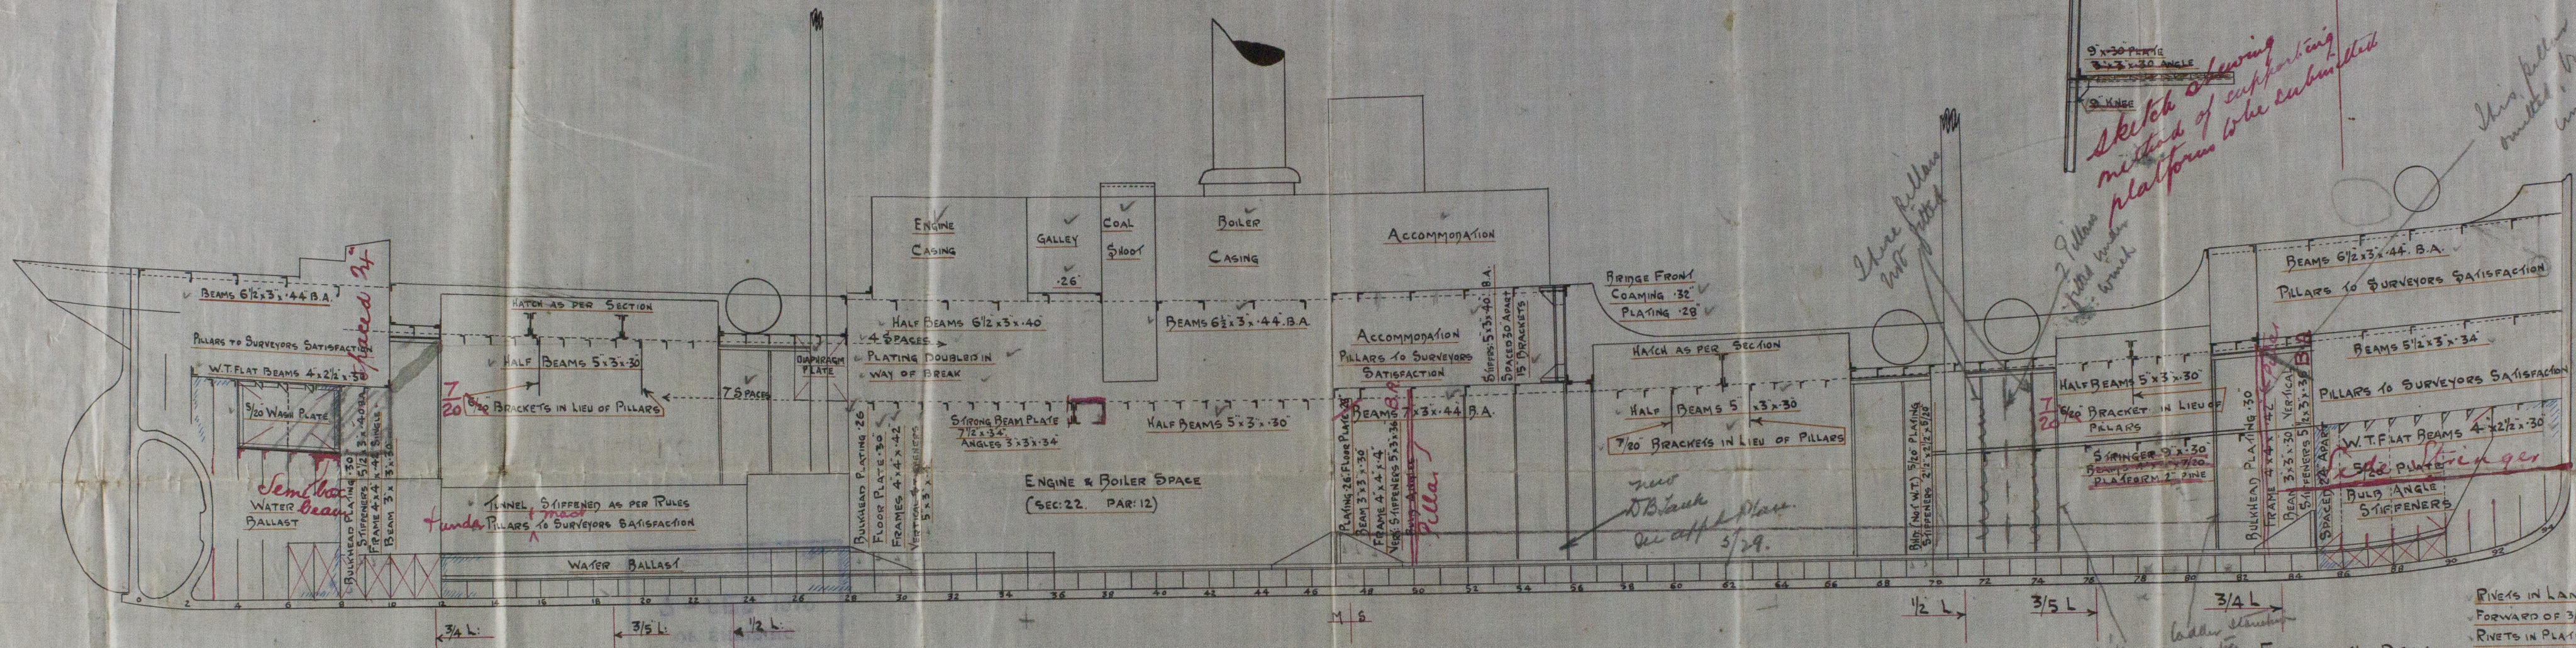

Sketch showing
method of supporting
platform where submitted

This pillar
omitted - bracket fitted
under beams.

Here pillar
not fitted

new
break
on aft plate
5/29.

RIVETS IN LANDING EDGES FORMING FLAT
FORWARD OF 3/5 L: SPACED 4 DIAS:
RIVETS IN PLATING + FRAMES 5 1/2 DIAS: FRAMES
DOUBLED FORWARD OF 3/5 L: BOTTOM STRENGTH:
FINED AS PER RULES. RIVETS THRU FRAMES
+ SHELL IN PEAK-TANK SPACED 5 1/2 DIAS:
CENTRE TO CENTRE

POOP DECK

POOP STRINGER 16 x 26
WOOD DECK 5 x 2 1/2 P.P.

BRIDGE DECK

STRINGER 34 x 38
WOOD DECK 5 x 2 1/2 P.P.

FORECASTLE DECK

TIE PLATE 7 x 28
WOOD DECK 5 x 2 1/2 P.P.

RAISED QUARTER DECK

MAIN DECK

alter here

C.B.
8.2.12

asw
7-2-12

Escoe S + R. Co. Ltd.

No. 151

Amended
Profile and Decks
"Channel Queen"

Hull Report No. 25524

N. 151
ELEVATION

Dim: 175-0 x 58-0

Scale 1/8" = 1'-0"

RETAILED

2220-4701W

LLOYD'S REGISTER
OF SHIPPING.
7-FEB. 1912
HULL



© 2020

Lloyd's Register
Foundation