

ONE MILD STEEL VERT. DONKEY BOILER OFF THUS TO PASS LLOYDS

Messrs The Gool Ship. Co. } For S/S No 151. Boiler No 303.
Gool

WORK. PRESS. 100 LBS. TEST PRESS. 200 LBS. PER SQ. IN.

SCALE 1" = 1 FOOT.

15/2/12


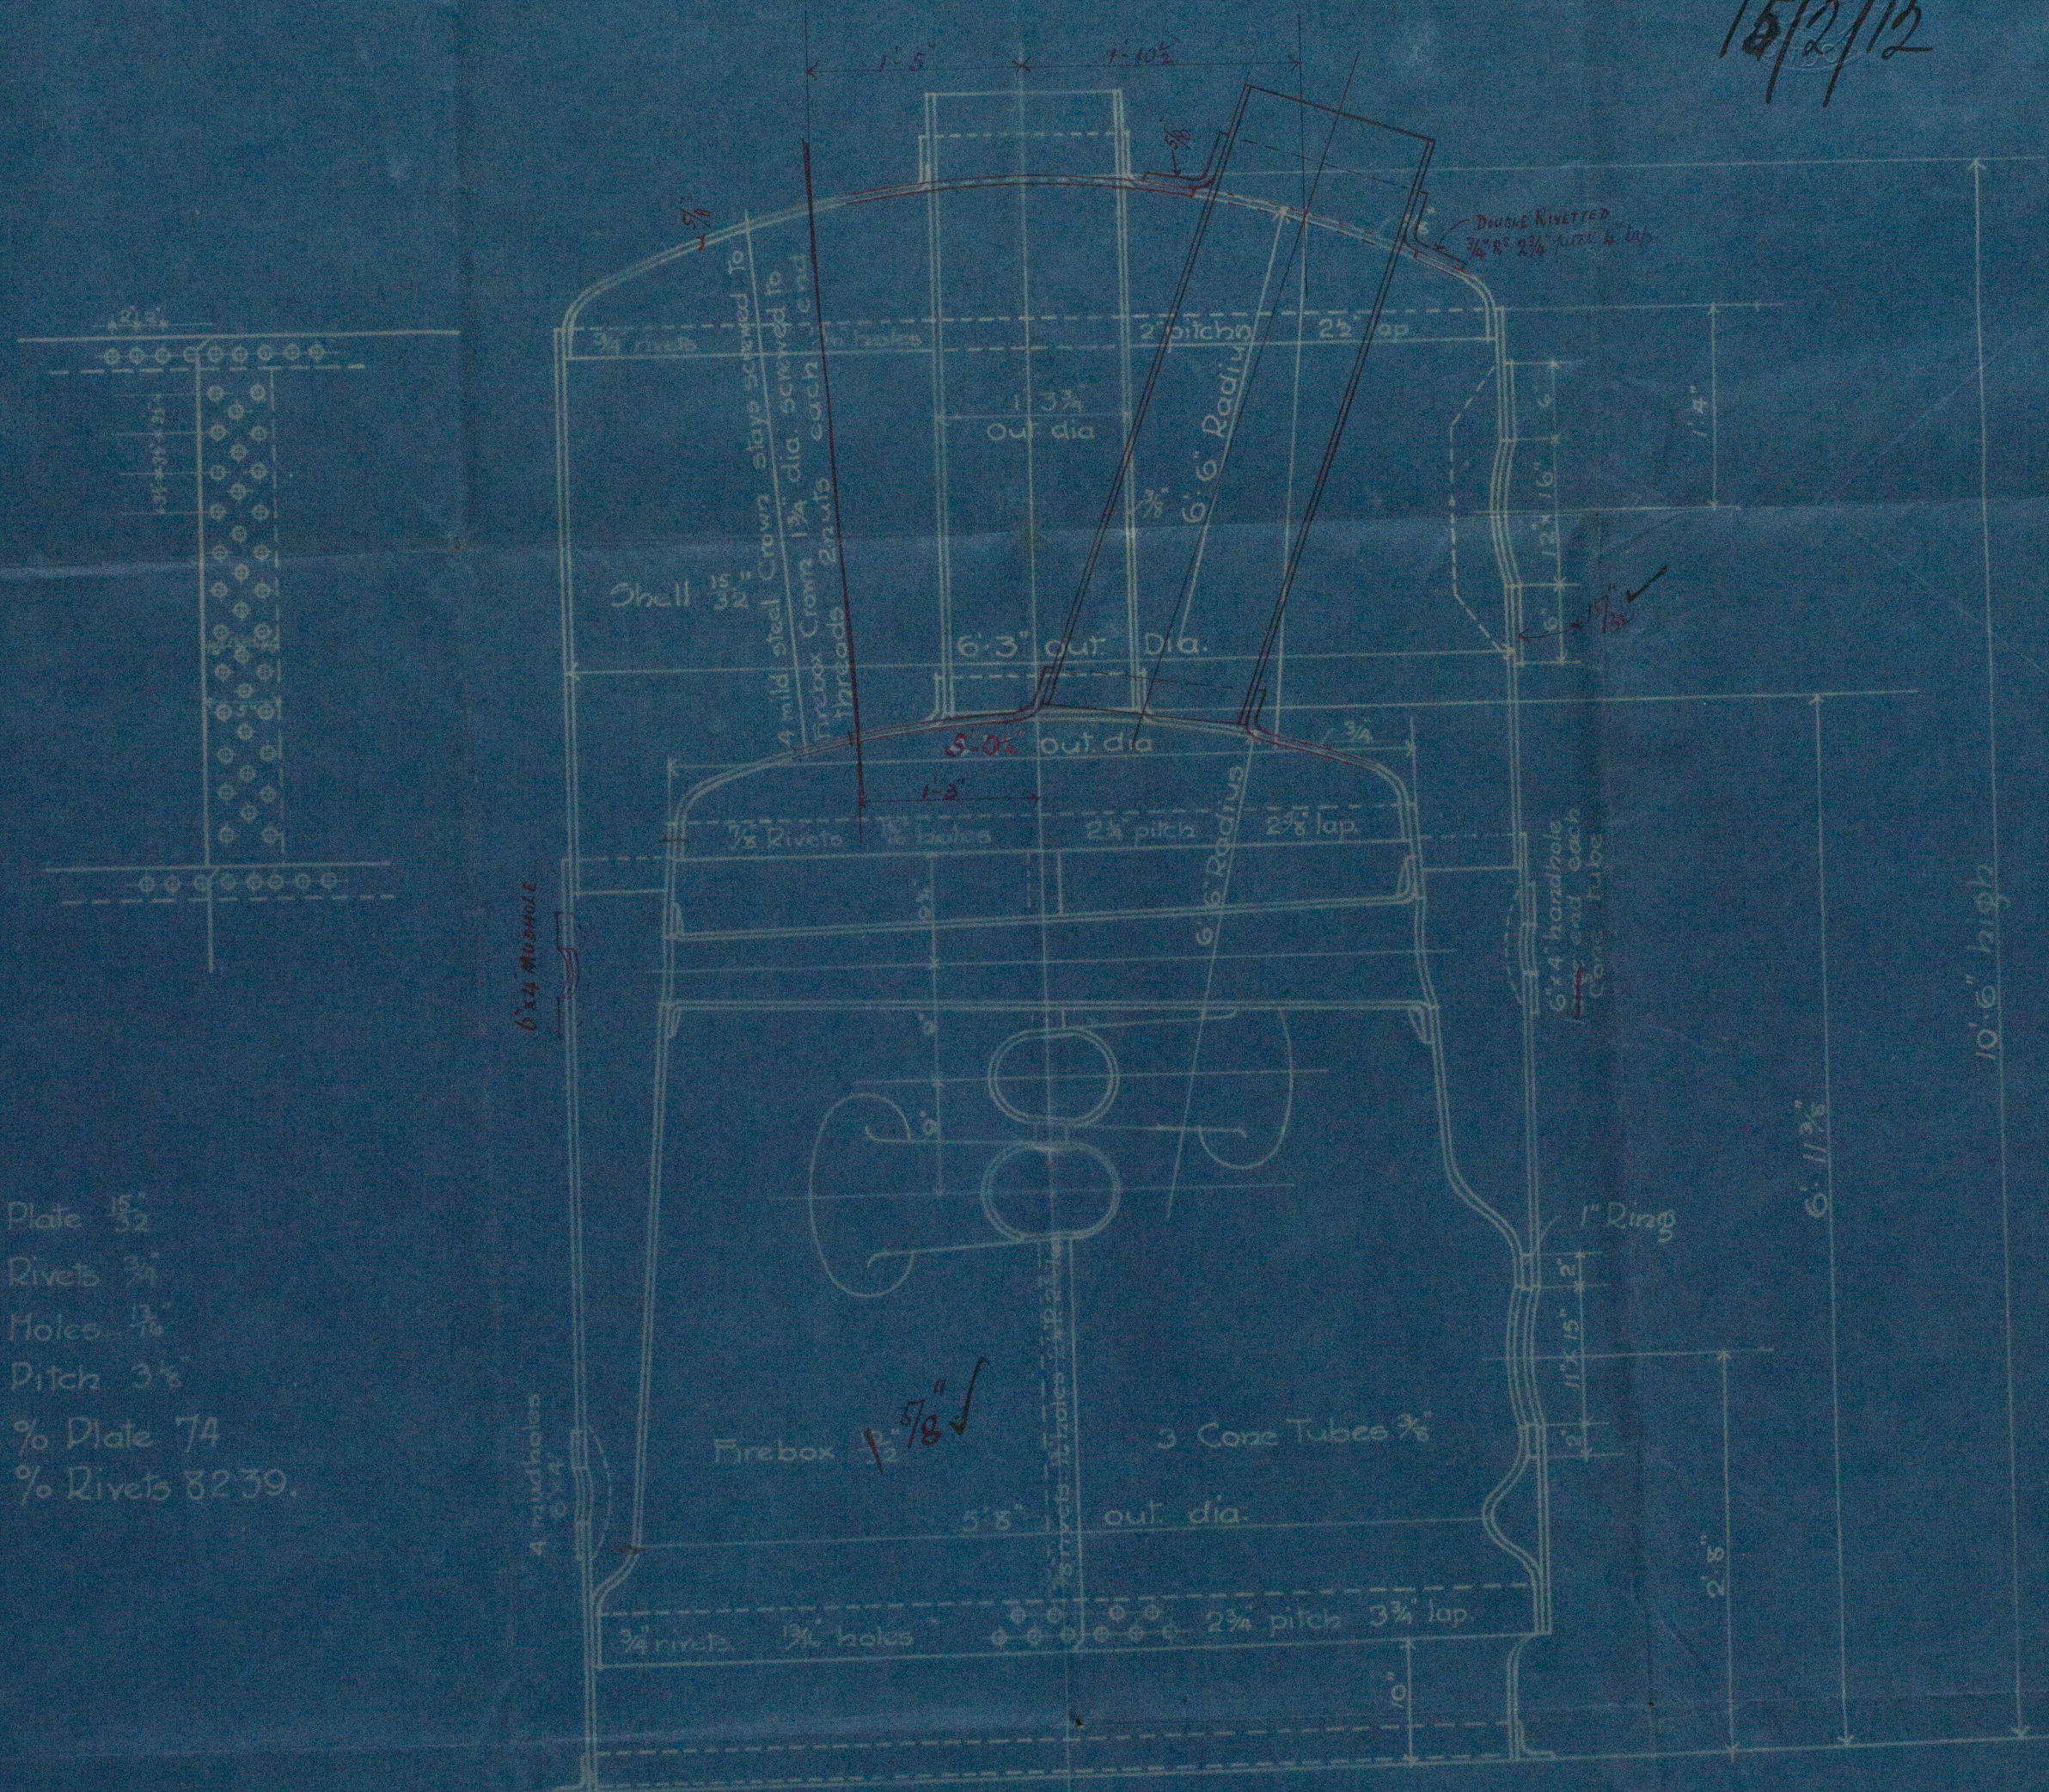


Plate 15/32
Rivets 3/4
Holes 1 1/2
Pitch 3 1/2
% Plate 74
% Rivets 8239.

Geo. Black & Sons
Engineering Works
10/2/12

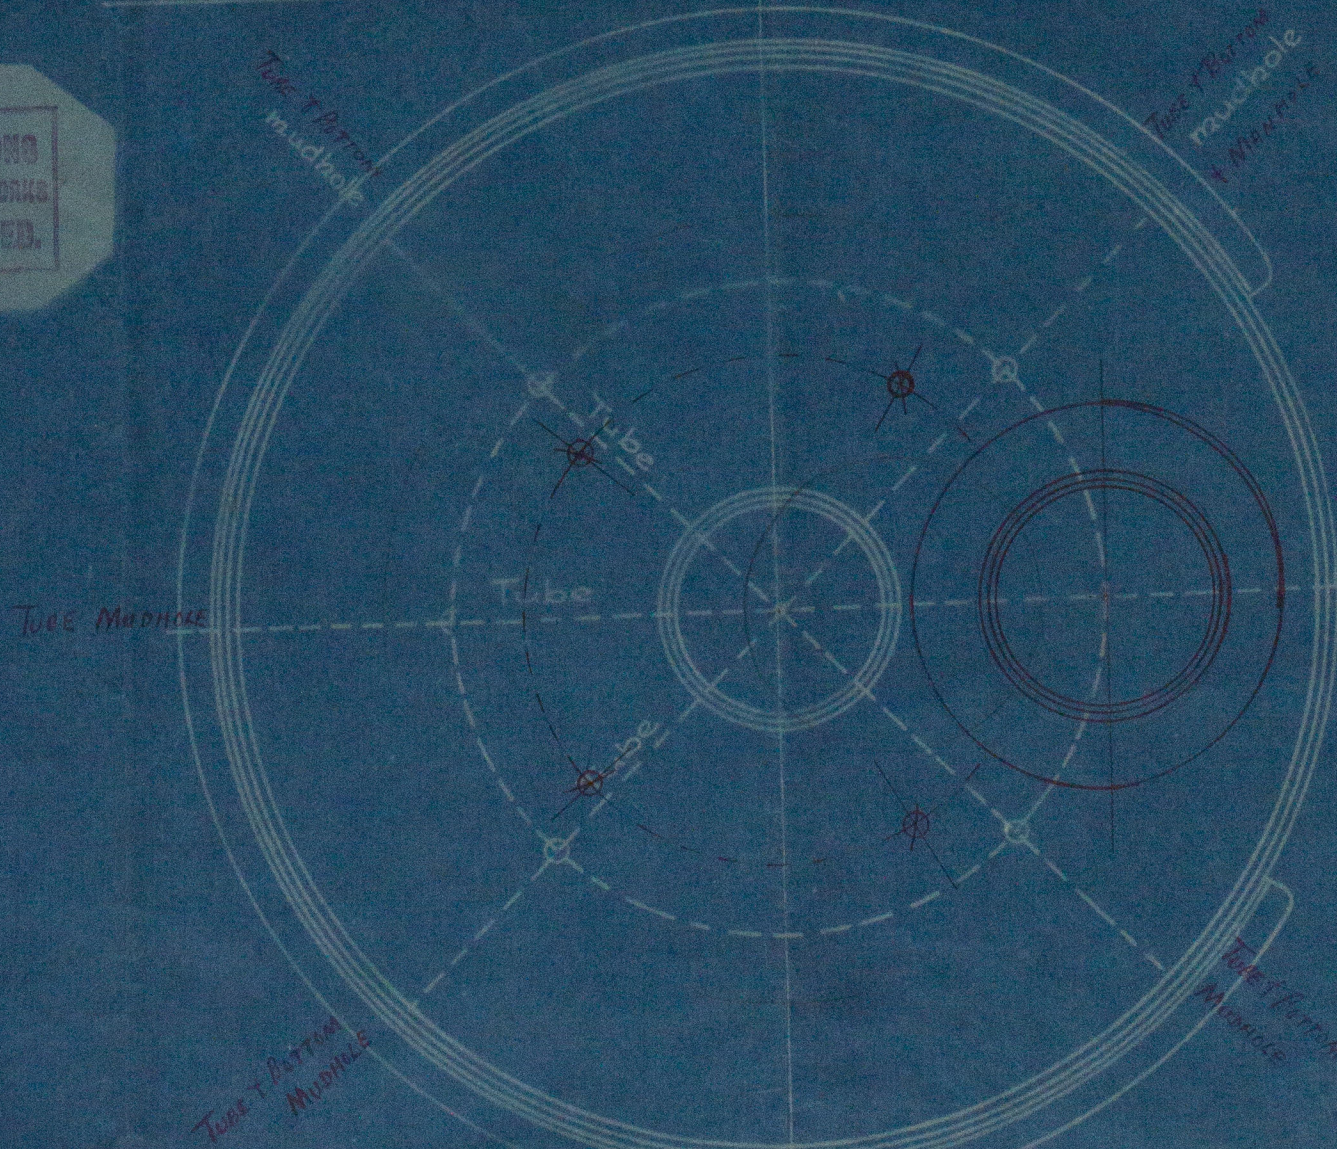

mudhole, mudhole, & firedoor
and ashpit opening.

15/2/12

LR

W1044-0223


Black's 303

Mr. B. L.

Mr

York S/B Co S/S 157

No 693
Lloyds List
2000
G.A.H. 1/8/12

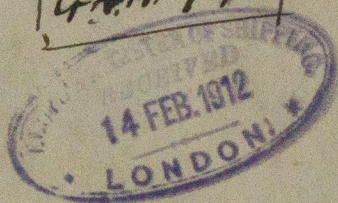

LR

© 2020

Lloyd's Register
Foundation

W1044-0223