

2231

Miss Lloyd's Trawler
Hull

Nov 13/12 RR

MIDSHIP SECTION

STEEL SCREW TRAWLERS


N^o 558-9-67-9-70

DIM^s LEN 133'-4" x 23'-0" E x 12'-9" DEPTH MOULDED

SCALE 1/2" = ONE FOOT

TO CLASS 100 A1 FOR FISHING PURPOSES. DECK PLATED OVER IN WAY OF MACHINERY SPACE. ENGINE & BOILER CASING AS PREVIOUSLY APPROVED

PLAN No. 2962
ENCLOSURE TO
Miss Lloyd's Trawler
Hull
FROM
GOSNELL & SONS LTD.
SHIPBUILDERS, SELEY.
DATE 10/6/13 *RR*

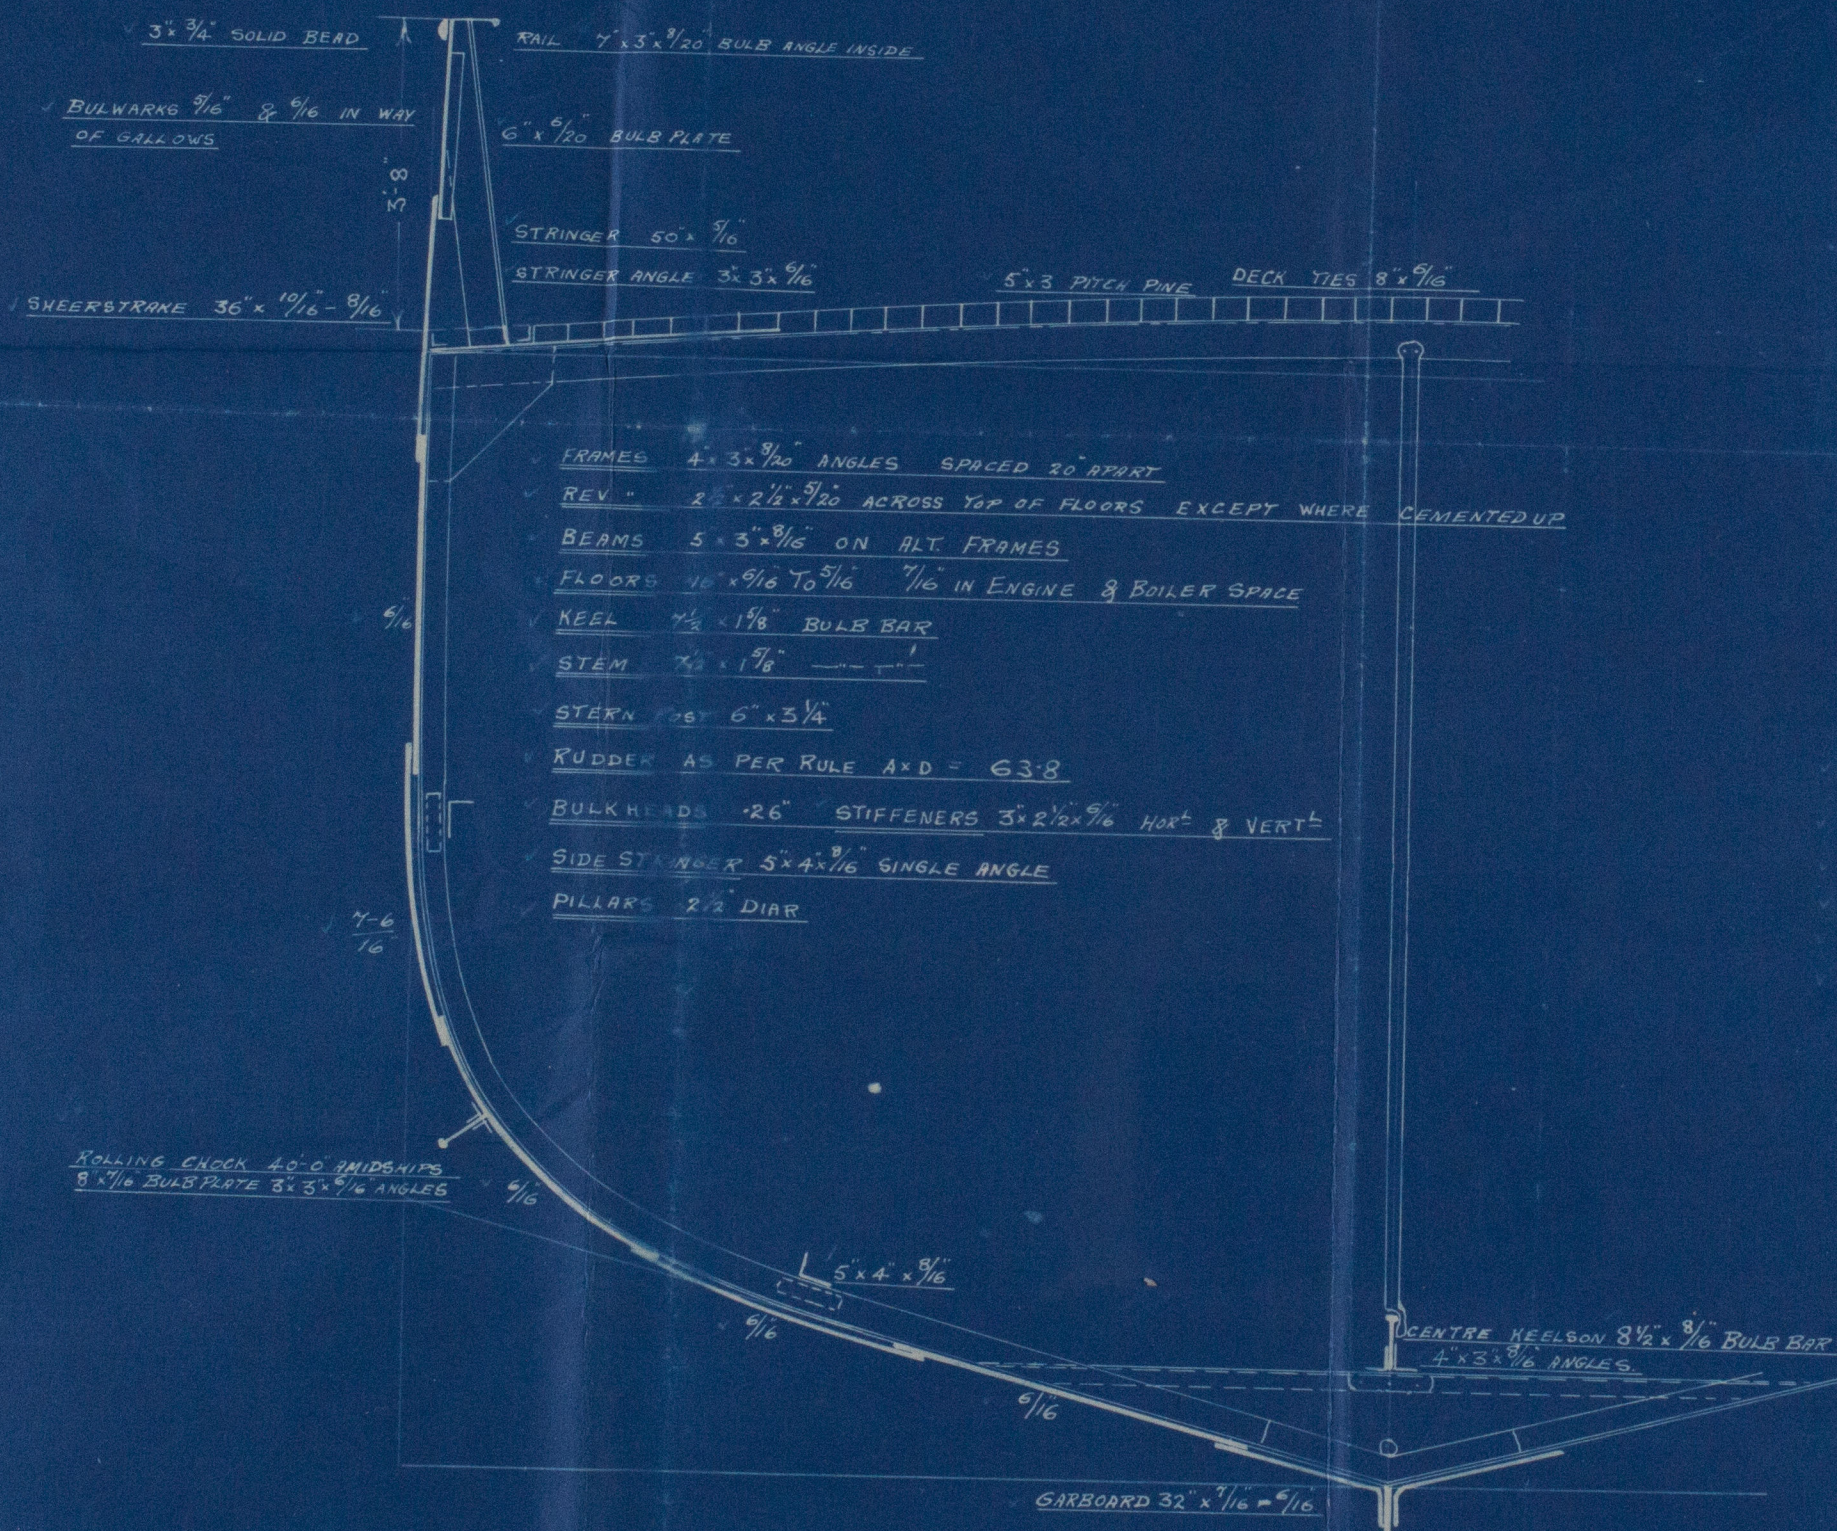

NUMERALS

B+D = 35.63
L x (B+D) = 4750.55

PROPORTIONS

L/D = 10.45
L/B = 5.85

EQUIPMENT

| | |
|------------------------------|----------------------|
| 1 ST BOWER ANCHOR | 5 3/4" CWTs EX STOCK |
| 2 ND — | 5 1/4" — |
| KEDGE | 3" — |
| 105 FATHOMS | 1 1/16" CABLE |
| 60 — | 6" HAWSER |
| 60 — | 5" WARP |

RIVETING

BUTTS OF SHELL PLATING LAPPED & DOUBLE RIVETED EXCEPT GARBOARD & SHEERSTRAKE WHICH ARE TO BE STRAPPED & DOUBLE RIVETED LANDINGS DOUBLE RIVETED BULWARKS SINGLE RIVETED





Cochrane & Sons
N^{os} ~~558~~, ~~559~~, 567, ~~569~~, ~~570~~.

Copy of
Midship Section

1/2 Scott Hull Report No. 26336


" " " " 26380

" Lord Lansdowne " 26457 to 567
" " " "

Delamore

RETAIN

© 2020

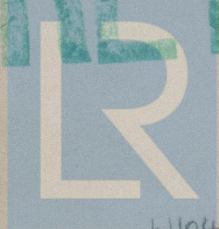

Lloyd's Register
Foundation

W1049-0149