


21 11 12

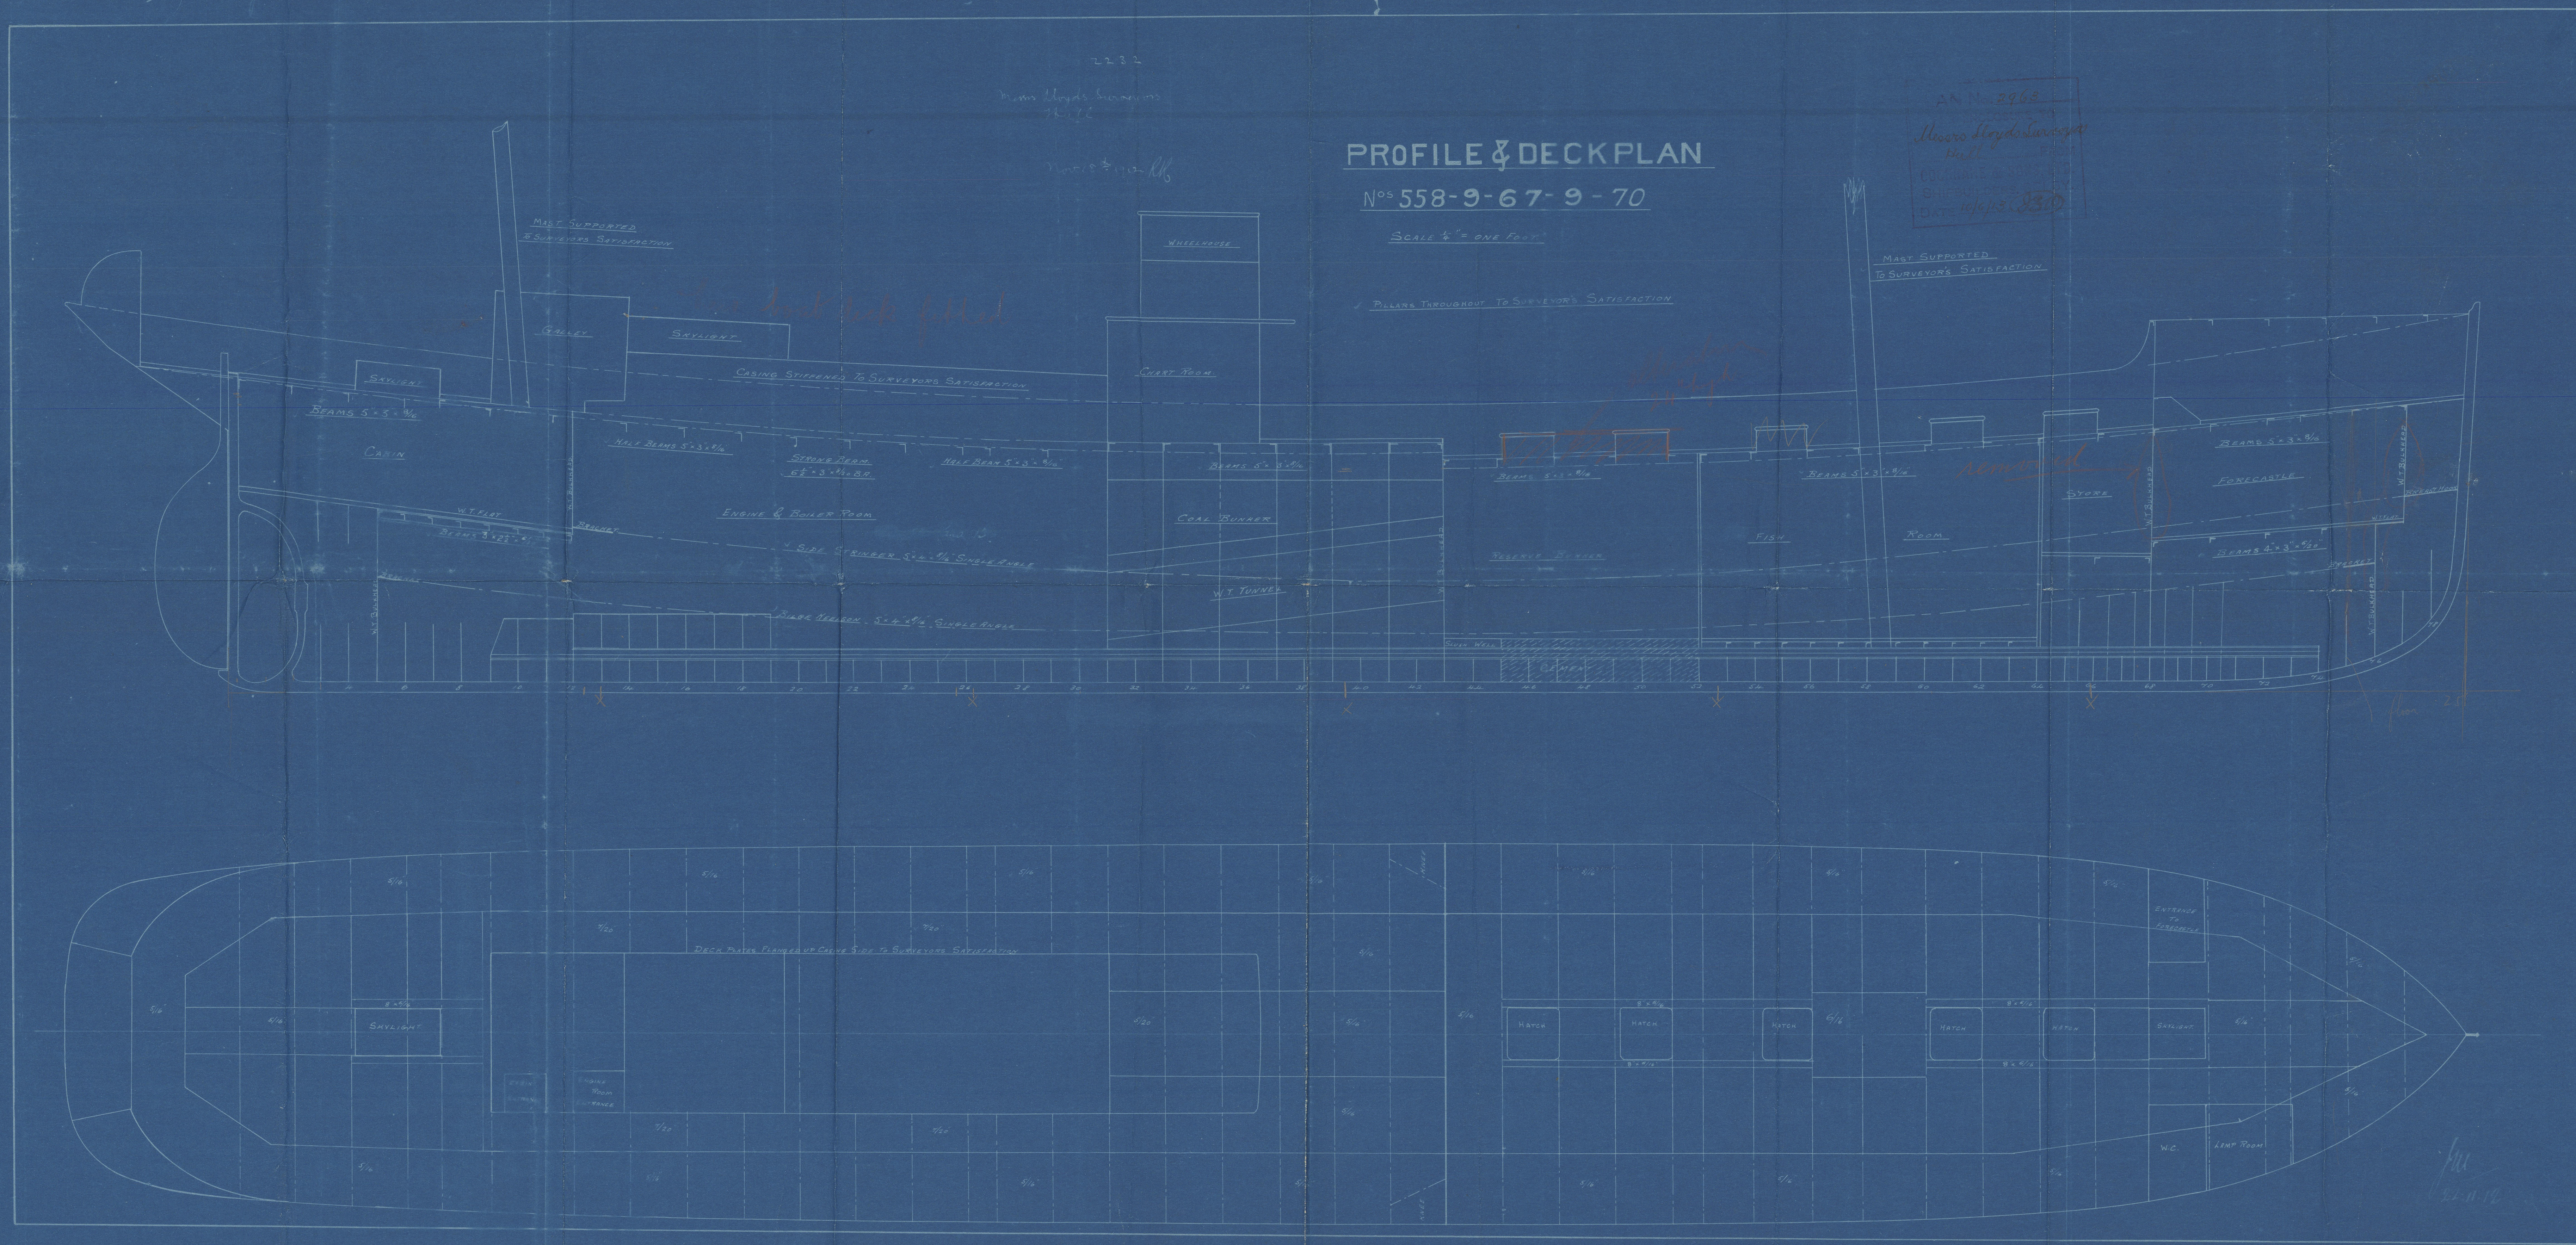

Cochran & Sons.

N^o ~~558~~, ~~559~~, 567, ~~569~~, ~~570~~.

Copy of

Profile & Deck Plan.

~~Scott~~ Hull Report No. 26336

~~Shackleton~~ " " 26380

" Lord Lansdowne N^o 567 " 26457

Delamora

REMAIN



© 2020

Lloyd's Register
Foundation

W1049-0150