

Lloyd's Register of British and Foreign Shipping.

(Report on Vessel No. 9566 Port Greenock)

No. 1594. SHIP FORGINGS OR CASTINGS.

I have to report that the undermentioned Iron or ~~Steel~~ Forgings or Castings, manufactured by The Irvine Forge Co. of Irvine. for the Vessel No. 188, being built by Messrs. Russell & Co. of Port Glasgow. have been inspected by me as set forth below, and found to be, so far as can be seen, sound and efficient.

Mark on Forgings.

Lloyd's
No. 1594
G.N.


George Newcomb.

Glasgow

4/4/88.

	STERN FRAME.	RUDDER FRAME.	STEM.
Material*	/	Scrap iron.	/
made		Forged.	
Dimensions		5 1/2 dia	
Progress on Inspection		Forging & smithing	
times when Inspected		27/3/88, 5.9/4/88, 14.25/5/88 27.29/6/88.	

SKETCHES OF FRAMES SHEWING POSITION AND DESCRIPTION OF WELDS OF FORGINGS, OR PARTICULARS OF TESTS APPLIED TO CASTINGS.

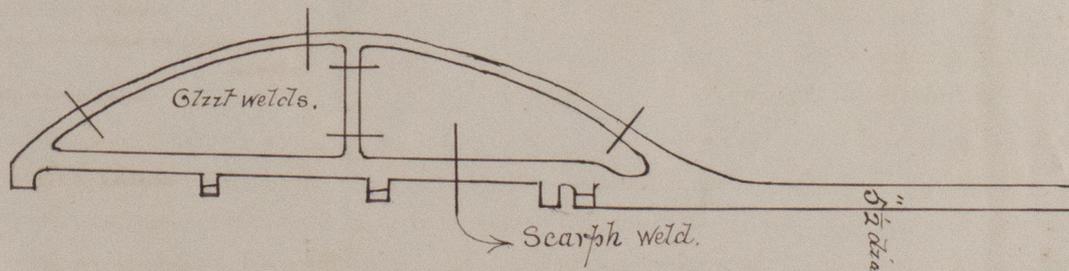

* If of Iron, state whether scrap or puddled iron.

