






" " ~~5.4~~ 4  
Hoic - Type Log  
Mushup Section


8 Inches 360/1 27/9/17



Returned to London  
26/3/18

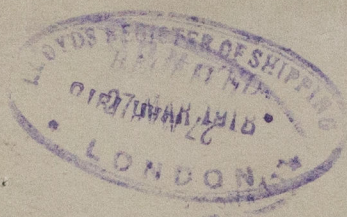

No 360. Dandy. Rpt. Mon 19304.  
No 361 Dandy Rpt Mon 19443

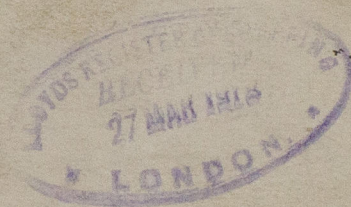

RETAIN



© 2021

Lloyd's Register  
Foundation  
W1050-0032