
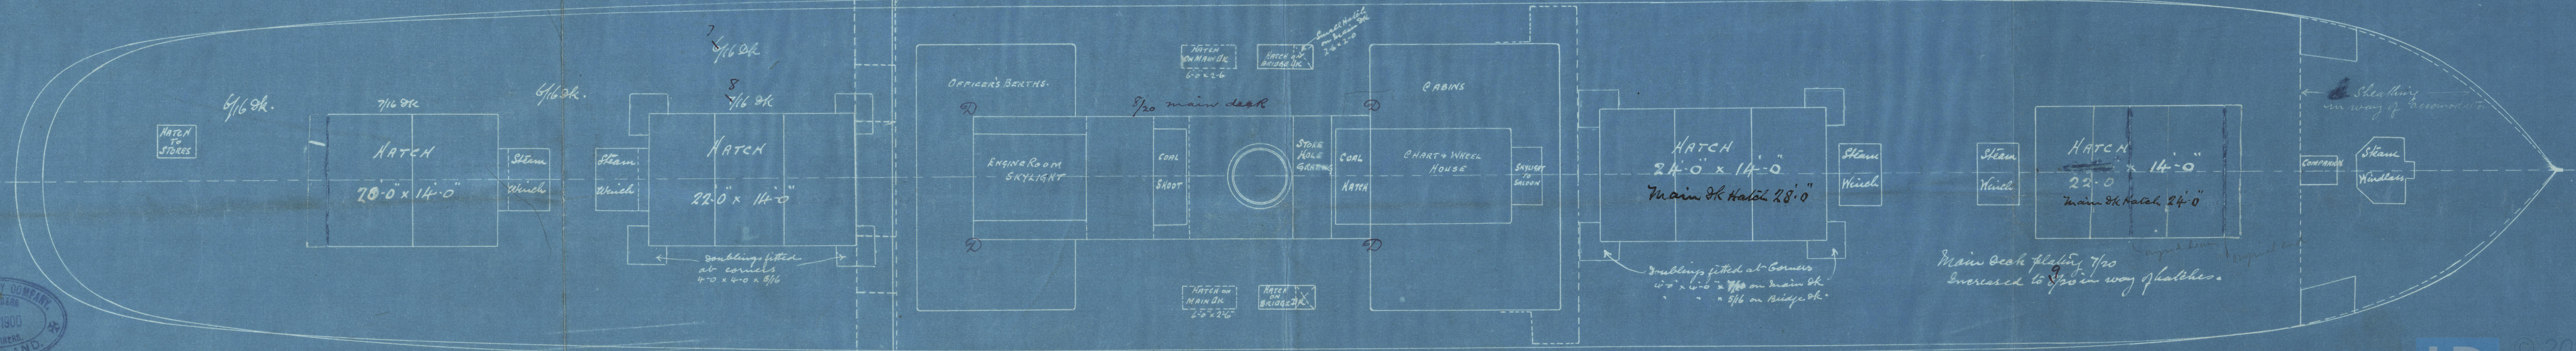


12-11-00
30-1-01
8-2-01
8-5-01

LONGITUDINAL ELEVATION NO 105 SHIP.

SCALE 1/8" = 1 FOOT

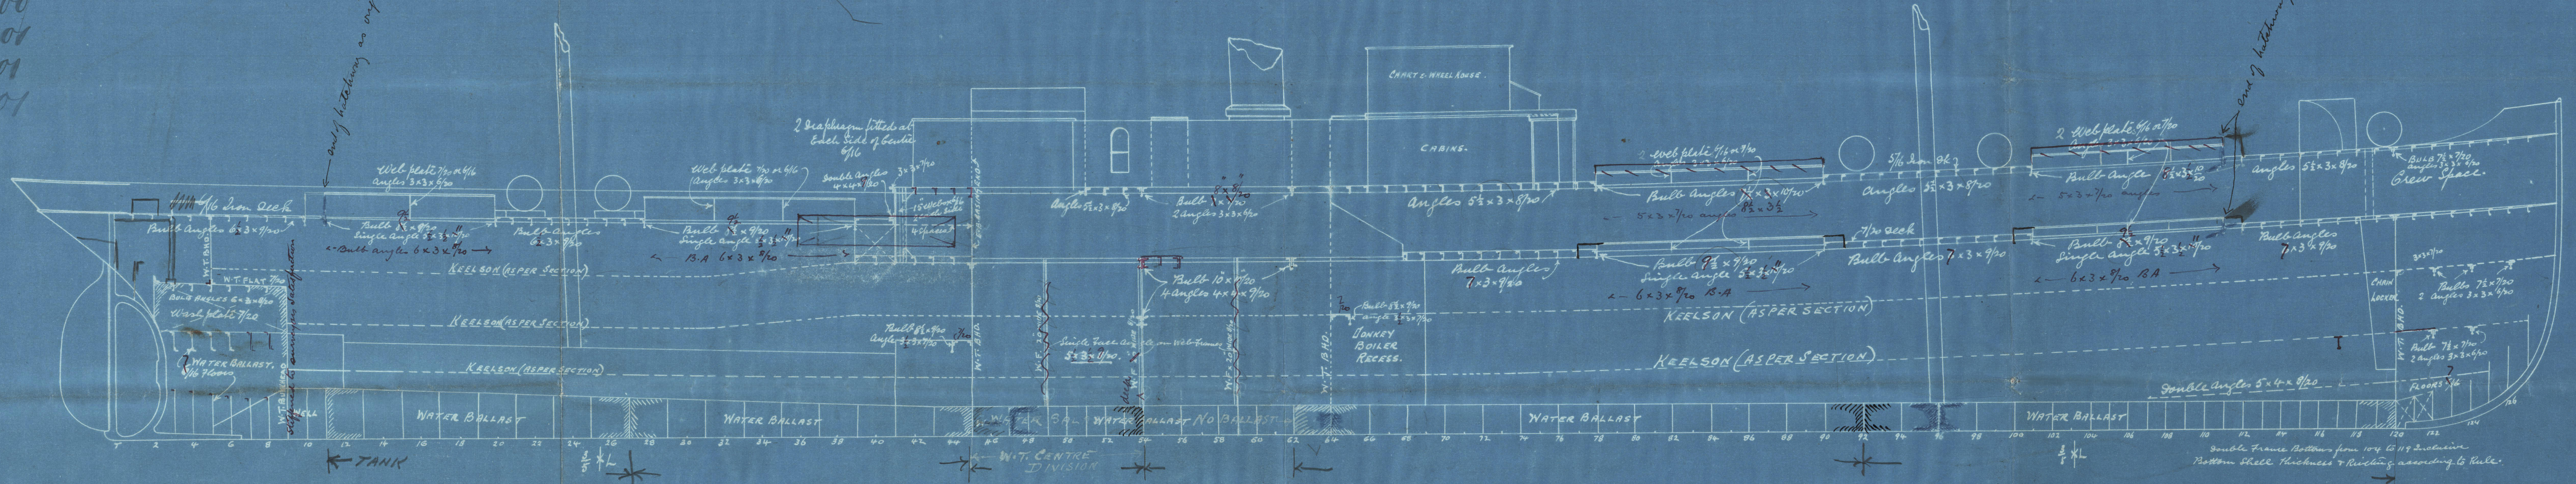

Messrs THE STRAND SLIPWAY CO
SHIPBUILDERS
SUNDERLAND.
Nov 5th 1900.

12/11/00



© 2020
The Register
Foundation

W1054-0217




Strand Slipway 6°

N° 105

Profile

S. S. Gracia


Sunderland 10626

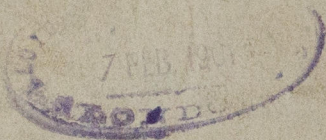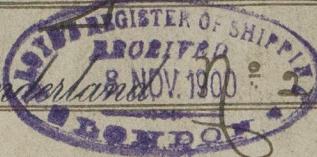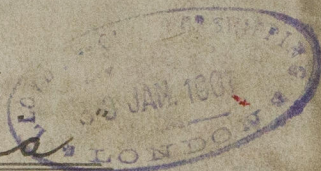

W1054-0217

RETAI

How - "Kandava"

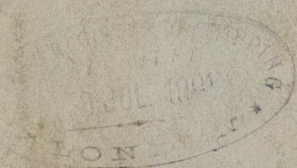

© 2020

Lloyd's Register
Foundation