


DIM<sup>s</sup> :- 164'-9" W.L. \* 30'-0" MLD + 9'-6" MLD  
SCALE "1" = 1 FOOT  
TO CLASS LLOYD'S A SPECIAL SURVEY FOR SHALLOW DRAUGHT RIVER VESSEL  
\* A.I. In Service on the Yangtze River

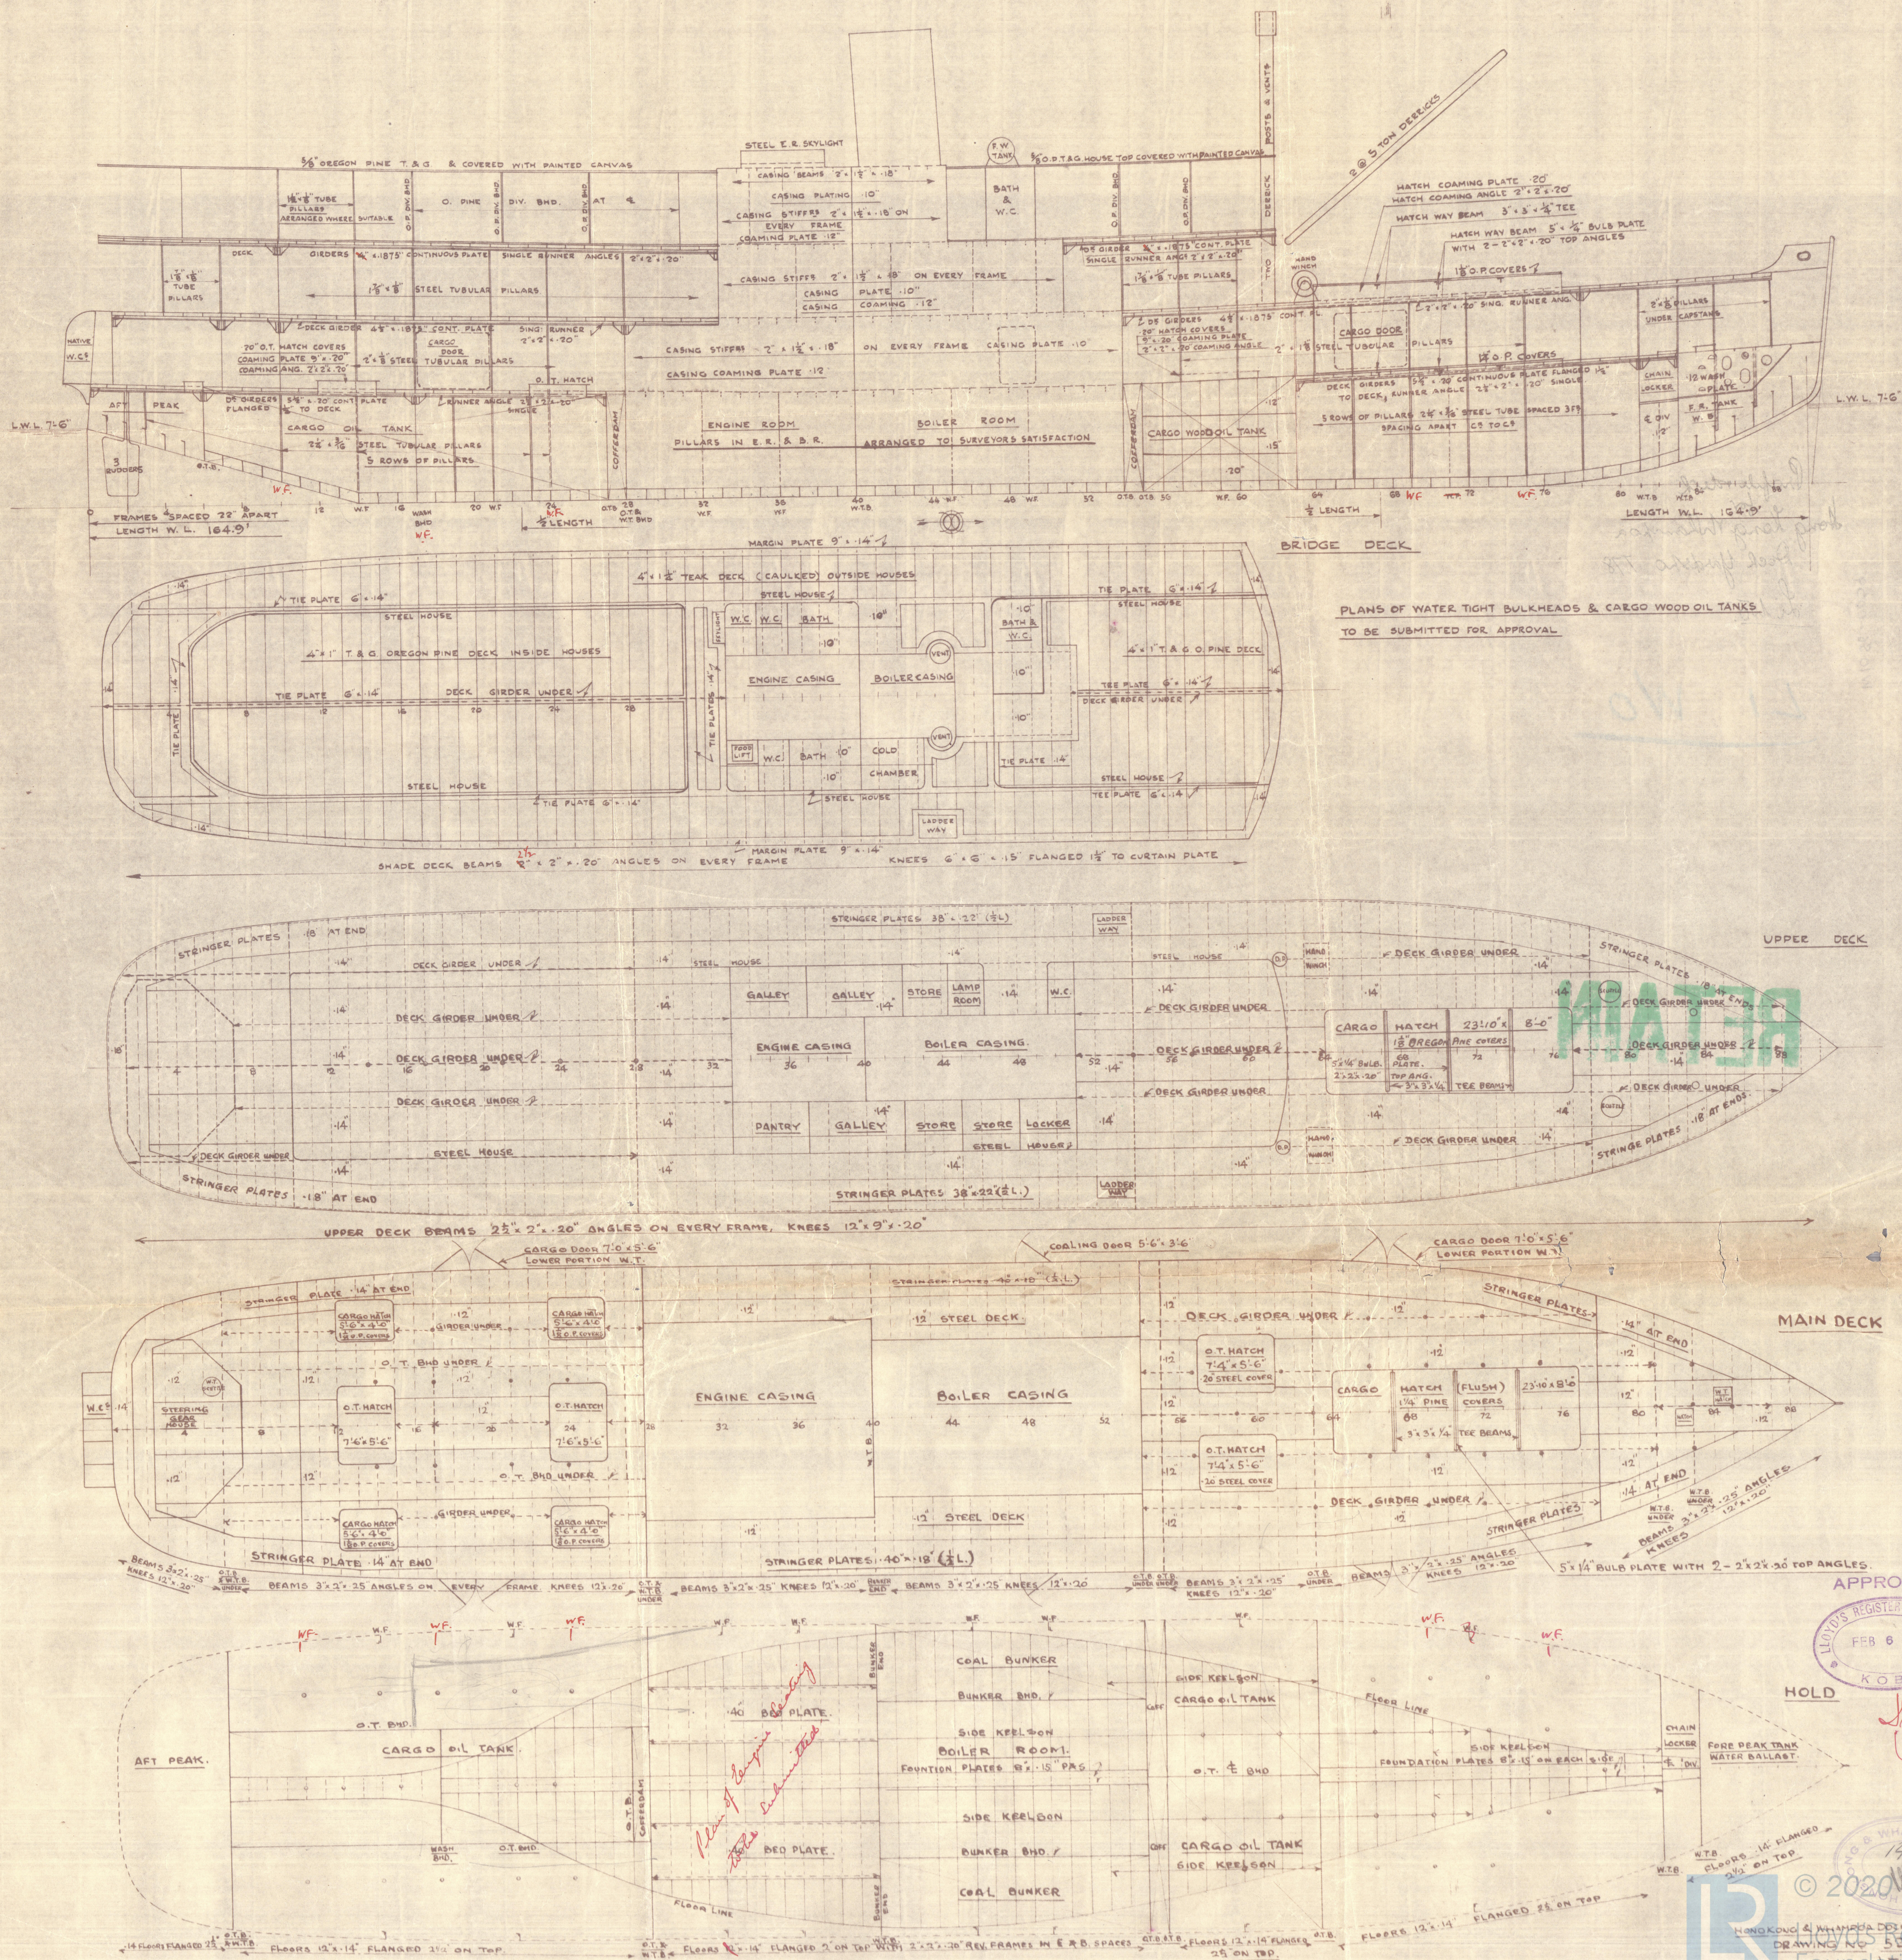



Profile deck  
for  
Hong Kong Whampoa  
Dock Yards No 778.

Li Wo.

W1086-0059

LI WO

RETAIN



© 2020

Lloyd's Register  
Foundation