

NB. 8 STK. BOLTE. D.C.D. 415 MM.  
BORES EFTER TRYKAKSELFLANG.

TOTAL: 12,740.661 = 134,98 TS. FOOT.<sup>2</sup>


MAXIMUM PRESSURE:  $35 \text{ kg/cm}^2$

TOTAL IHP WITH SUPERCHARGING: 3000.

1912 4 Forestport.  
1/30 4  
1913 3 pos. Lloyd's

17-1-30



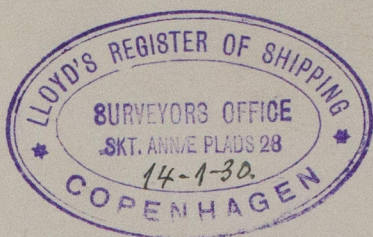

Plan of

INTERMEDIATE AND SCREW SHAFTS

for the Twin Screw Motor Vessel

Yard No 43

being built by

Akt. Nakskov Skibsvarft,

Nakskov.

17/5 "Marian" of Copenhagen.

Cpn. Rpt. No. 8551.



© 2020

Lloyd's Register  
Foundation

W1058-0163