
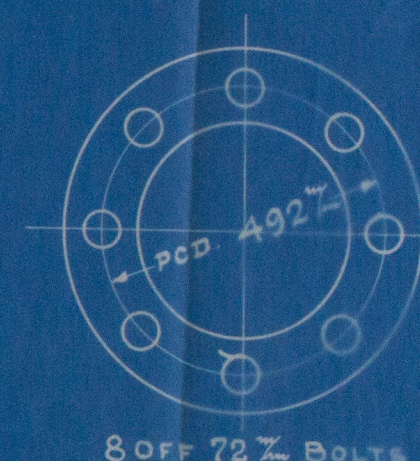
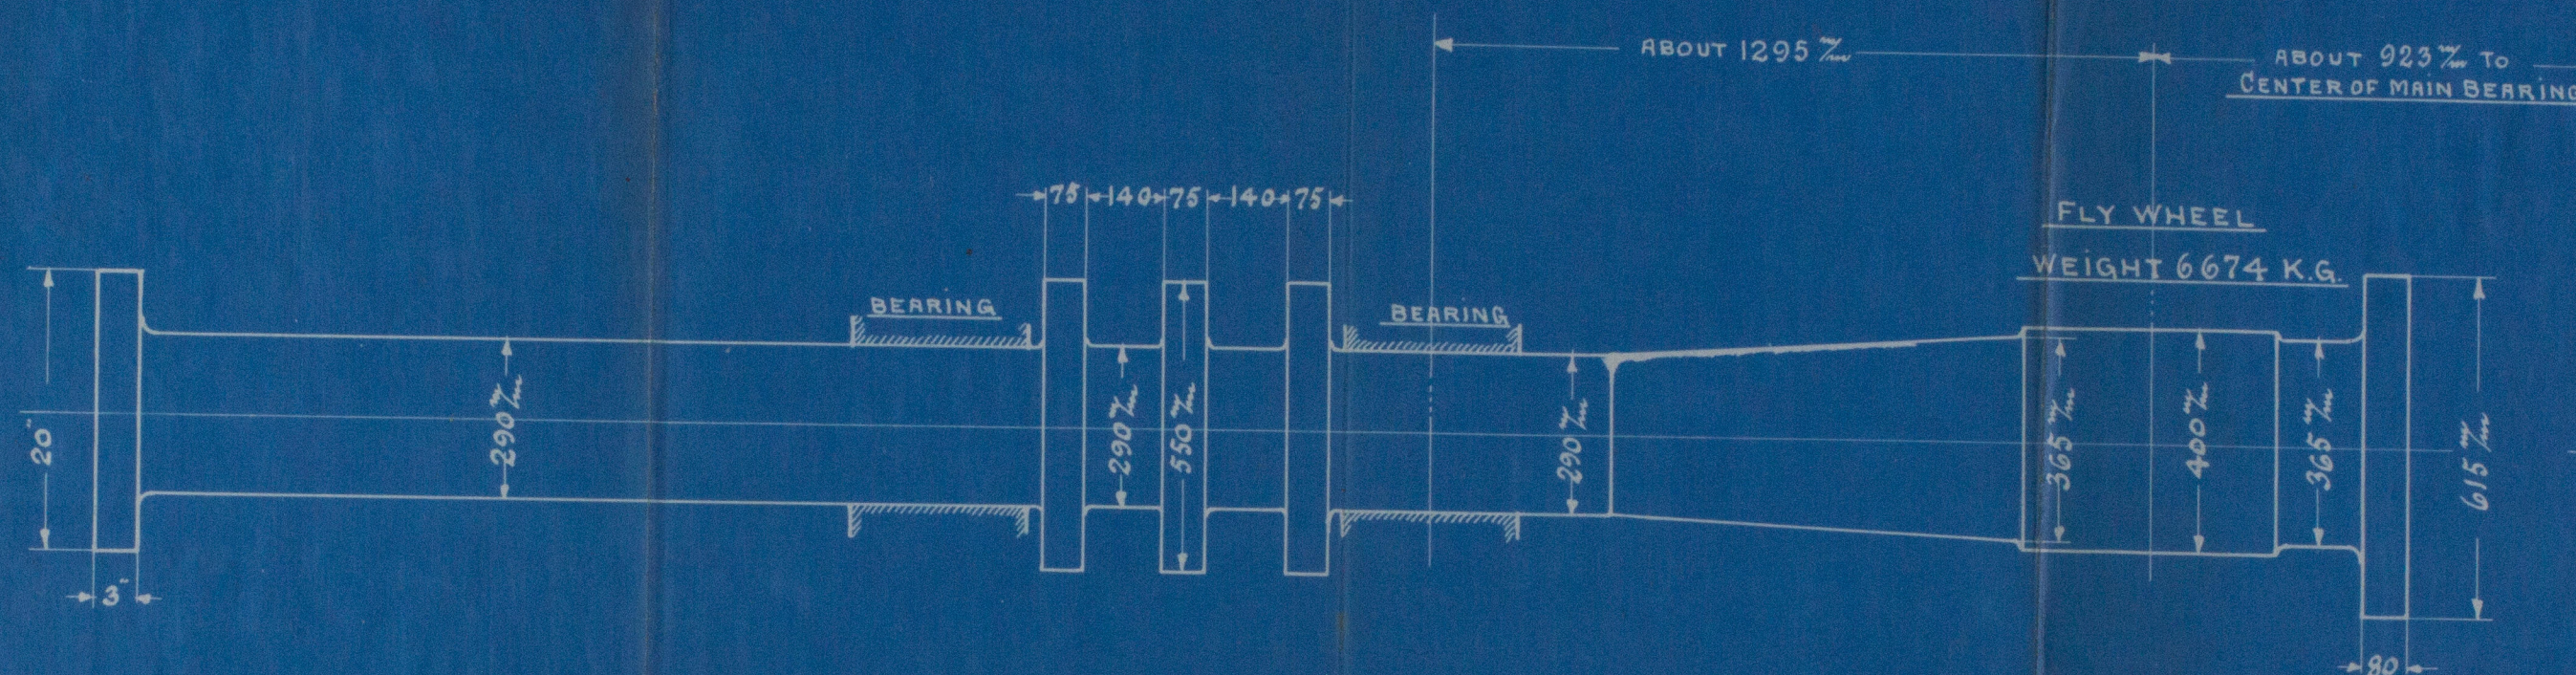


28108

15/11/20

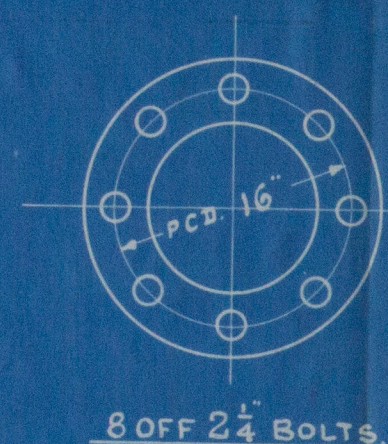

# THRUST SHAFT FOR ARDROSSAN N° 327 & 328

6 CYLINDER FOUR STROKE CYCLE DIESEL ENGINE

CYLINDER DIAM. 590  $\frac{mm}{in}$  (23  $\frac{1}{4}$ )

STROKE 900  $\frac{mm}{in}$  (35  $\frac{7}{16}$ )

DIAM OF PROPELLER 11'-0"

AKTIESELSKABET  
BURMEISTER & WAINS  
MASKIN- OG SKIBSBYGGERI

APR 24 12/11/20

AKTIESELSKABET  
BURMEISTER & WAINS  
MASKIN & SKIBSBYGGERI  
26 · 10 · 1920 N° 28108.



London

to Nordbo.

Opn 6698.

Plan of

Thrust shafts  
for Diesel Oil Engines  
to be constructed

by Gen ~~Box~~ <sup>3342</sup> ~~5949~~

ABET

ARTTUELSKABET

& WAINS

BURMEISTER & WAINS

BYGGERI

MASKIN- OG SKIBSBYGGERI

Copenhagen  
for

Turni Screw Motor Vessels

Yard No 327 & 328

to be built by

Messrs Ardrossan Dry Dock  
& Shipbuilding Co Ltd.

Ardrossan



Register

W1058-0180