
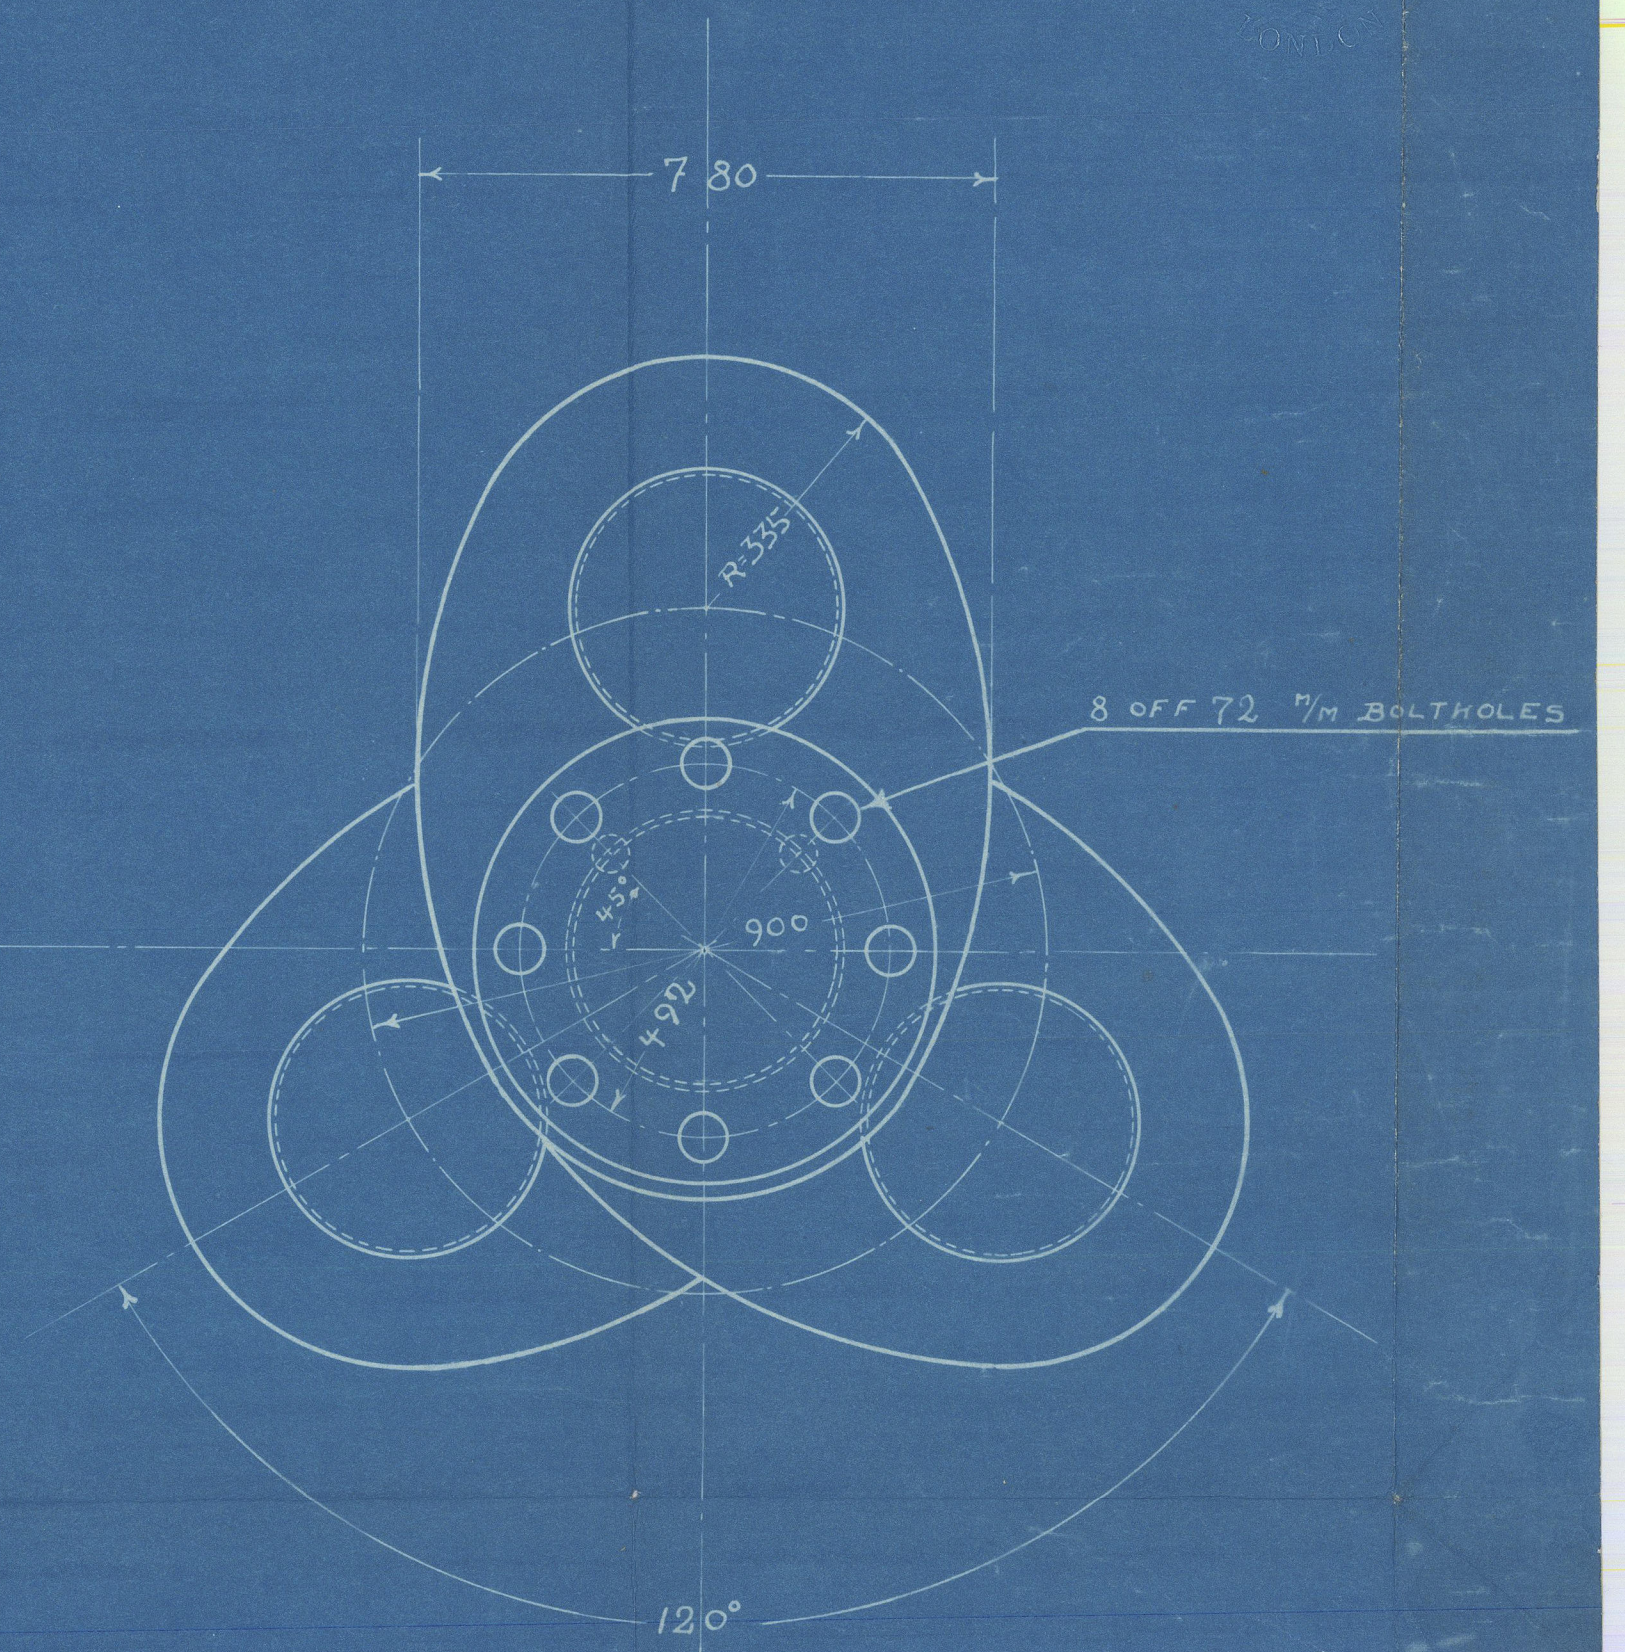


62542

15/11/20

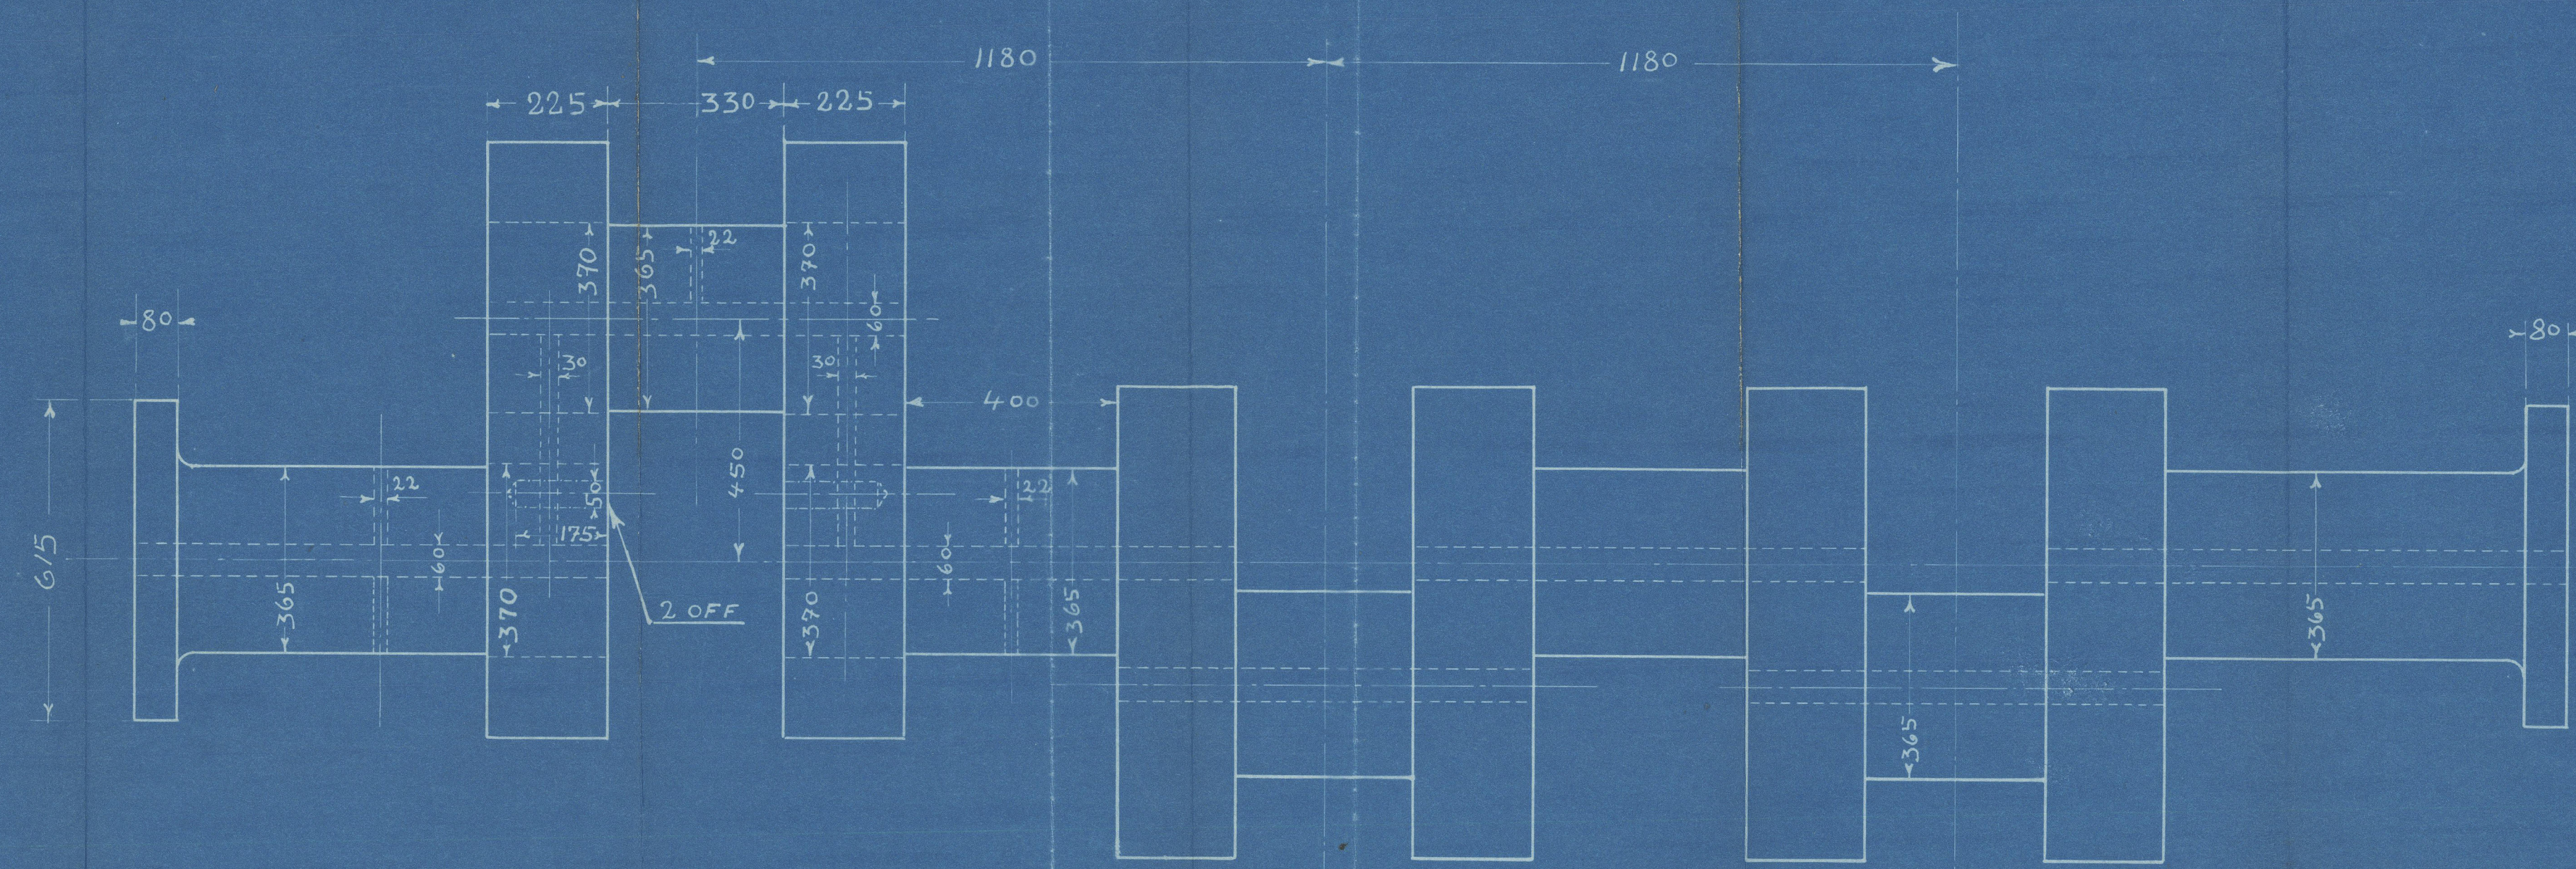

SHAFT FOR TS. N° **ARDROSSAN**

6 CYLINDER FOUR STROKE CYKLE DIESEL ENGINE.

N° 327-328

CYL. DIAM. 590.

STROKE 900.

APPROVED
BURMEISTER & WAINS
MASKIN- OG SKIBBYGGERI

958
12/11/20



© 2020
Lloyd's Register
Foundation

62542

London
Copy
Plan of
Crank shafts

of Mann Diesel Oil Engines

to be constructed by

~~Genl. Børgesen 3944.~~

S. Nordbo ~~6698.~~

~~ARTISEREN~~

BURMEISTER & WAINES
MASKIN- OG SKIBSBYGGERI

Copenhagen


for

Turn Screw Motor Vessels

Yard No 327 & 328

to be built by

Messrs Ardrossan Dry Dock
& Shipbuilding Co (Ld)
Ardrossan

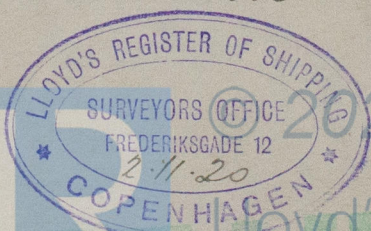

Lloyd's Register
Foundation

W105860181