


Gen. Date 3949

PLAN OF
THRUST, INTERMEDIATE AND
PROPELLER SHAFTS FOR THE
Twin Screw Motor Vessels
Yard No 327 & 328
being built by

~~ARTIFISER~~
BURMEISTER & WAIN
MASKIN OG SKIBSBYGGERI

Copenhagen
28-3-1923

2-B

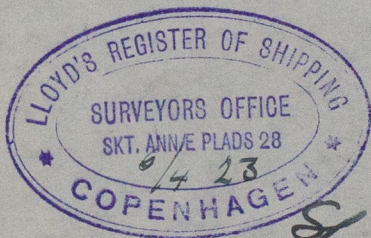

E. S. Nordbo.

Com 6698



© 2020

Lloyd's Register
Foundation

W1058-0183