





Workman Clark & Co

247-8

Yard Profile



© 2020

Lloyd's Register  
Foundation



Messrs Worsman Clark & Co

T.S.S. 247


Profile as Built

"NORCE"

EX

T.S.S. Whakarua

Bel. No 6335

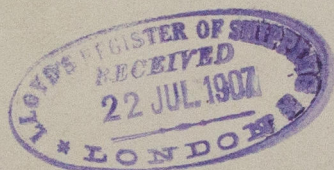

RETAIN



© 2020

Lloyd's Register  
Foundation

W1058-0203