



PROFILE and DECK PLANS

N^o 348

Scale 1/8" = 1' 0"

Length B.P. 390'-0" Breadth M^o 53'-9" Depth M^o 32'-0"
D^o 389'-6" on LWL

RIVETING IN GUSSETS & TANK MARGIN ANGLES
TO BE INCREASED AS REQUIRED BY SECT 8-B
RIVETS ATTACHING TUB TOWERS TO SHELL PLATING 5/8" C^o IN C^o
FRAMES 12" x 22" x 7/8" B.A.

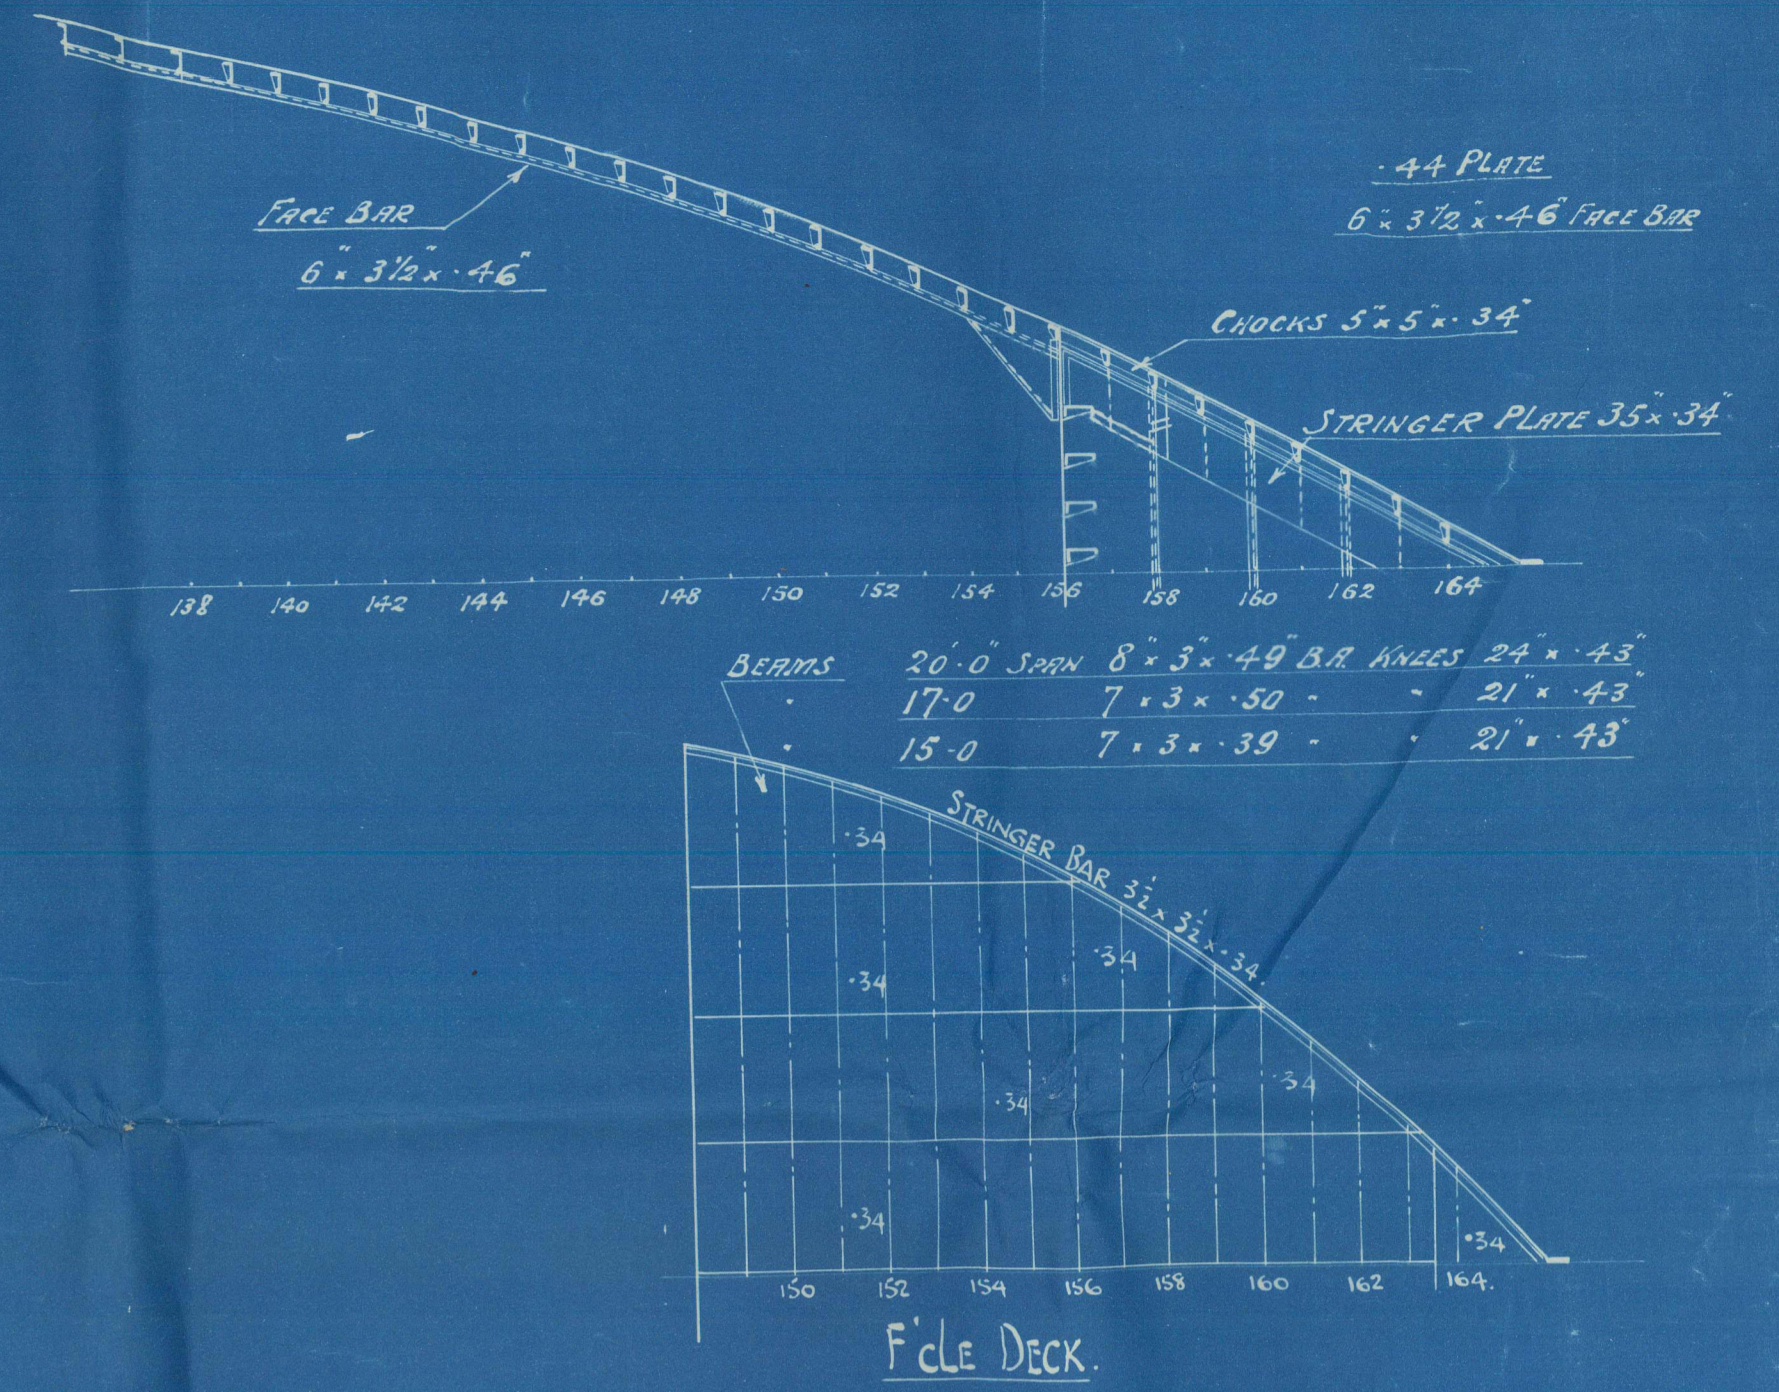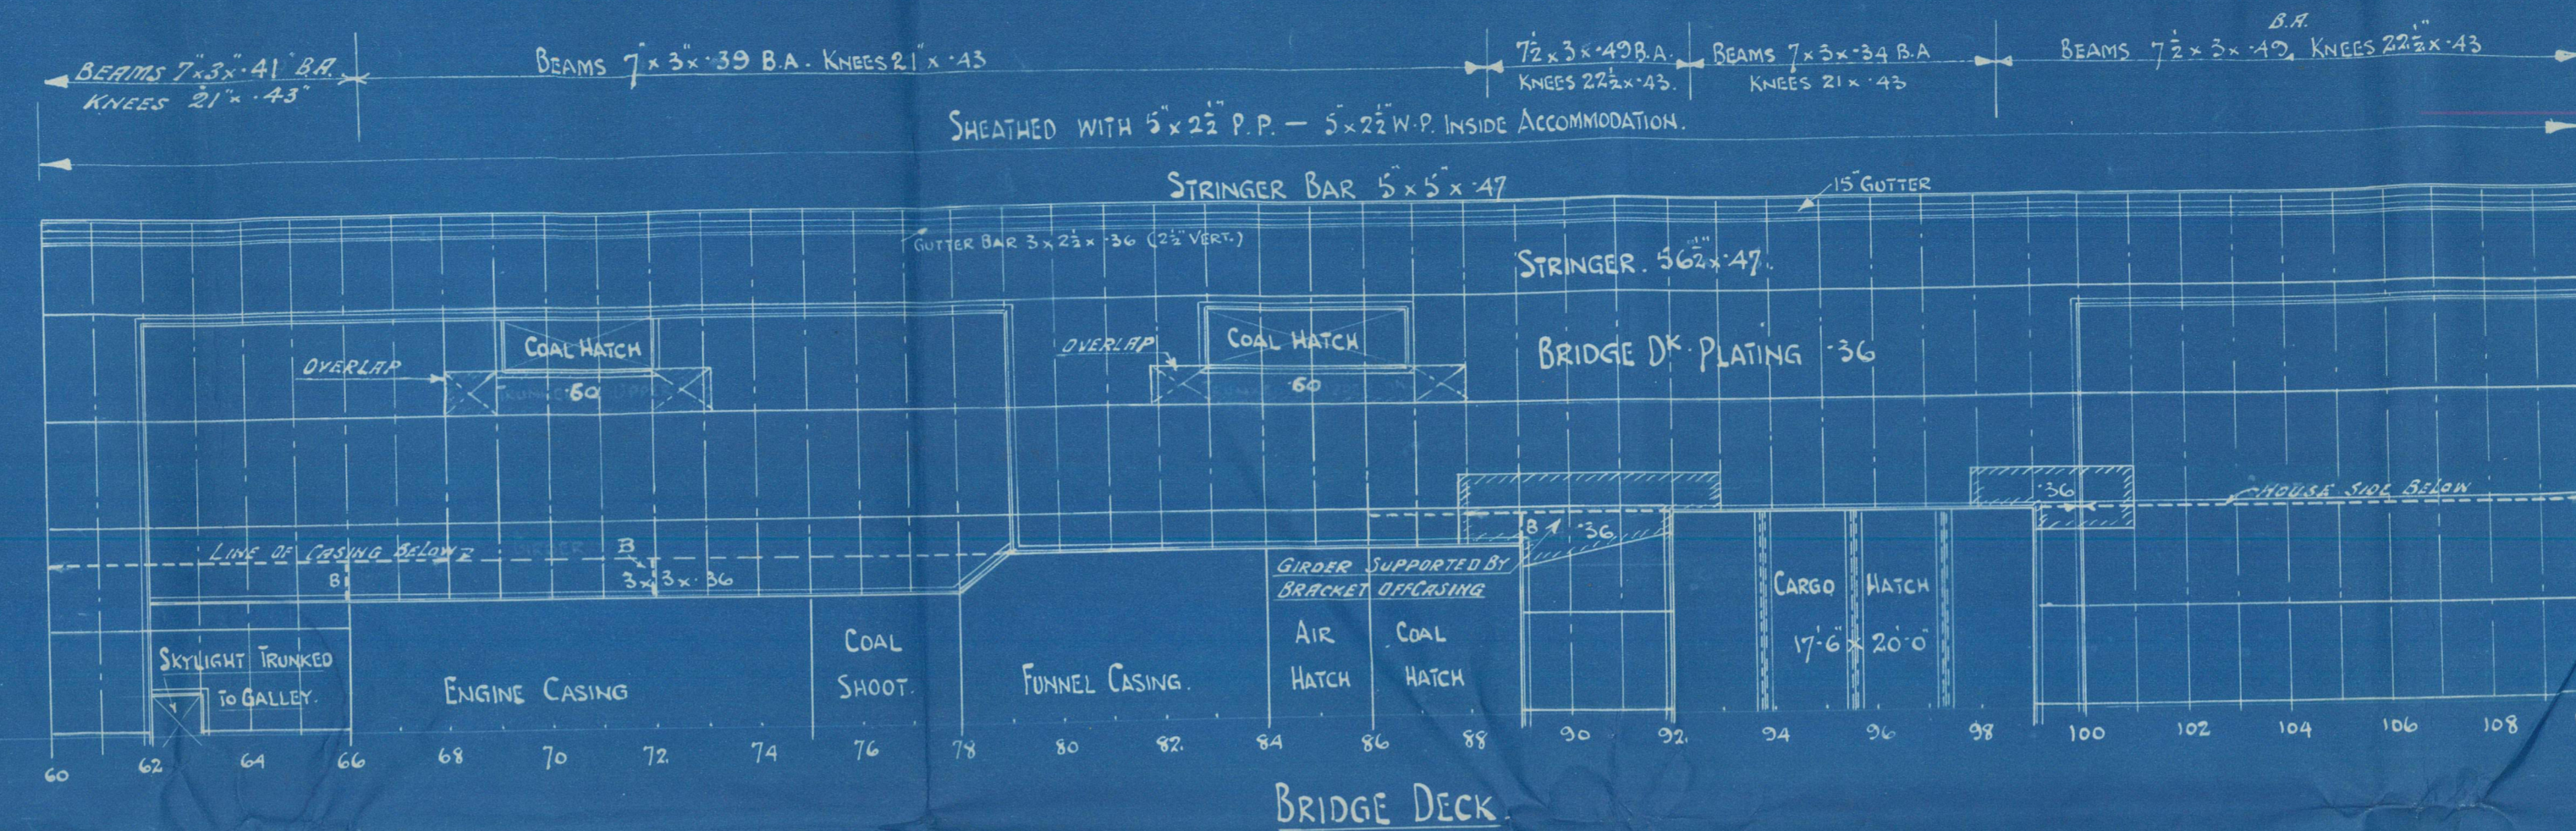

NOTE: STIFFENERS ON V.T. BIDS IN WAY
OF DECK GIRDERS TO BE OF INCREASED SIZE
A BRACKETED. SPACING LINES TO BE
CONSIDERED WITH PLAN OF GIRDERS.

BRIDGE FRONT 40'-
CEAMING 14'-
STIFF: 12' x 5' x 47 B.A. (60APART).
LUGS TOP & BOTTOM (5 RIVETS).

HATCH 24'0" x 26'0"
HATCH SIDES & ENDS 44' HORIZ. STIFFS
7' x 3' x 48 B.A. (60APART) END WITH STAYS
TO DECK NOT MORE THAN 10'0" APART.

Collision B.P.
PLAN TO BE
SUBMITTED

SEC 33 PAR. 6 TO BE COMPLIED WITH.

W.T. 8" PLATING
PLAN TO BE SUBMITTED

HATCH 25'0" x 26'0"
HATCH SIDES & ENDS 44' HORIZ. STIFFS
7' x 3' x 48 B.A. (60APART) END WITH STAYS
TO DECK NOT MORE THAN 10'0" APART.

HATCH 25'0" x 18'0"
HATCH SIDES & ENDS 40' SIDE COAMINGS
PLATED UNDER BEAMS.

8" PLATING 38" to 20"
LIMBS 14" COAMING 14"
STIFFS 6' x 3' x 38 B.A.
BID: 3/4" WITH 2 1/4" x 140 BOUNDARY AND 3/4" x 38-48.

DEEP TANK
PLAN TO BE SUBMITTED

SECT 18, PART 7

HATCH 21'0" x 26'0"


HATCH 21'0" x 18'0"

HATCH 24'0" x 18'0"

HATCH 24'0" x 18'0"
HATCH SIDES & ENDS 40' SIDE COAMINGS
PLATED UNDER BEAM.

HATCH 24'0" x 18'0"
HATCH SIDES & ENDS 40' SIDE COAMINGS
PLATED UNDER BEAM.

HATCH 24'0" x 18'0"
HATCH SIDES & ENDS 40' SIDE COAMINGS
PLATED UNDER BEAM.

 

The Clyde S.B.C.

S.S. ^r SABBIA.

N^o. 348.

Profile & Deck plans
as Built.

Gen. Rep^t N^o. 18530.



© 2021

Lloyd's Register
Foundation

W1059-0213