

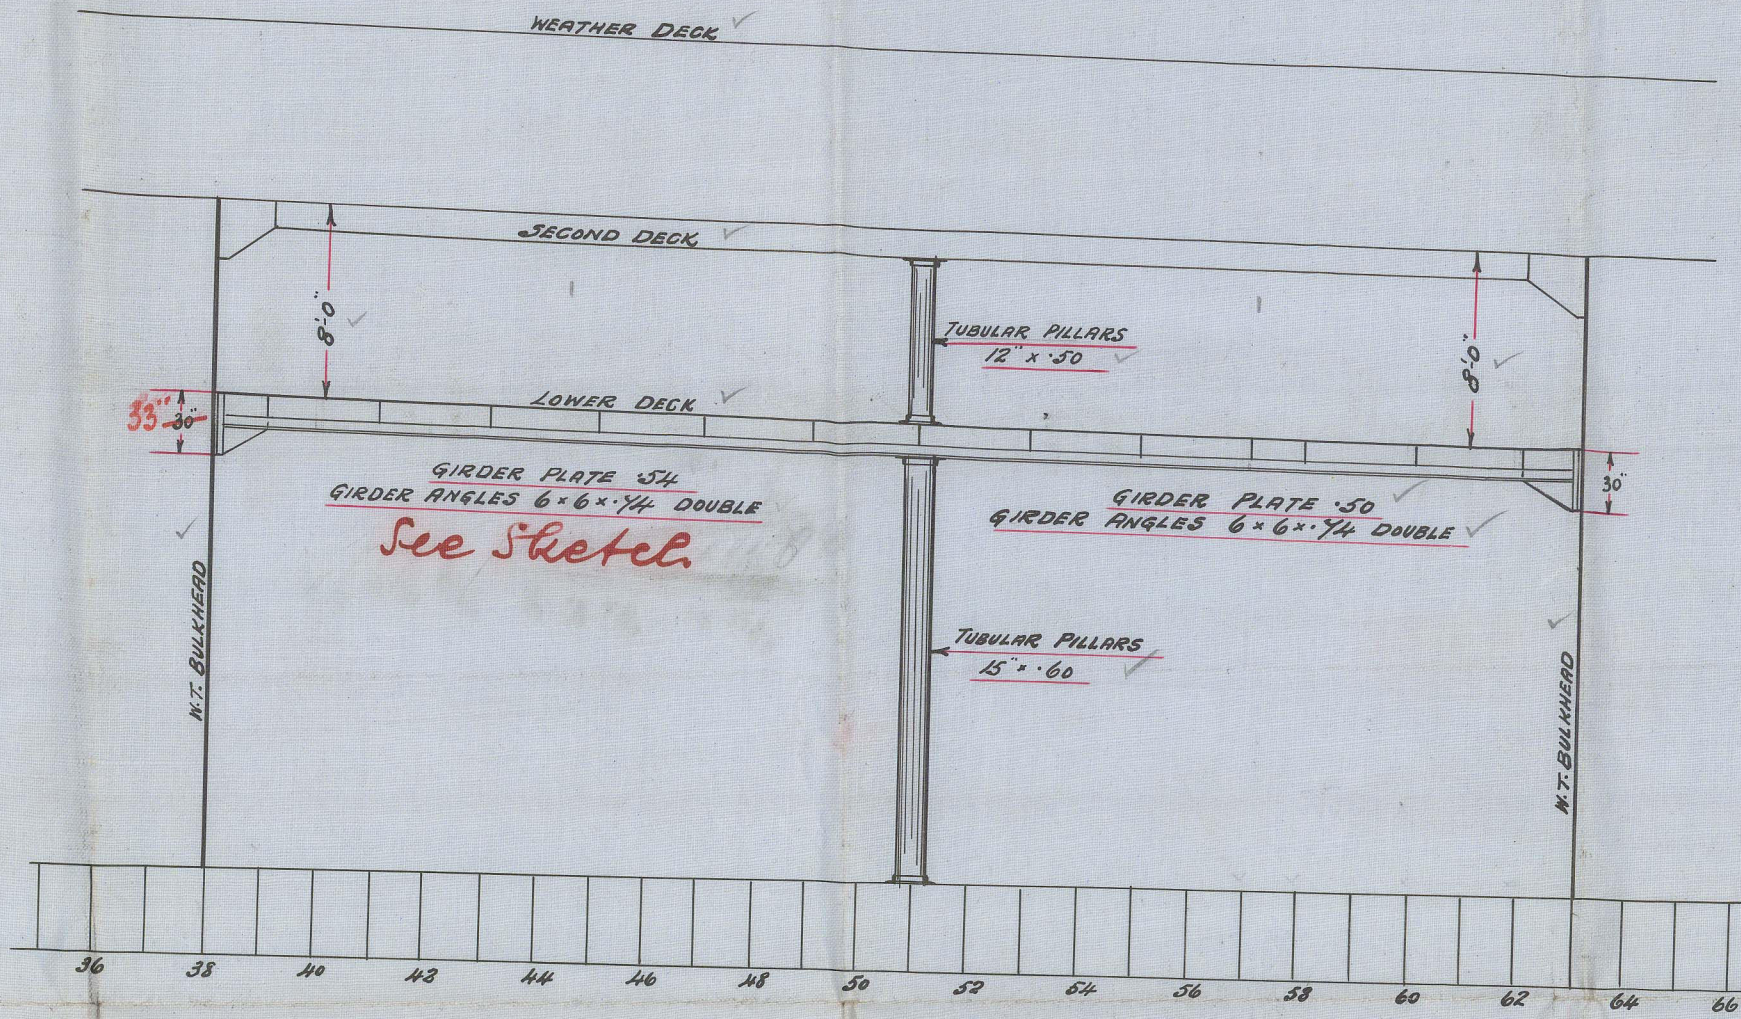
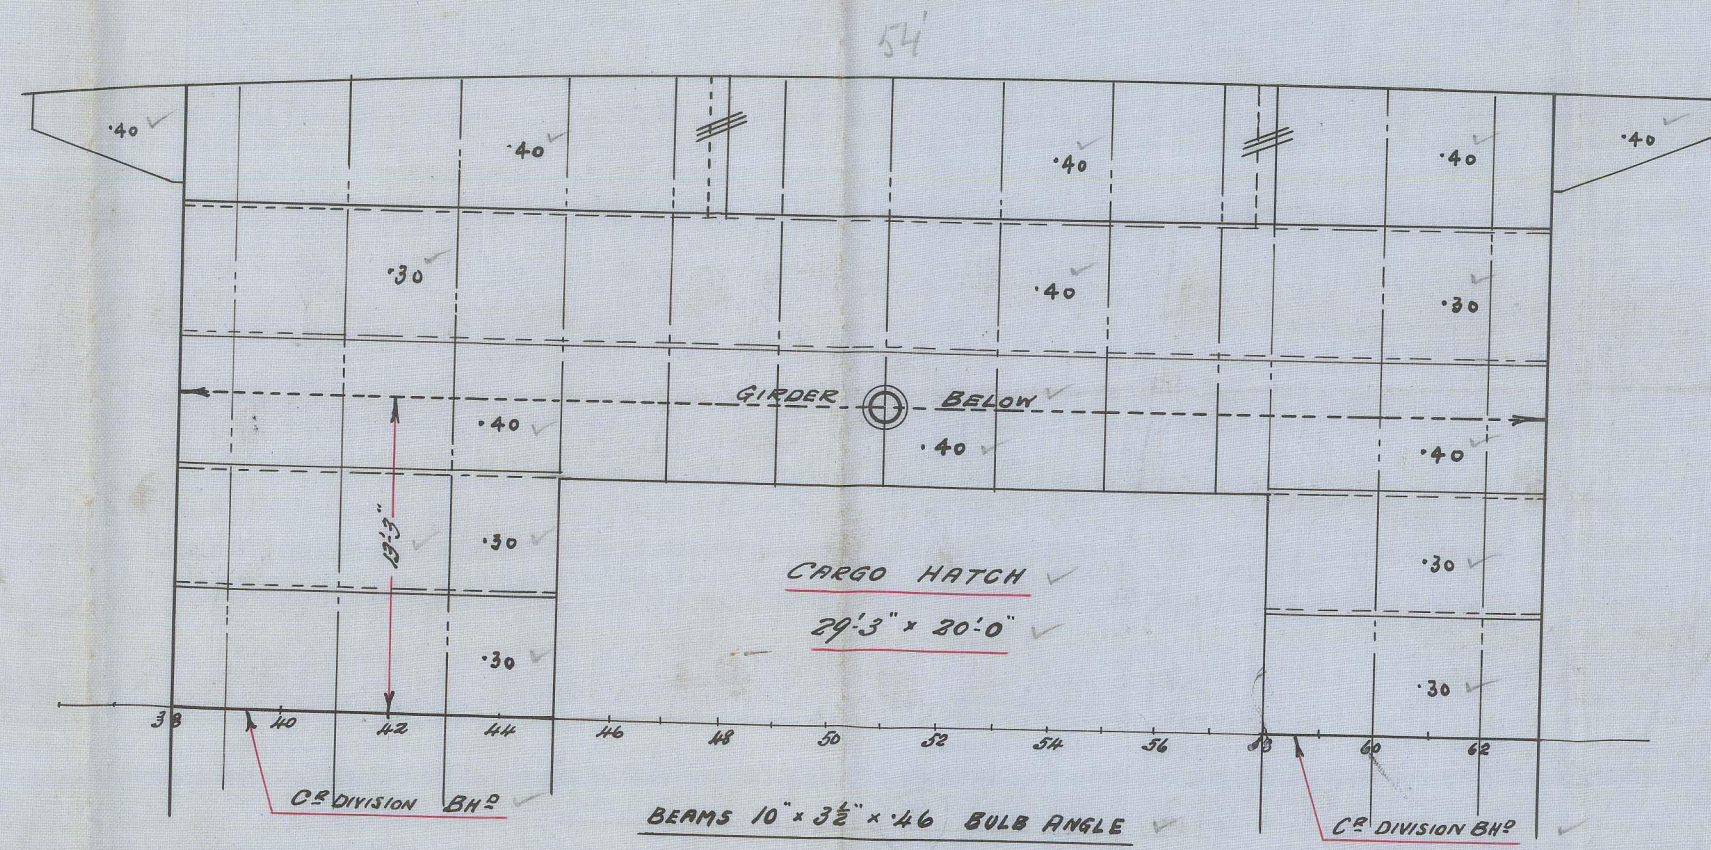


— N°600 —  
LOWER DECK GIRDER


SCALE  $\frac{1}{8}'' = 1 \text{ FOOT}$

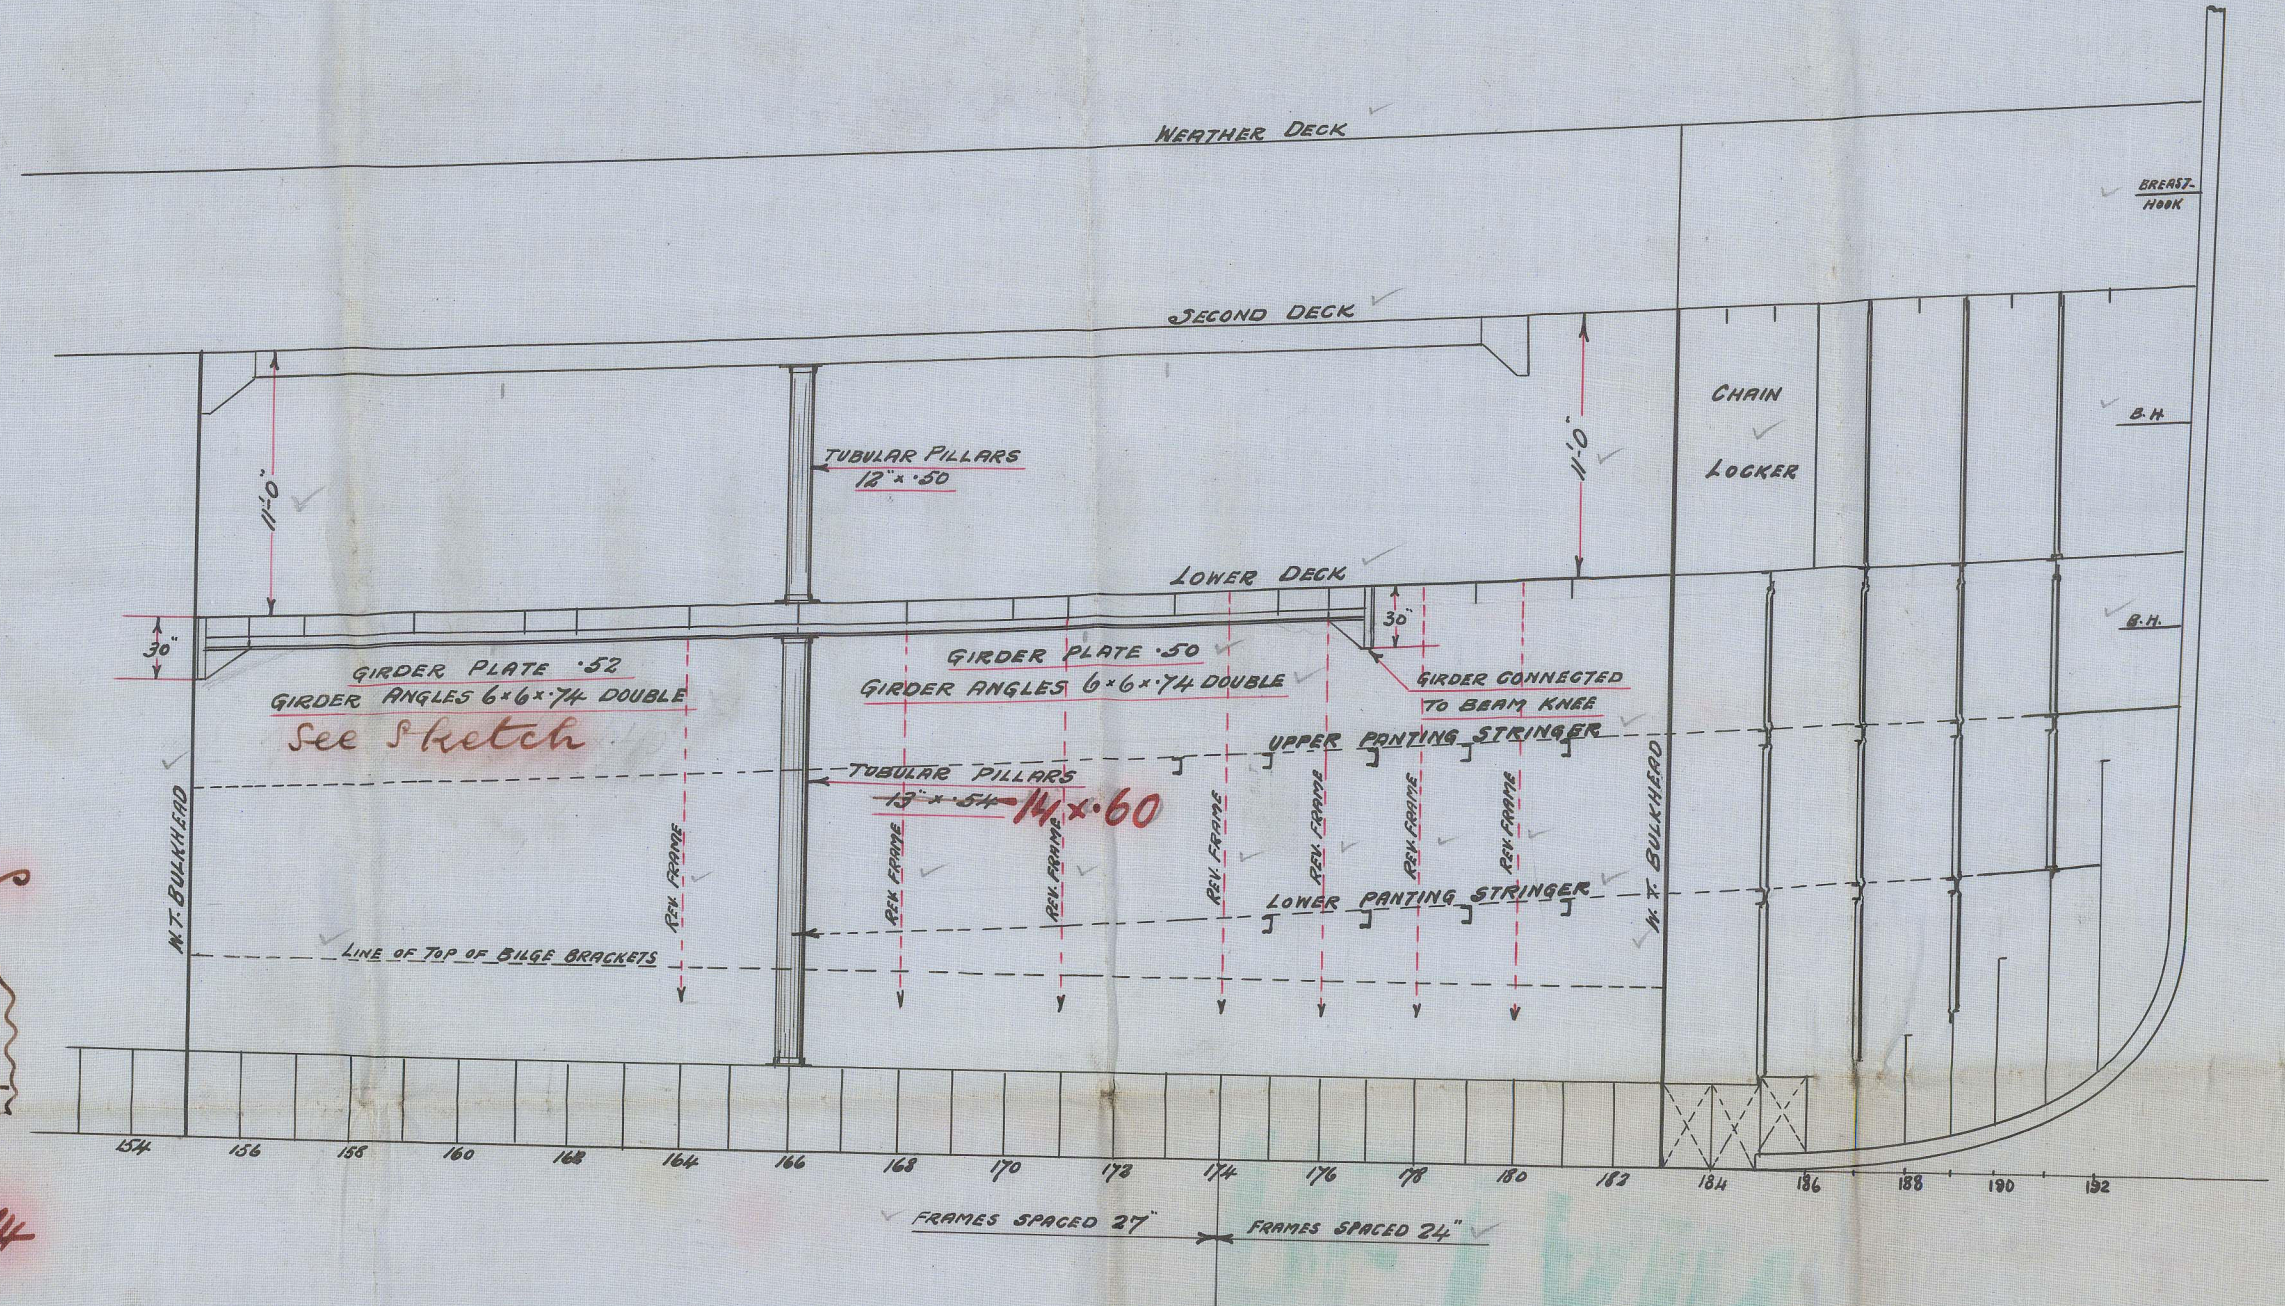

Section of  
beam guides

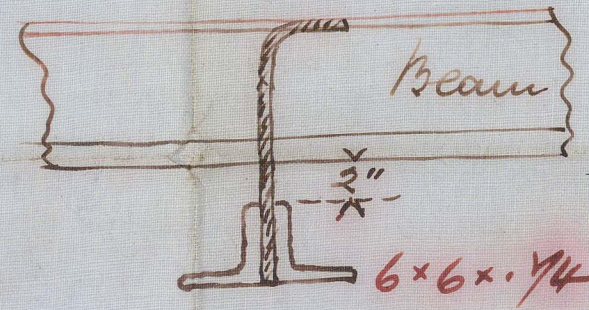

26-2-13

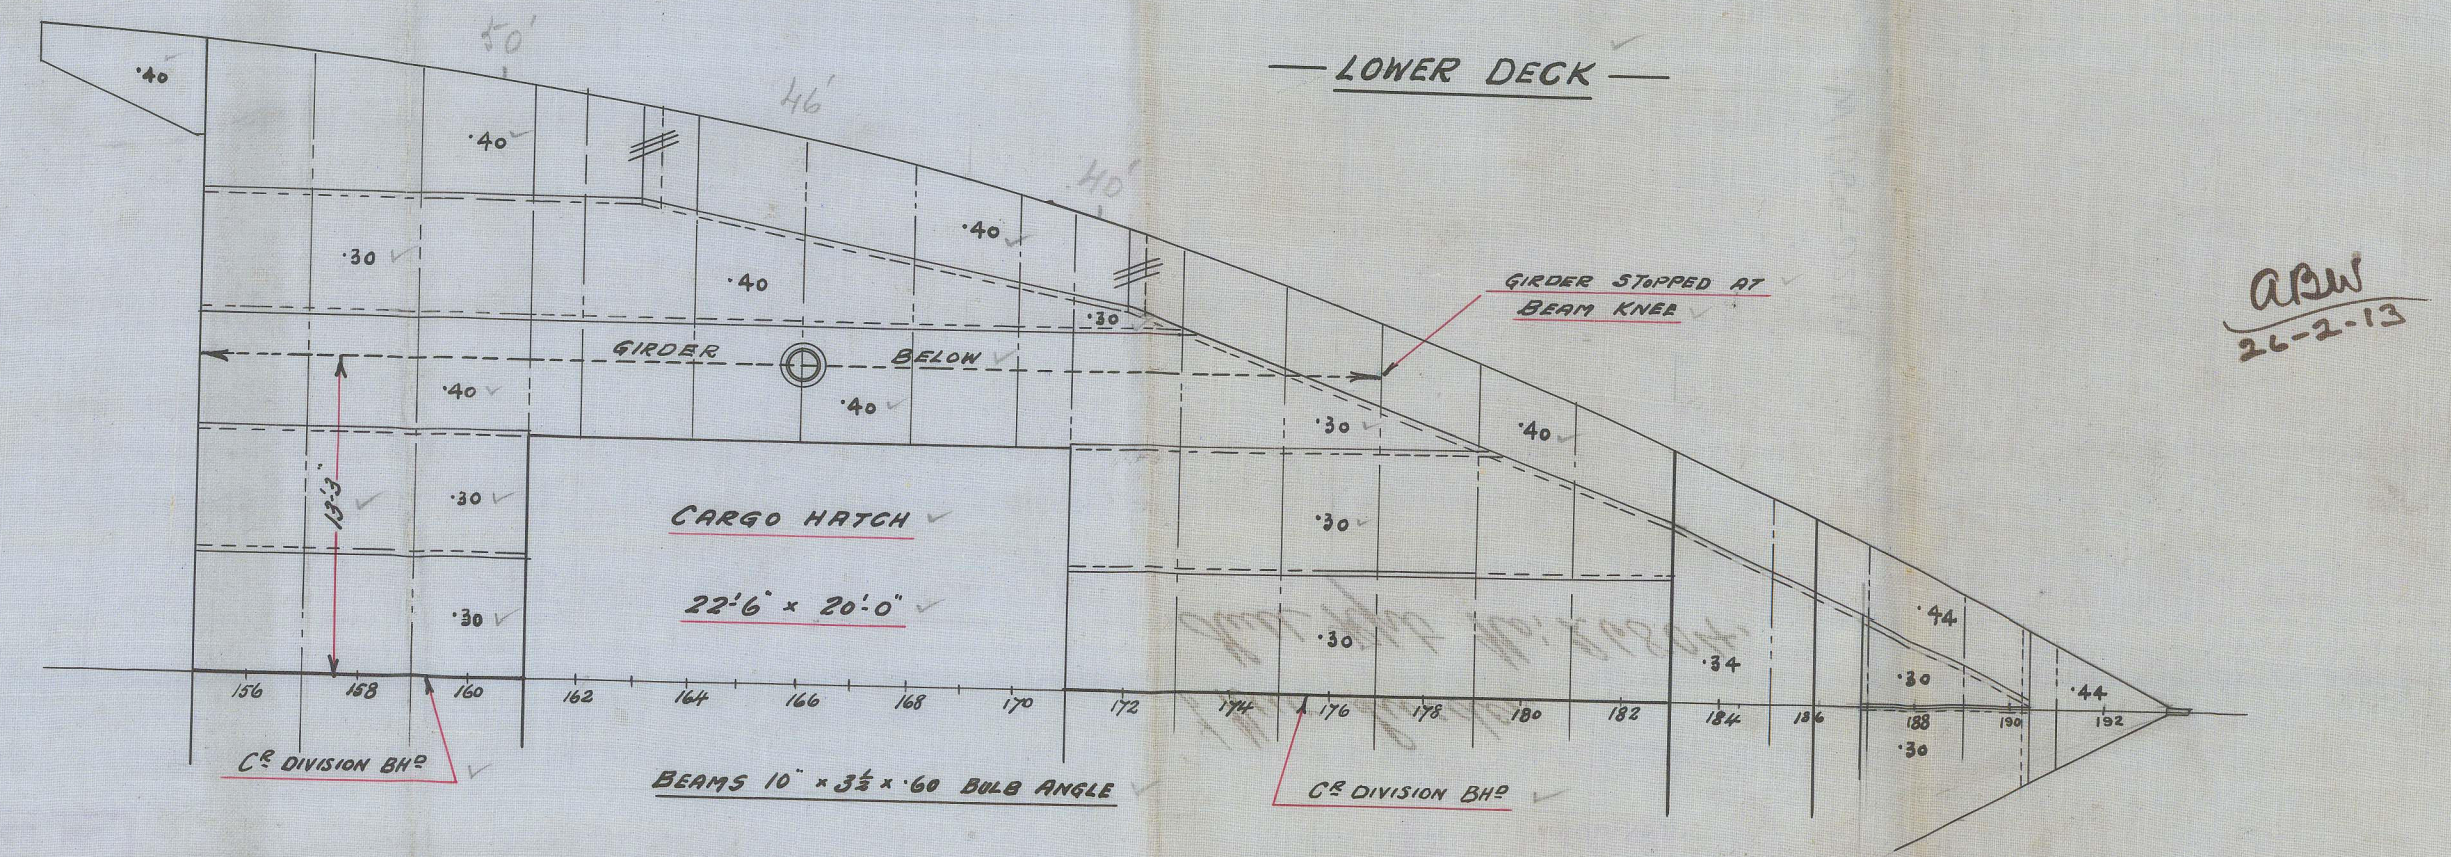

ABW  
26-2-13

James Jones  
No. 900  
Bangs 2.10.8.0



Barle's S. B. & E. Co.  
No. 600  
Lower Deck

New Sweden  
Hull Kpt No: 26804.

W1059-0249




© 2021

Lloyd's Register  
Foundation