

18.4.12
(No. 600) 26.4.12
26.5.12
27.6.12

"Sagoland" MIDSHIP SECTION

N^{os} 599 & 600

DIMENSIONS 430'0" x 53'11" x 28'11" M^{LD}.



SCALE $\frac{1}{2}$ " = 1 FOOT

CLASS 100.A.1. AT LLOYDS

See separate plan for No. 600.



Modified in blue (as built)

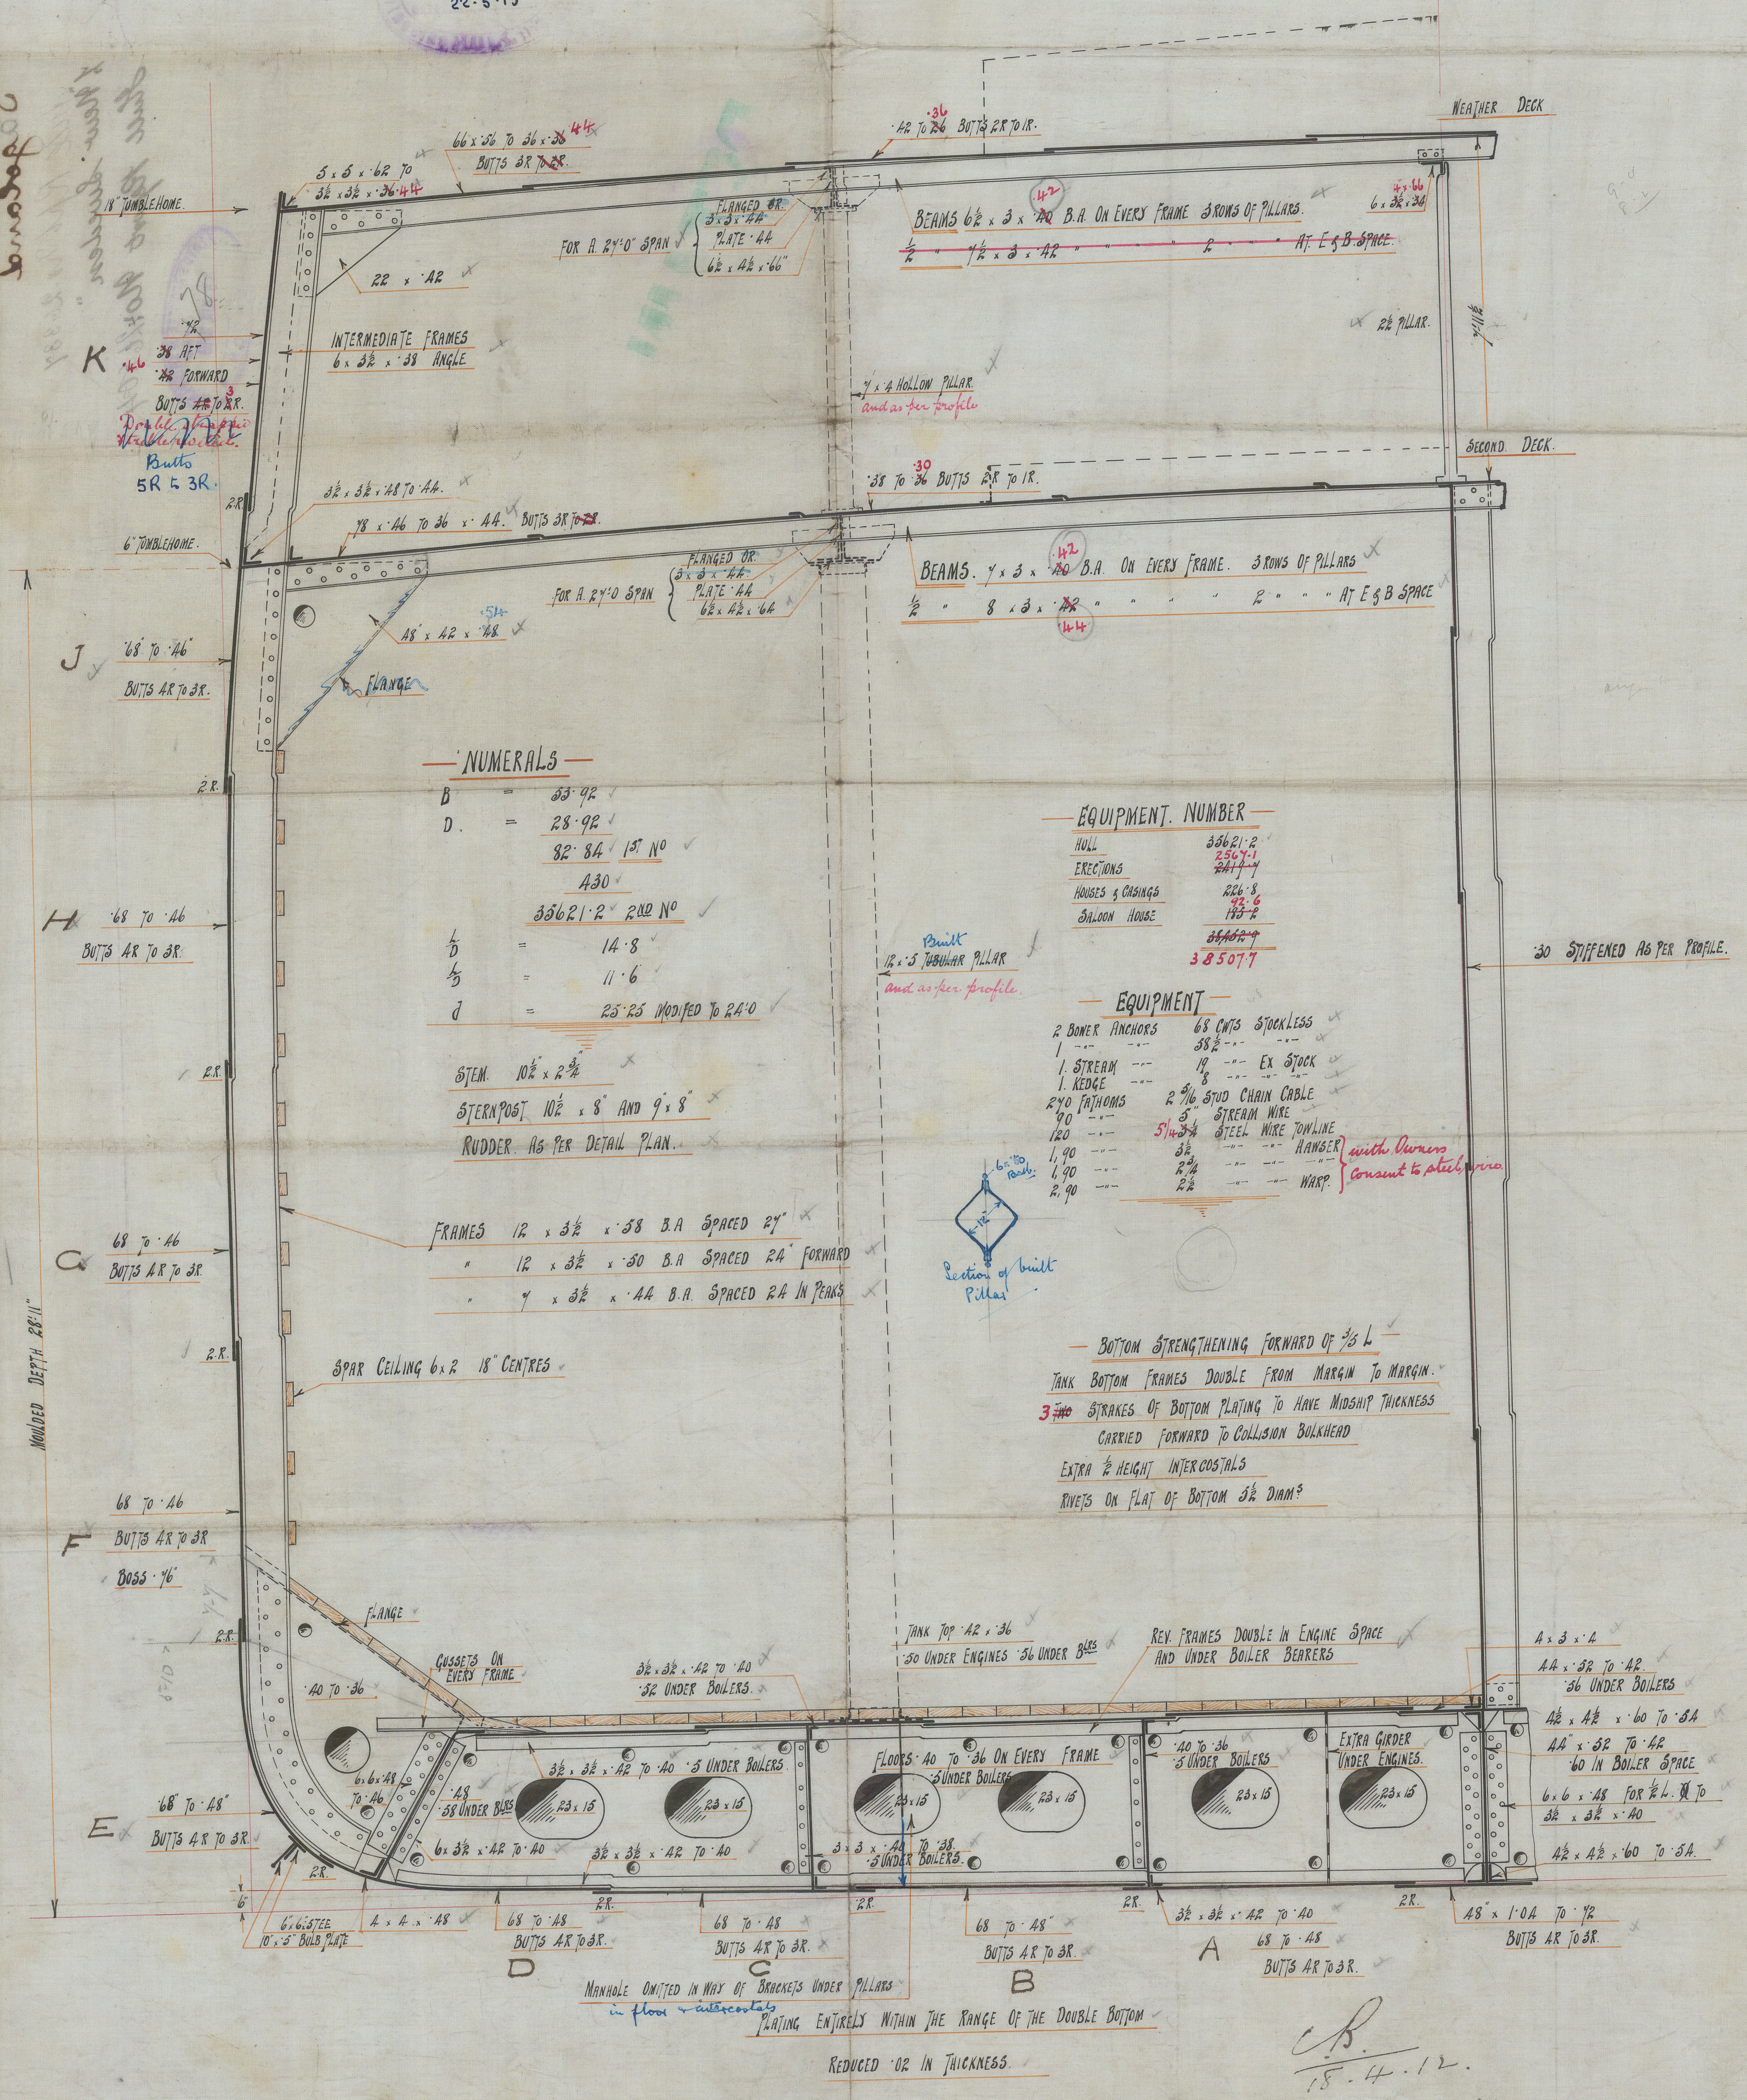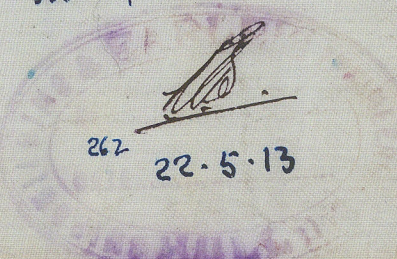

Original plan

Messrs EARLE S.B. & CO.

No 5994600.



MIDSHIP SECTION

"Sagoland"

Hull Rpt No. 26337

1/2 "New Sweden"

Hull Reports No: 26804

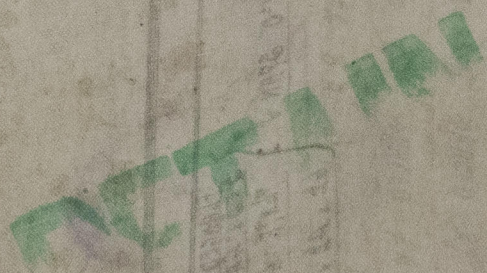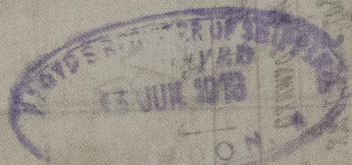

W1089-0251



© 2021

Lloyd's Register
Foundation