


25/11/16.

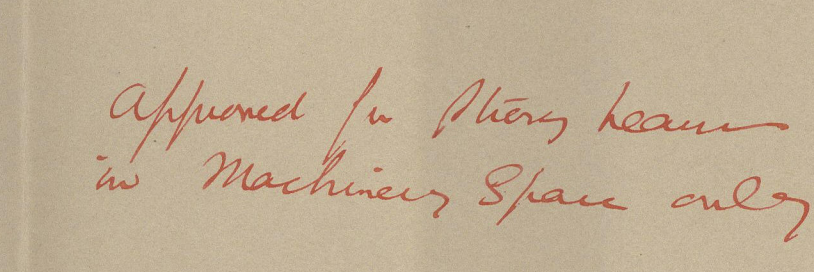

1:100 NK  
16-7-36 4/2

PROFILE AND DECKPLANS


W106-0045



Odense Staalskibsvaerk ved G. P. Møller  
Odense.

Yard No. 69/70.

Profile & Decks.

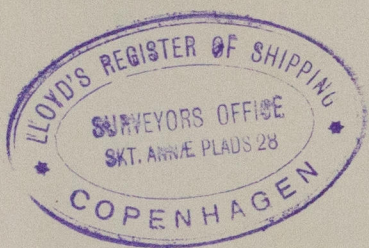

Shony keans in M.S.


(1)

Yard no. 69. - M/T. "Oilfield" of  
Newcastle.


Eng. Repat no. 10485.

Yard no. 70. - M/T. "Duffield" of  
Newcastle.

Eng. Repat no. 10521.

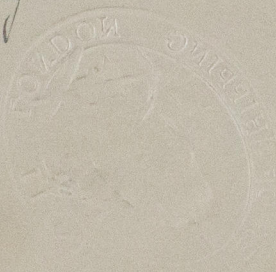

W/106-0045

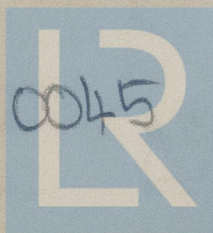

© 2021

Lloyd's Register  
Foundation