

Nº 626

DECK PLANS.

FLY TO PLANS ALREADY SUBMITTED.

DIMENSIONS: LENGTH B.P. 385'-0" x BREADTH MLD. 53'-6" x DEPTH MLD. 38'-0"




SCALE: $\frac{1}{8}" = 1 \text{ FOOT}$.

RIVETING: CLEAR OF OIL BUNKERS

1. BUTT - STITCHED PLATES $\frac{3}{8}$ " RIVETS $3\frac{1}{2}$ " DIAS. APART

IN TRANSVERSE SEAMS OF DK PLATING $\frac{3}{4}$ " RIVETS $4\frac{1}{2}$ DIAS. APART


NOTE: ALL SEAMS & BUTTS ARE SINGLE RIVETED EXCEPT
END LAPS OF STRINGER PLATE AND SEAMS & LAPS OVER
OIL BUNKERS

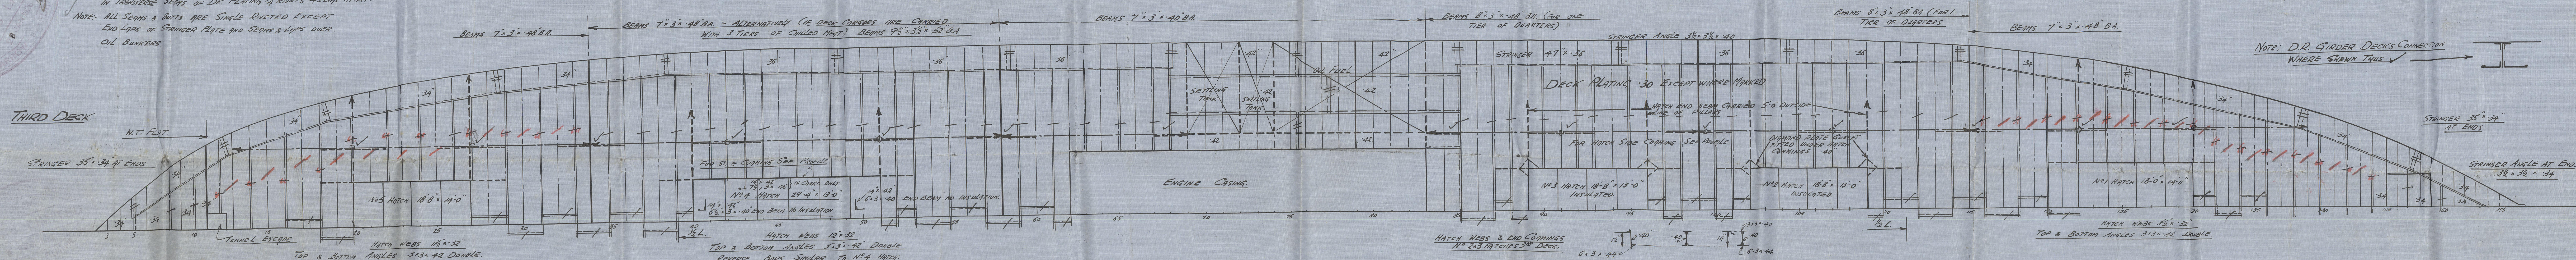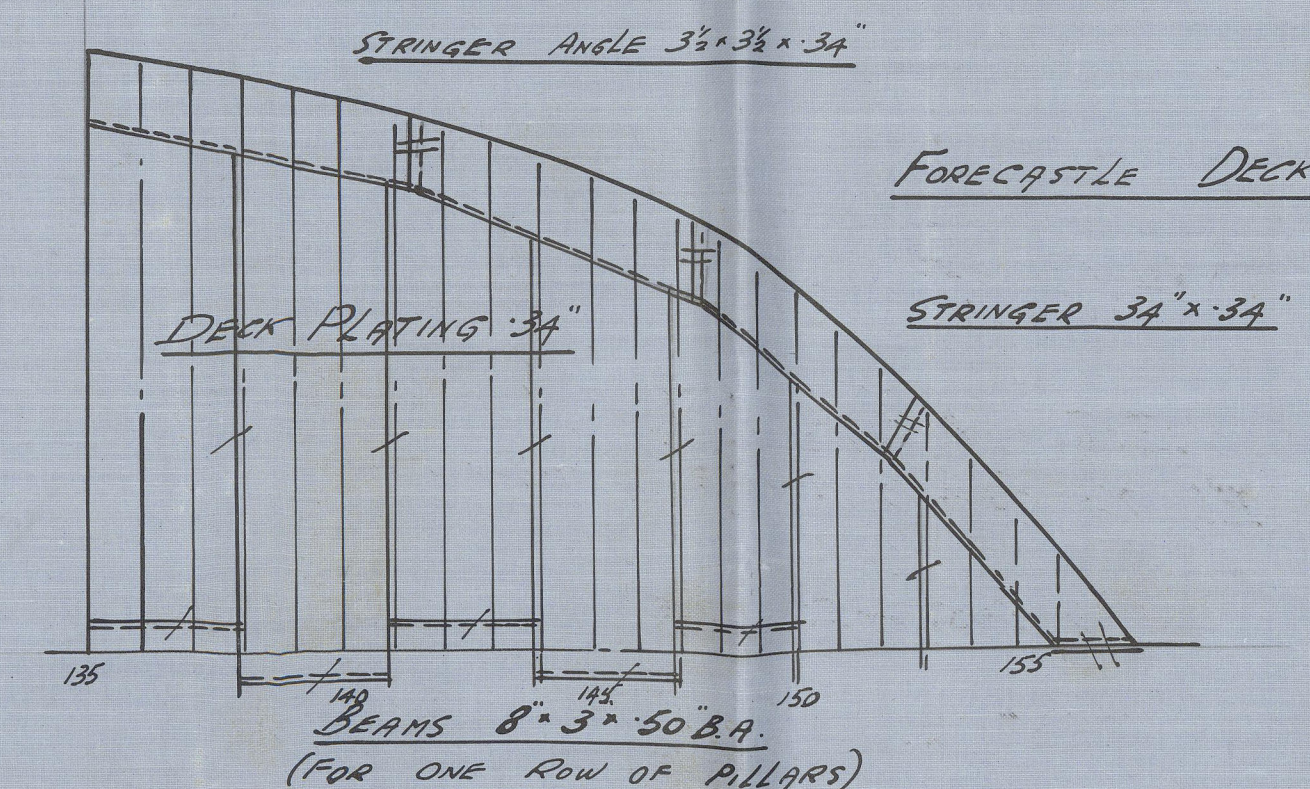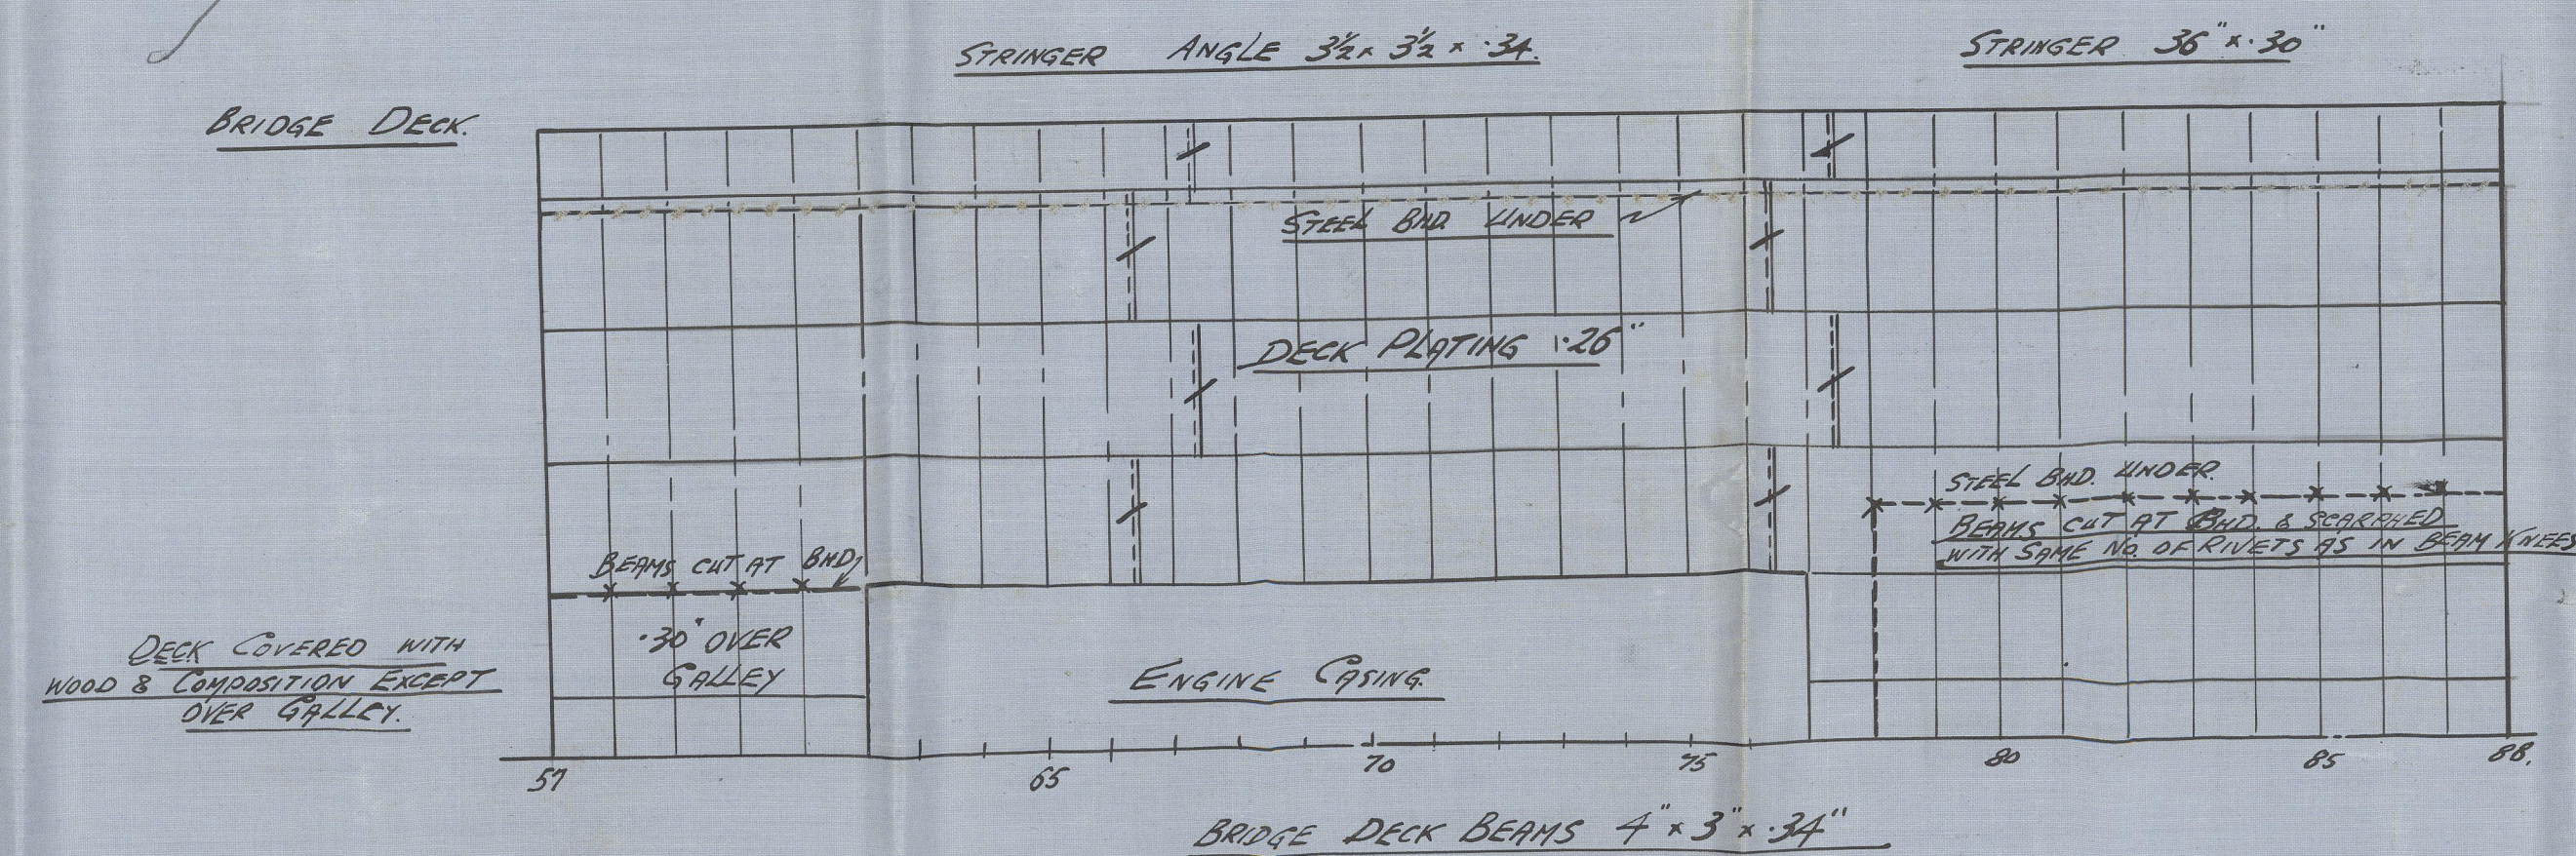

NOTE: D.R. GIRDER DECK'S CONNECTION
WHERE SHOWN THUS ✓

(ALTERNATIVELY)


HATCH WEBS TO BE AS PER TYPICAL DETAIL BELOW

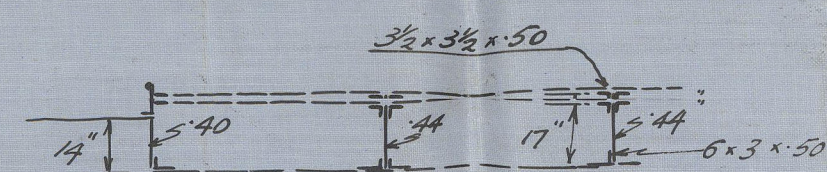

SECTION THRU HATCH WEBS - NO. 4 HATCH ON 3RD DECK.

SIDE CORNINGS OF HATCH SHOULD EXTEND TWO FRAME SPACES BEYOND EACH HATCH END AS SHOWN.

DIAMOND CORNER PLATES
TO BE FITTED SIMILAR TO NO. 2 HATCH.

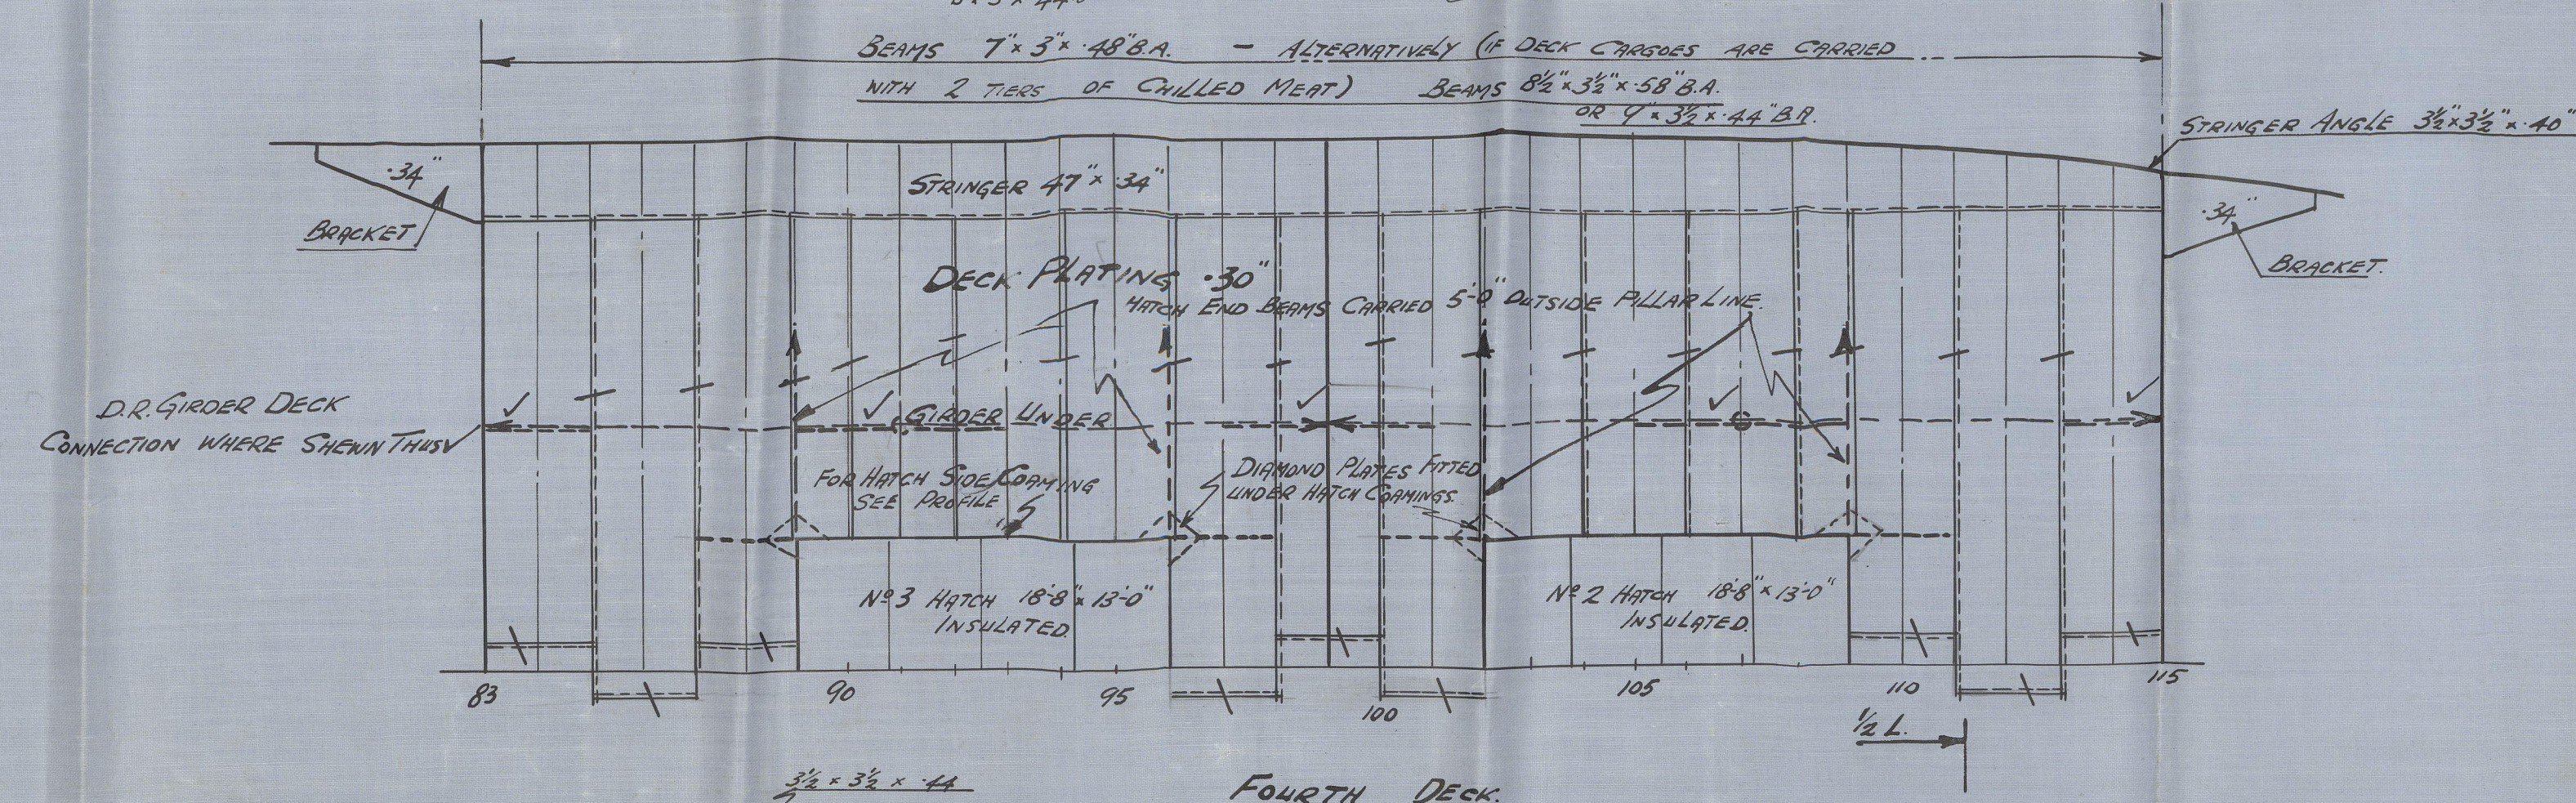

SECTION THIRD WEEBS OF N^o 283
HATCH ON FOURTH DECK.

664.
1. 2. 26

Vickers' No 626 - Modavia

3ry to Deck Plan.

Banow 1st E. Rpt No 2227

W-S 94

W 106-0216



© 2021

Lloyd's Register
Foundation