

8.1.26



N^o 626.

PROPOSED MOTOR VESSEL.

PROFILE


SCALE $\frac{1}{8}$ " = 1 FOOT.

DIMENSIONS:- 385'-0" x 53'-6" x 38'-0"

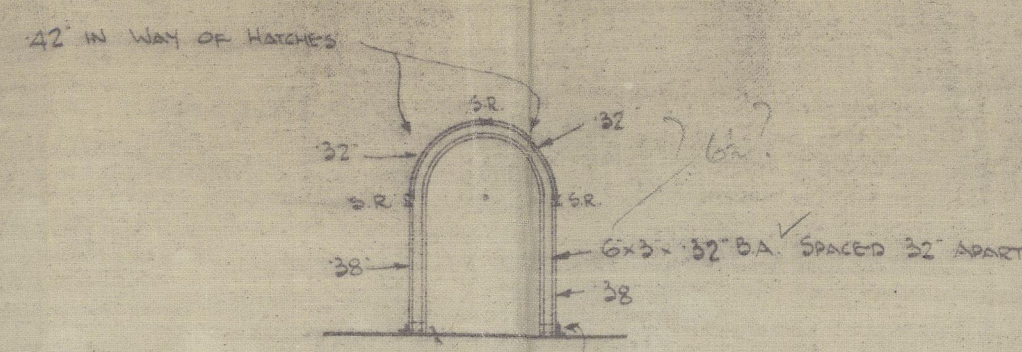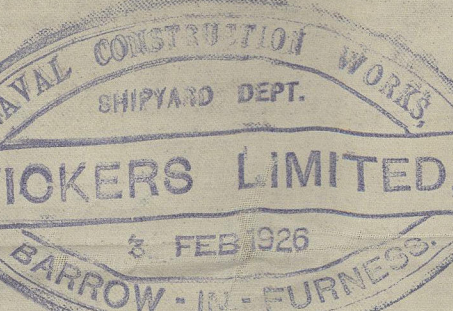

WINDLASSES, WINCHES, MASTS AND STEERING GEAR SUPPORTED TO SURVEYOR'S SATISFACTION.

In upper tween decks having 7'3" x 4'4" B.A. with 5'3" x 3'3" intermediate or alternatively 5'3" x 3'3" + 4'1" B.A. frames in every (section 6 clause 3 para c)

 

24" = 48" U.L.S.
21" = 84" U.L.S.

W.L. 1
38 1/2' U.L.S.
T.E.S.

Hickens Ltd. nos. 626. MODAŮIA

Amended Profile

Canon F. E. Rpt No 2227

W.S. 94

W 106 - 0217



© 2021

Lloyd's Register
Foundation