




ELEV. LOOKING TO PORT
STARBOARD SIDE SIMILAR

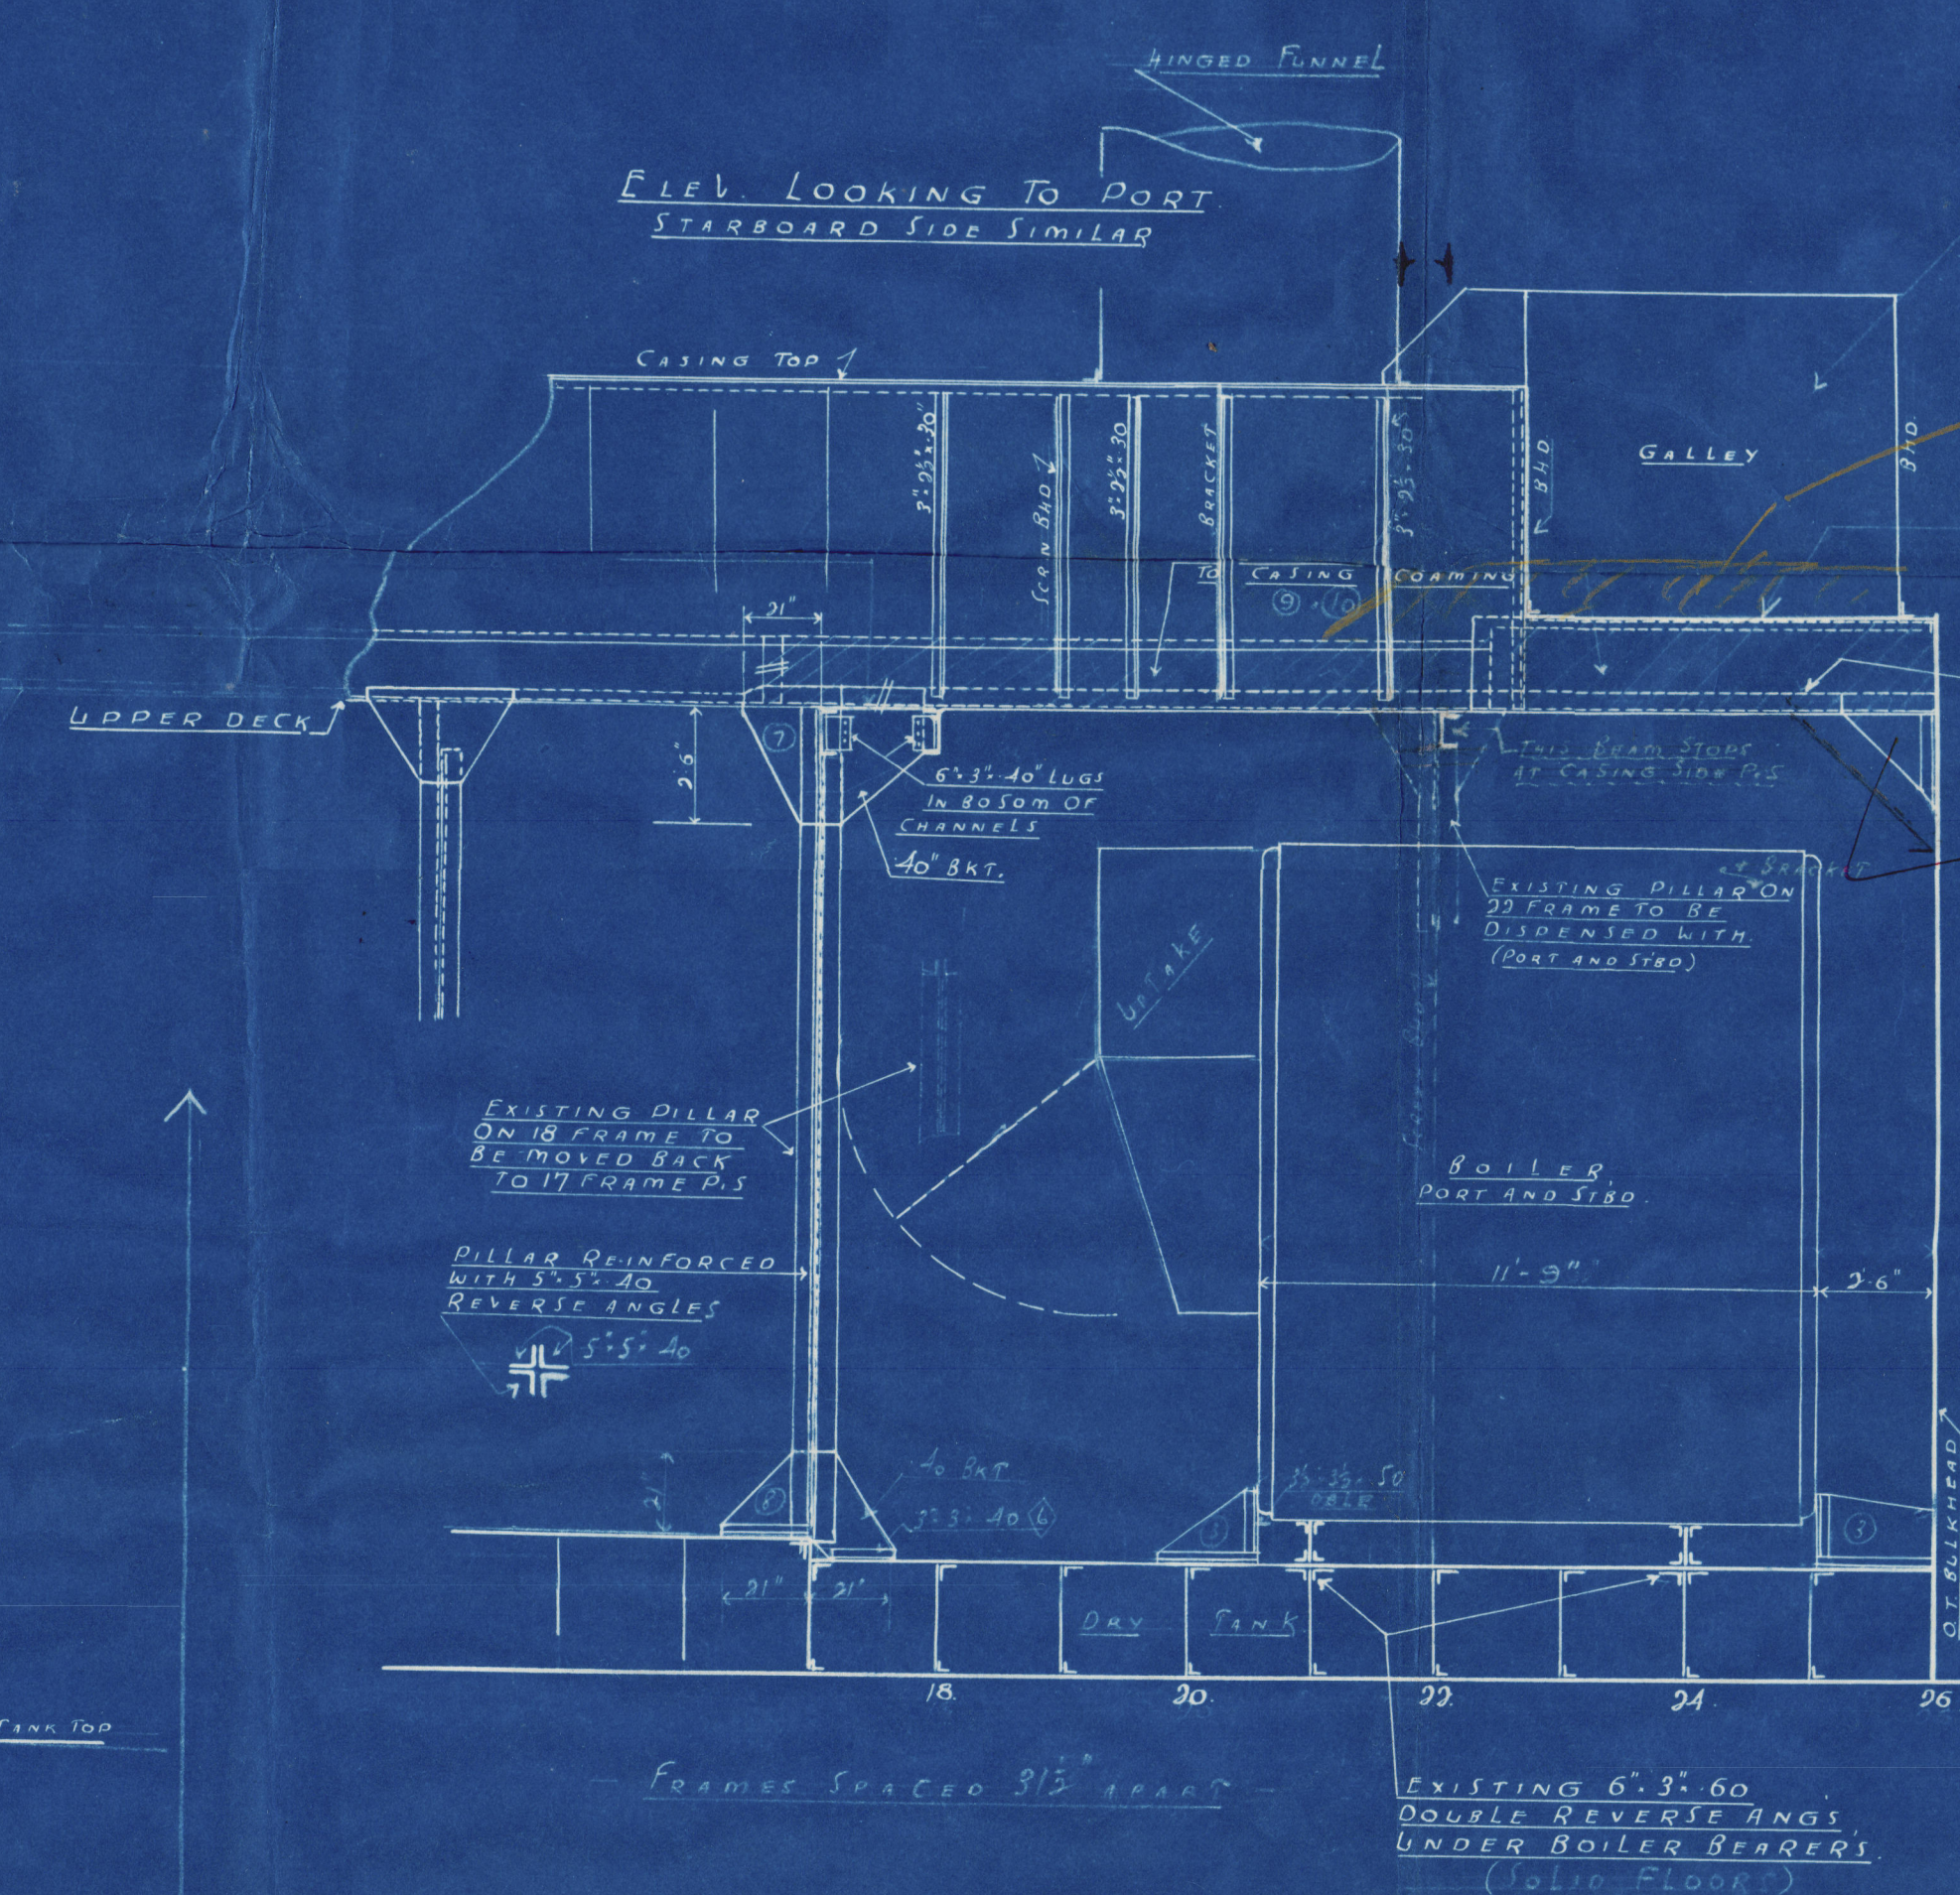

S.S. STANASFALT.

MODIFICATIONS TO E. B.
CASING, PILLARS & BOILER
STOOLS.

SCALE $\frac{1}{4}'' = 1$ FOOT


S. S. STANASFALT

MODIFICATION TO E & B CASINGS,

PILLARS ETC

FOR FITTING

2nd BOILER

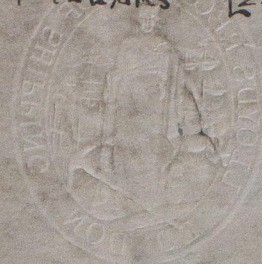

18

W1060-0204

Boiler

Stanasfalt.



© 2020

Lloyd's Register
Foundation