

'AS FITTED' PLAN PREPARED BY SURVEYOR

T.S.M. CORADY. EX LCI. 288.



150' x 23' x 11'-6"

CONVERSION DETAILS. FOR SERVICE W. INDIAN ARCH.


SCALE $\frac{1}{4}$ " / 1 FOOT

FOR DETAILS OF SHIP AS BUILT SEE PLAN BAG

DRAUGHT. 8'-6. ALL SEASONS.

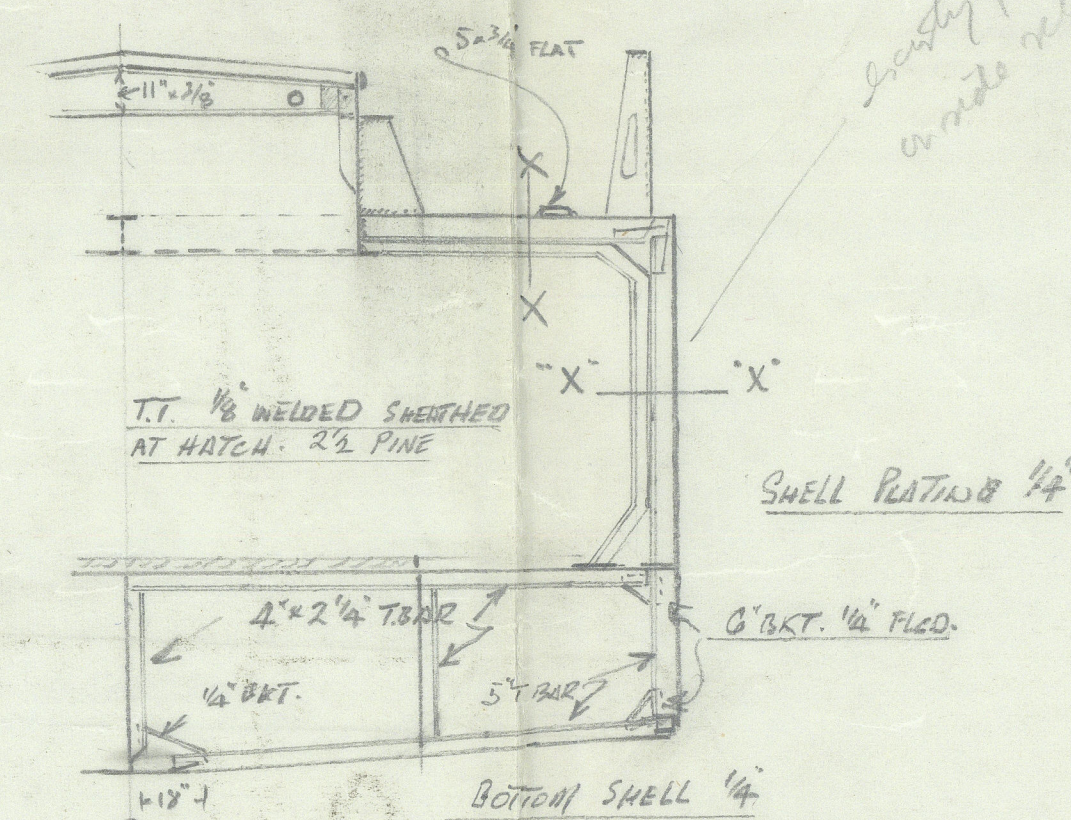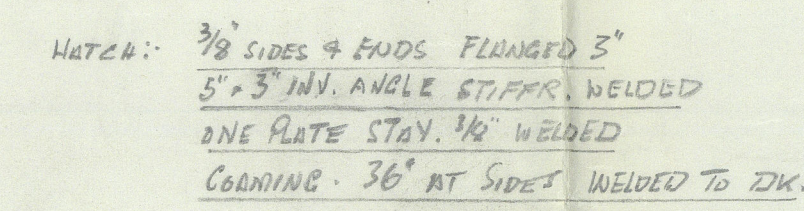

MIDSHIP SECTION

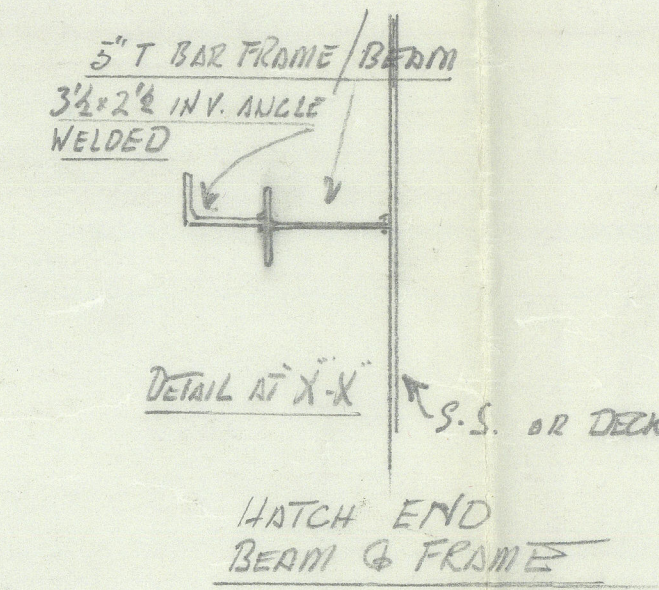







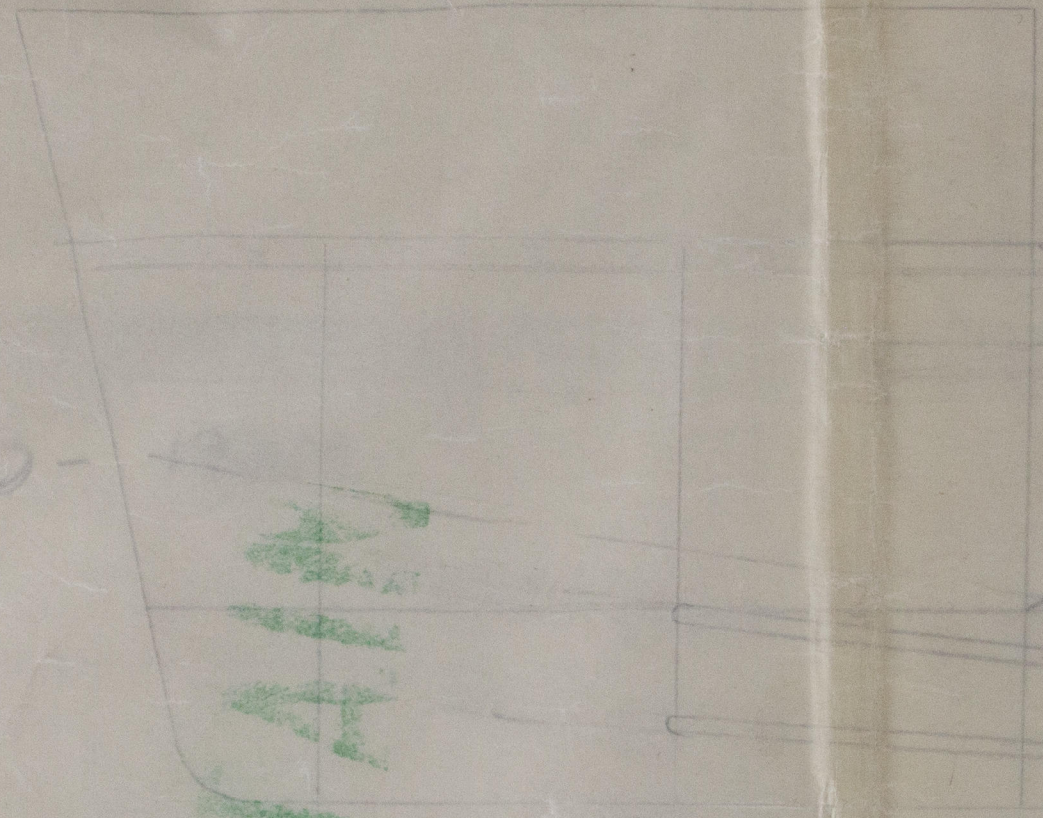


Bay

2.000 CUBIC FT. OF
SPACE 8' x 4' x 8'
NEEDED TO
FORD CARGO COMP.

RL



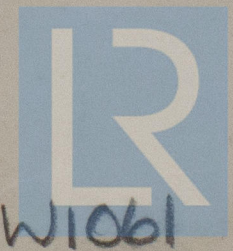

© 2020

Lloyd's Register
Foundation

W1061

0062