


Scale: $\frac{1}{8}'' = 1\text{ft.}$

Rule Dimensions 402'-0" on L.W.L. \times 52'-25" Mid. \times 29'-83" Mid. to Upper Deck.

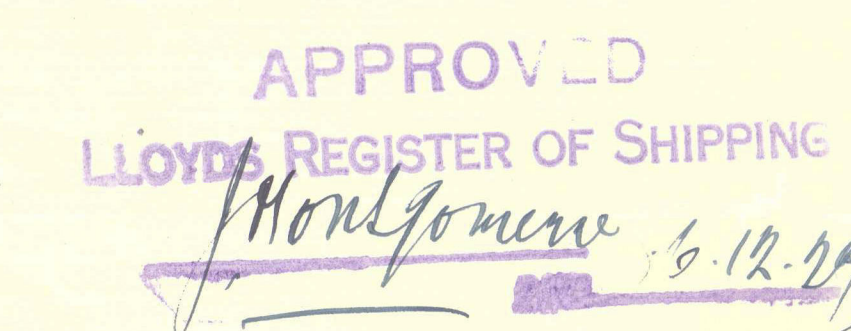

ROBT. DUNCAN & Co

Nº 386

PROFILE & DECK PLANS

386

S. S. "Yamislav"
Cannock Report Nº 18965.

RETAIN

W1061-0202

Lloyds.



© 2020

Lloyd's Register
Foundation