


WORKING PRESSURE 200 LBS.  
TEST 400  
NOTE. ALL PLATES STATS OF STEEL EXCEPT C. CHAMBER STAYS  
WHICH ARE MADE OF IRON.  
TENSILE STRENGTH OF SHELL PLATES AND BUTT STRAPS.  
TO BE NOT LESS THAN 29 TONS PER SQ INCH.  
ALL HOLES DRILLED IN PLACE AFTER PLATES ARE BENT.



= IRON SCREENED STAYS THUS  $\circ 2$  Dia (6 THREADS) -  
 = ALL OTHERS OF IRON  $1\frac{3}{4}$  Dia (9 THREADS) -  
 = NOTE. ALL STAYS SCREENED AND FITTED WITH NUTS.  
 = 1. THUS, =  
 = 1. OPPOSITE HAND - CONTRA

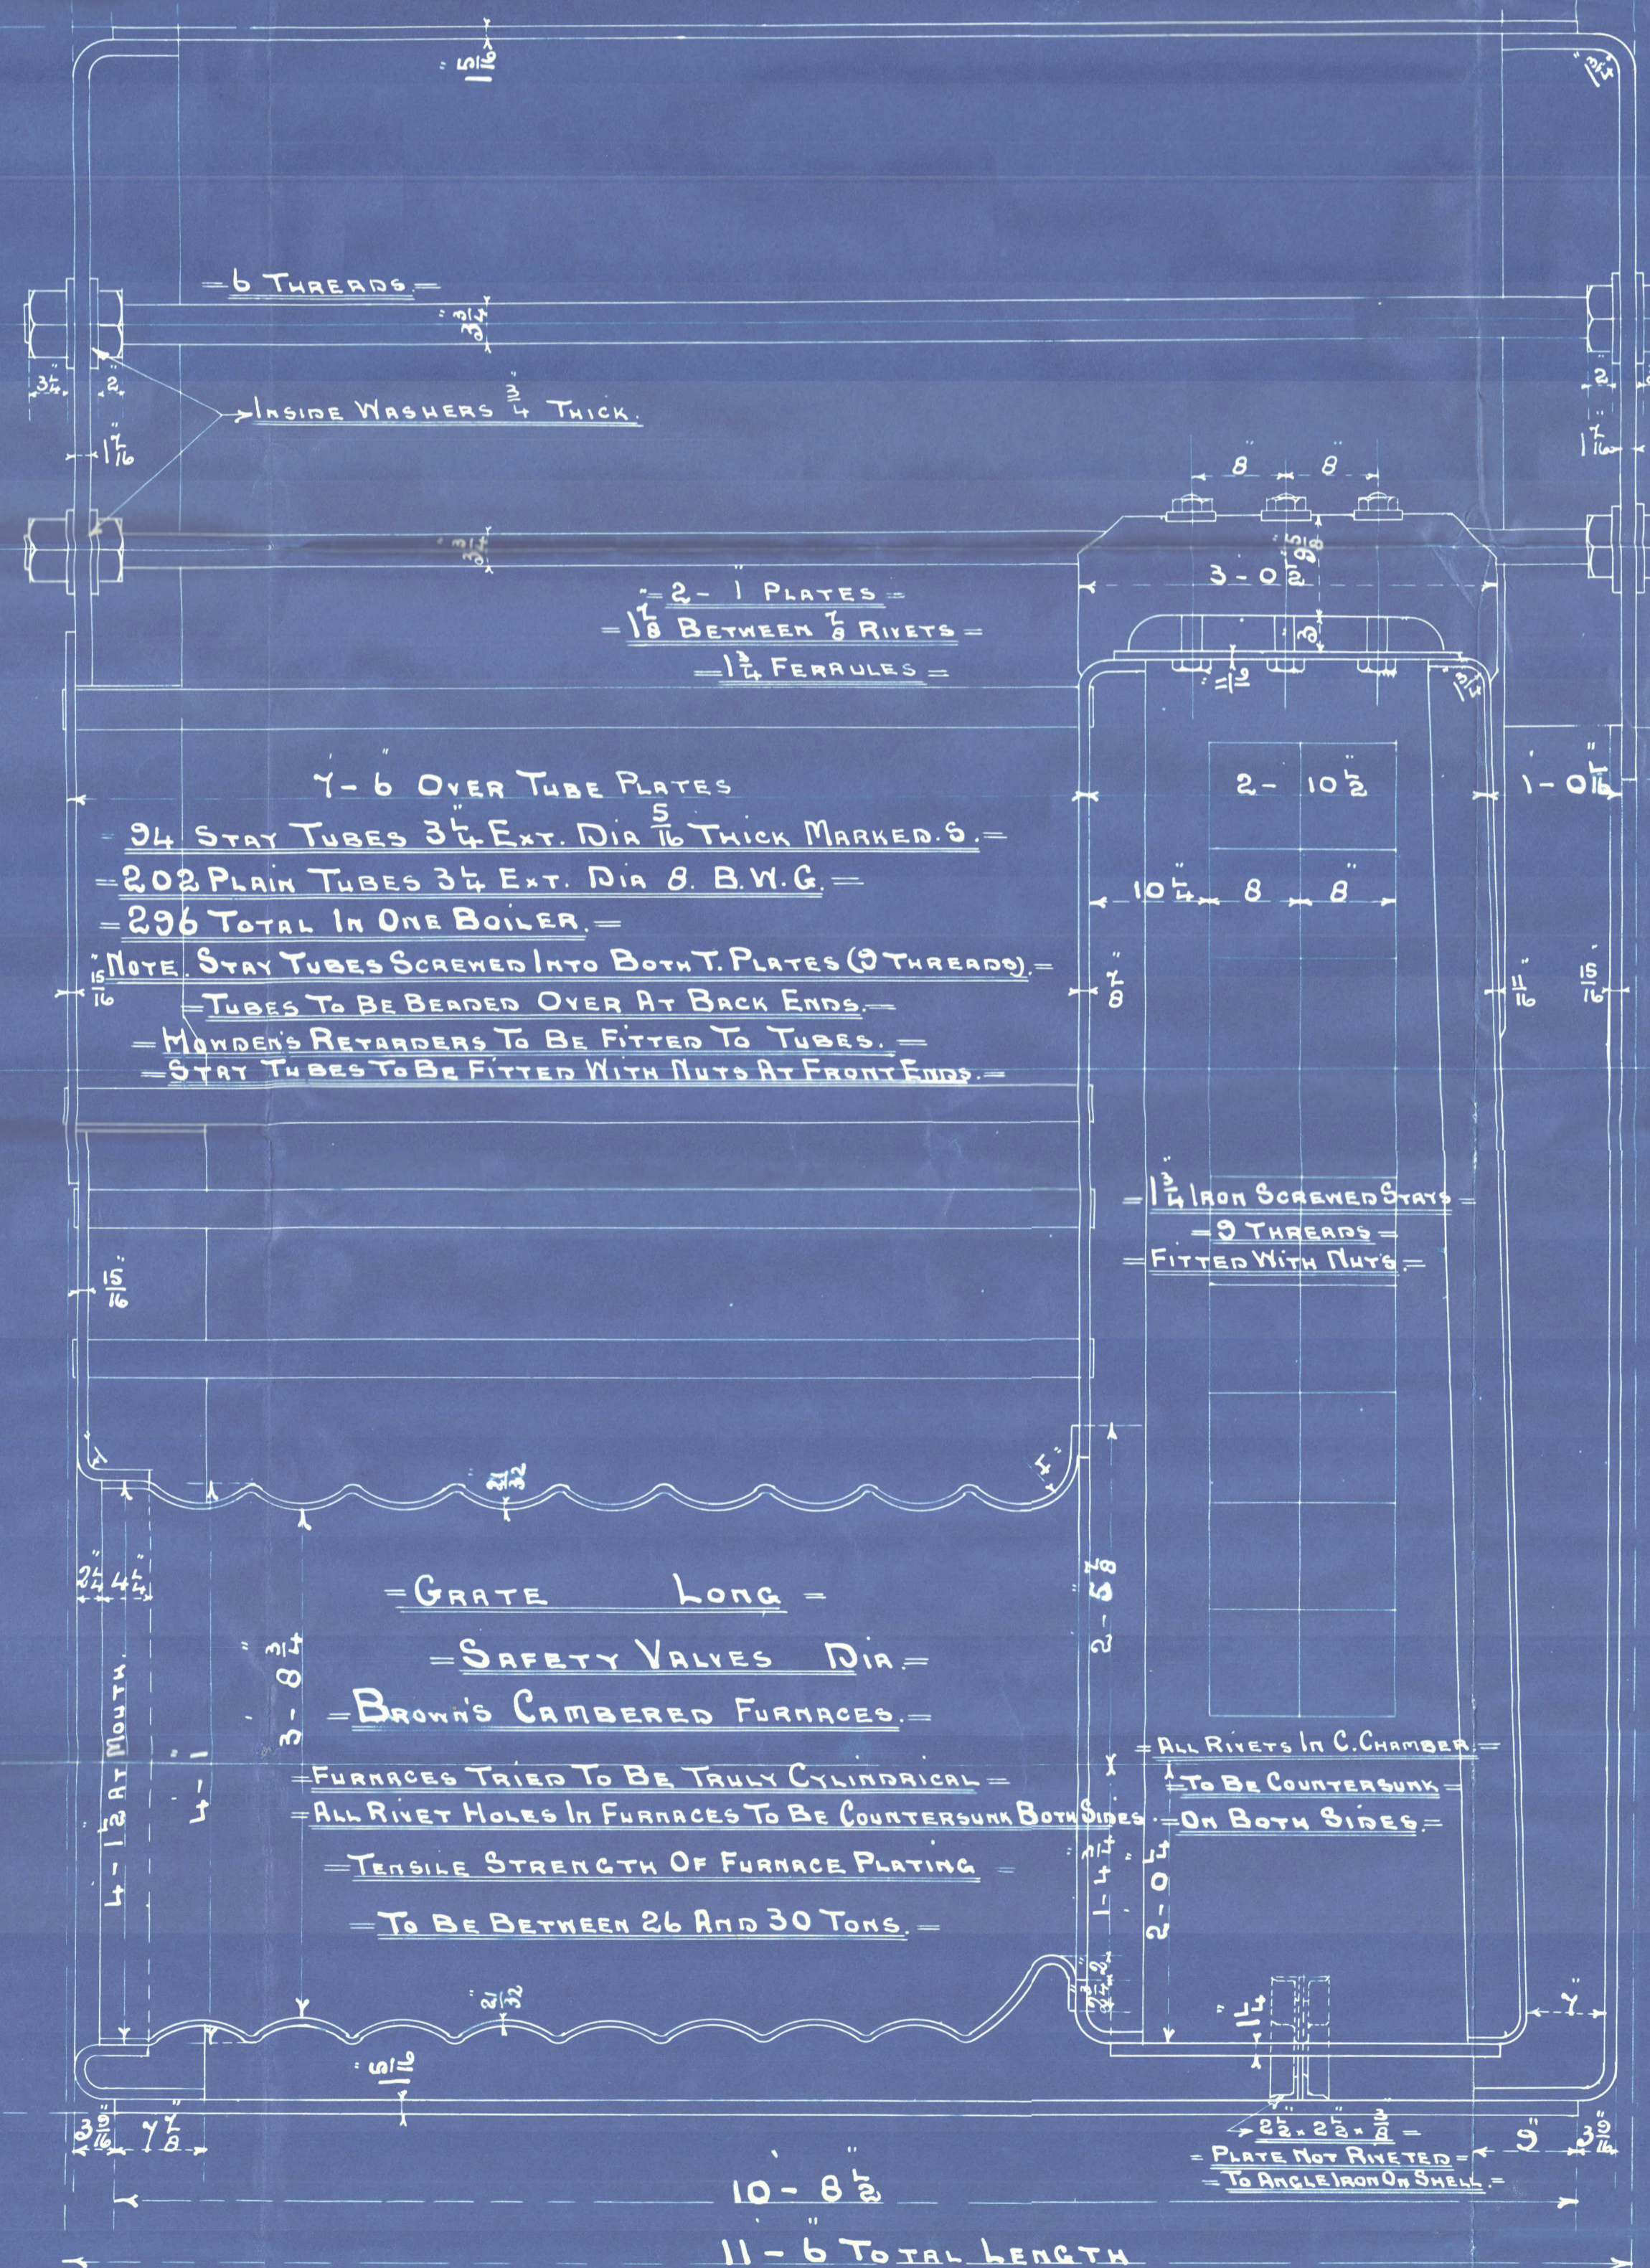

North Eastern Marine

Nº 1397

Gobson & Co Nº 121

2SE

WP 200%

Sts Duna

W. 6351  
Lloyds List  
400 lbs  
G. A. H.  
20. 6. 02

S. S. Duna

Newcastle Report

Nº 214003

RECEIVED

W1061-0230



© 2020

Lloyd's Register  
Foundation