

PRINCIPAL DIMENSIONS

LENGTH BETWEEN LLOYD'S PERP: 150'-0"
 BREADTH MOULDED = 36'-0"
 DEPTH " = 18'-0"

GENERAL ARRANGEMENT.


S.S. N° 494.

SCALE 1/8"=1'.

SCHEEPSWERF VOORHEEN JAN SMIT CO.

ALBLASSERDAM

HOLLAND

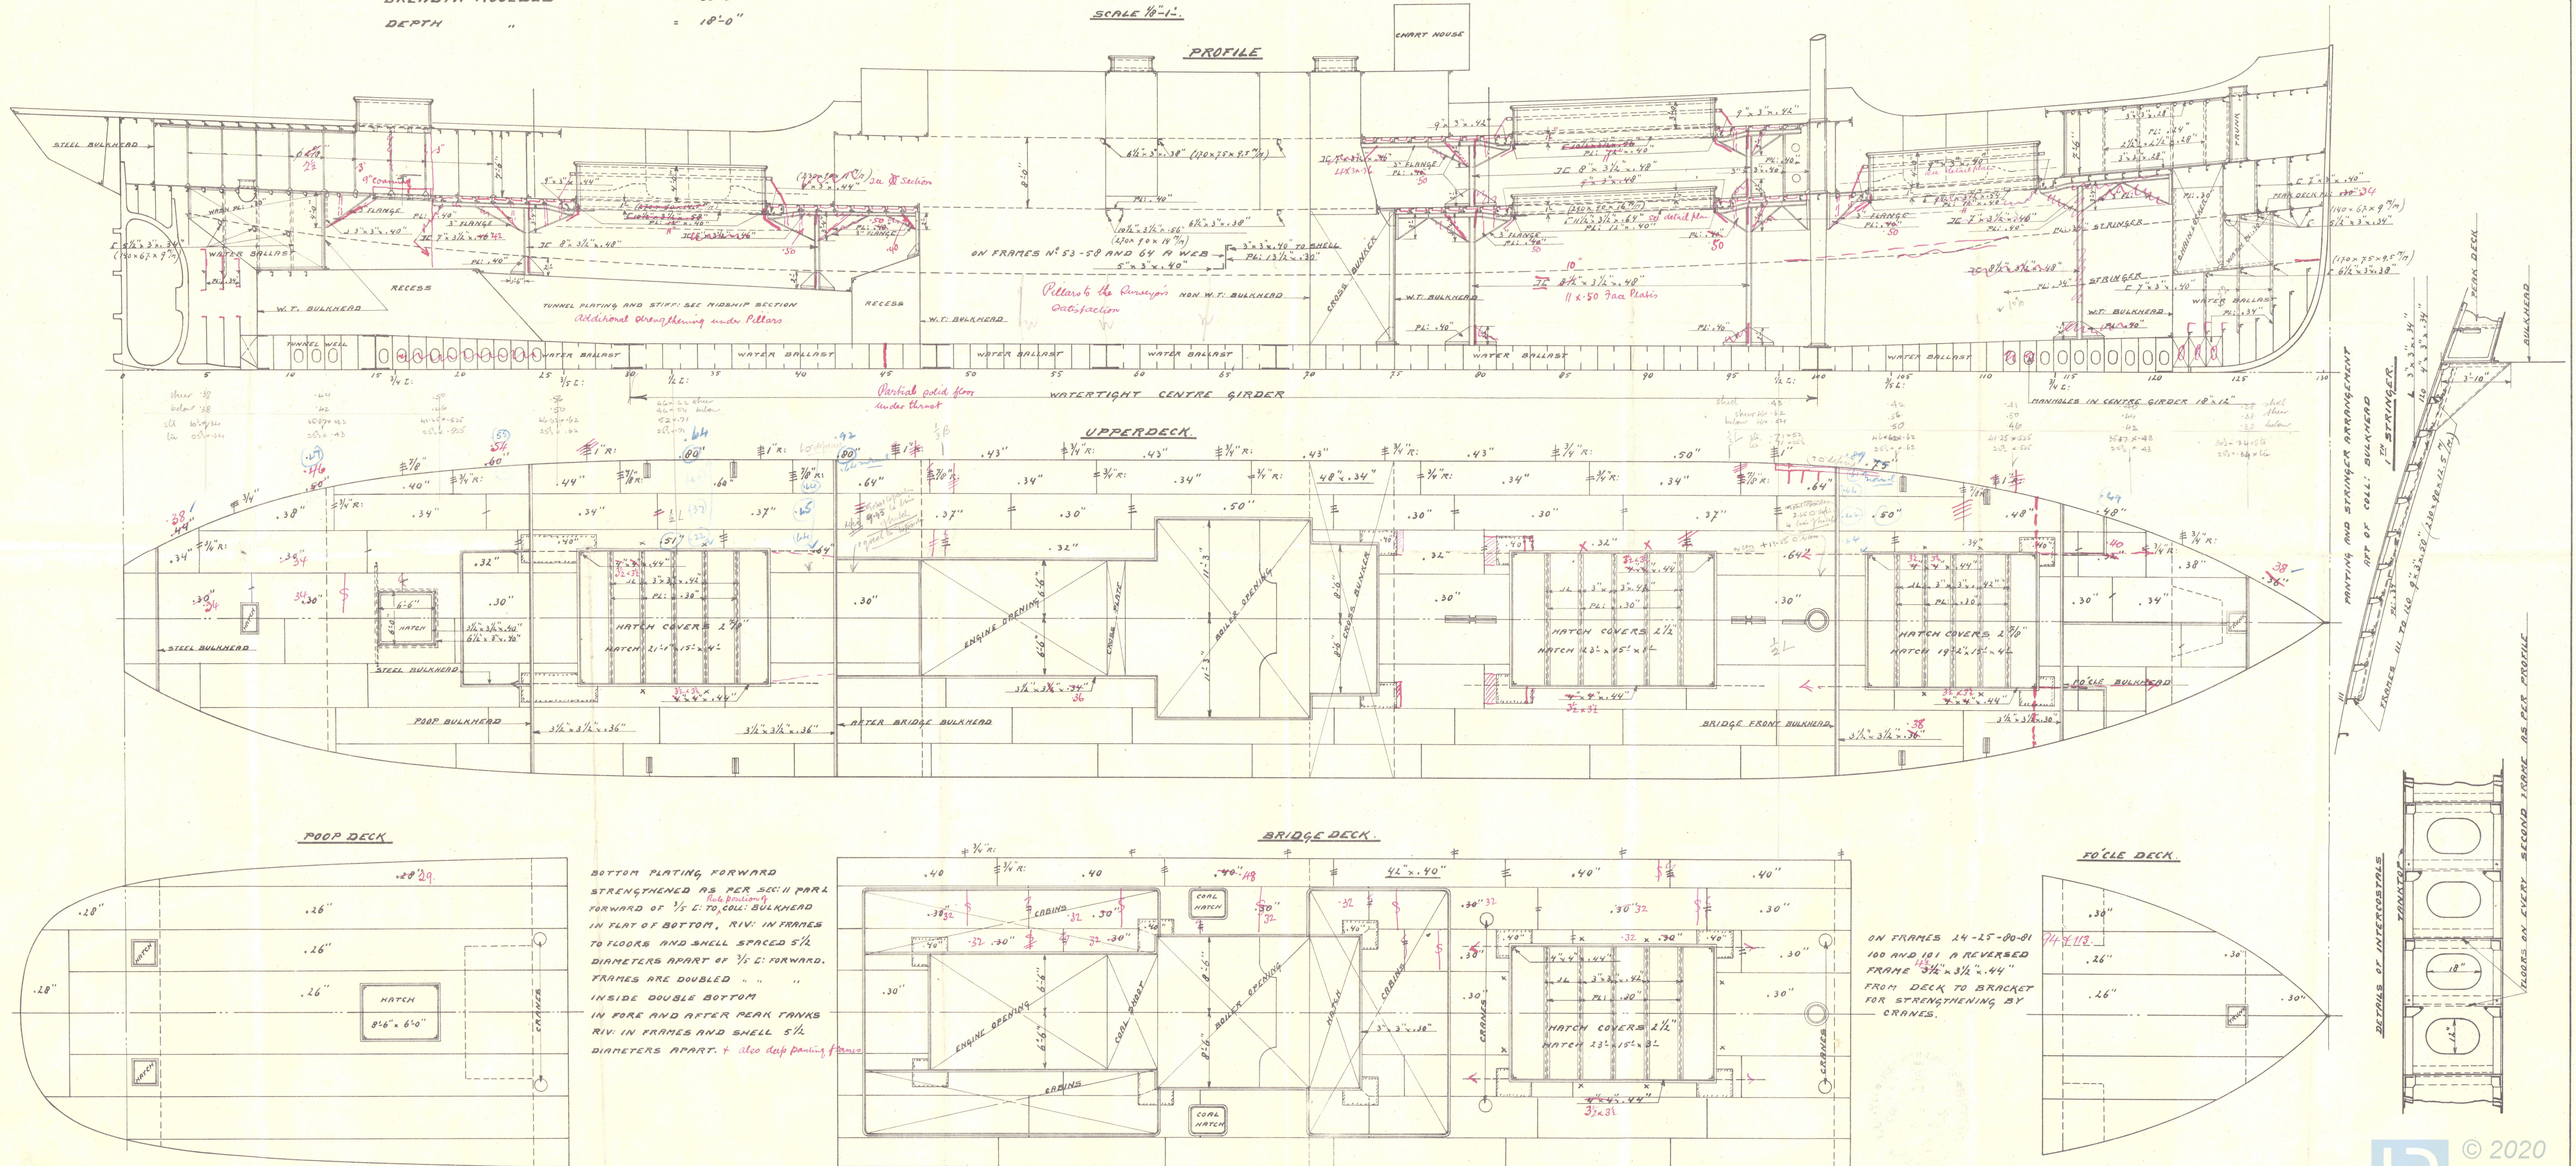

Scheepswerf v/h Jan Smit b.z.


Yard No 494

Profile & Decks

S Westland

Gen. Box 730

RETAIN

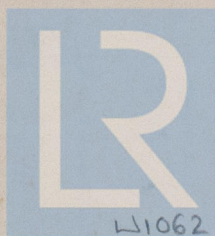

© 2020

Lloyd's Register
Foundation

L1062-0229