

# PROFILE & LCK PLANS OF A PROPOSED STEEL SCREW VESSEL




TO CLASS 100 A. 1. AT LLOYDS.

DIMENSIONS:- 185'-0" x 30'-4" x 13'-3" M<sup>LD</sup>

SCALE 1/8" = 1 FOOT.

No. 574

HATCH COAMINGS. THUS:-

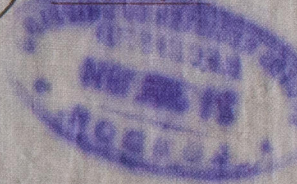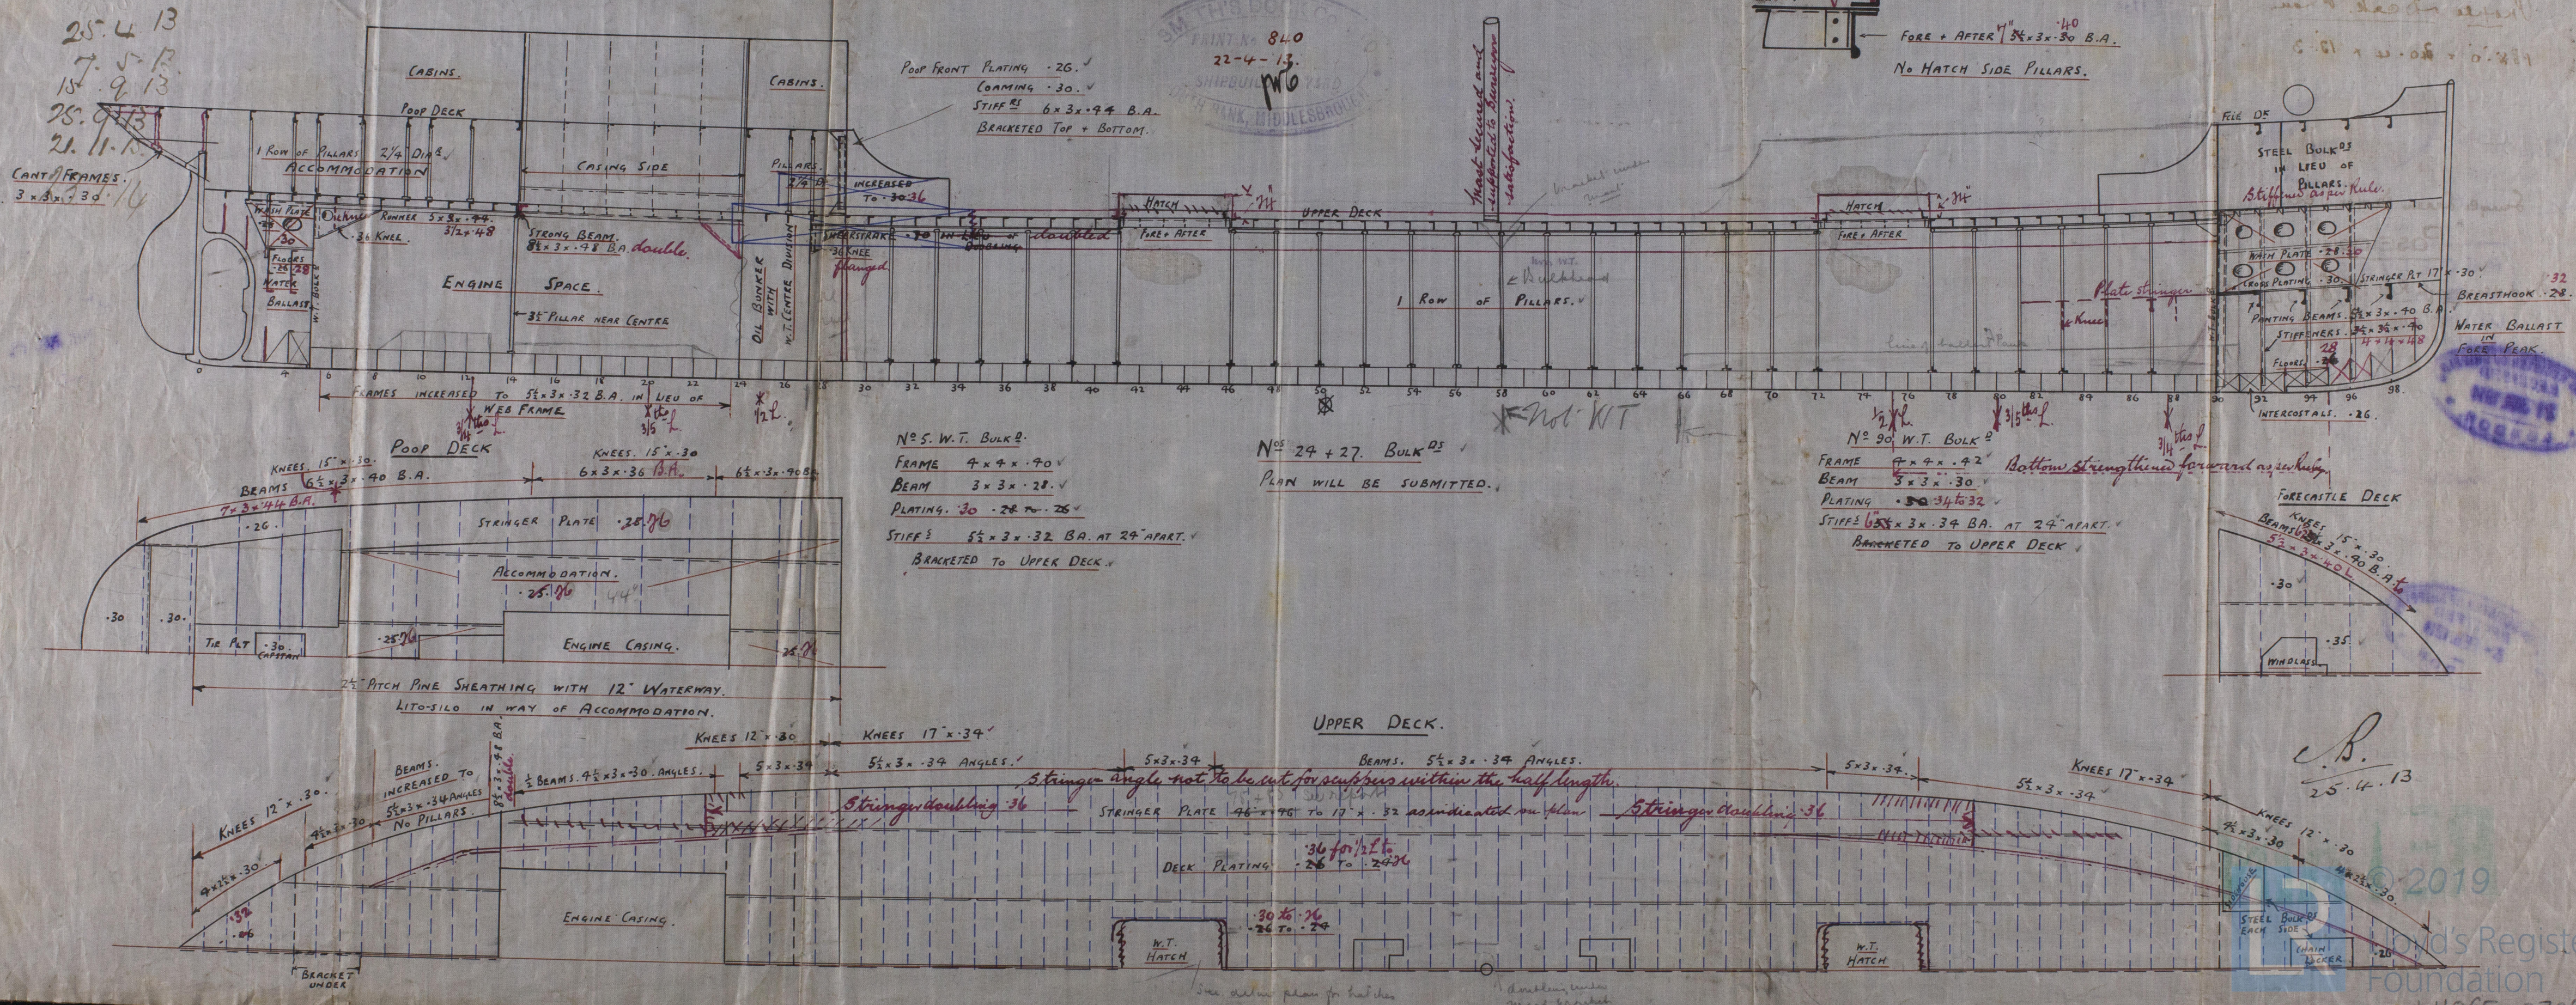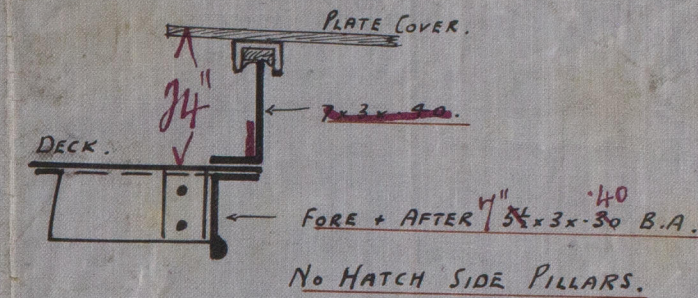



HATCH CO

Head Smith Dock Co<sup>d</sup>

No. 574


Profile and Deck Plan

188'0" x 20'4" x 13'3"

Single Screw Motor Vessel

"POSEIDON"

Middlesbrough Reg No 8454.

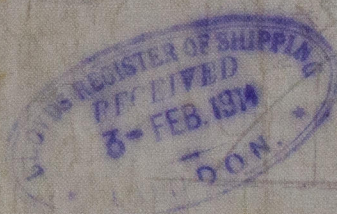

RETAIN



© 2019

Lloyd's Register  
Foundation

W1065-0206