


DIMENSIONS: 127'-0" BP x 23'-0" B. MLD. x 12'-9" D. MLD. AMIDSHIPS.

1955 573 ----- 1956 26

1 BOWIE ANCHOR 7 CWT. STOCKLESS
1 BOWIE ANCHOR 6 1/2 CWT STOCKLESS
1 STREAM ANCHOR 1 3/4 CWT EX STOCK
1 KEDGE ANCHOR 90 LBS EX STOCK
150 FATHOMS ¹⁴/₁₆ STUD LINK CHAIN CABLE
45 FATHOMS ⁹/₁₆ STUD LINK STREAM CHAIN
75 FATHOMS ⁶/₁₂ MANILLA TOW LINE
90 FATHOMS 4 1/2 MANILLA WARP

LENGTH OVERALL	133.25
LENGTH FOR NUMERALS (133.25 x 96%)	127.9
BREADTH	23.0
DEPTH	13.25
HALF GIRTH	21.33
BILGE DIAGONAL	14.7

BUTTS OF SHEERSTAKE TREBLE RIVETED STRAPS ALL FORE & AFT.
REMAINDER OF SHELL BUTTS DOUBLE RIVETED STRAPS ALL FORE & AFT.
BUTTS OF ALL DECK STRINGER & TIE PLATES DOUBLE RIVETED STRAPS.
BUTTS OF CENTRE KEELSON TREBLE RIVETED LAPS.
BUTTS OF FLOOR PLATES TREBLE RIVETED LAPS.
BUTTS & SEAMS OF OIL FUEL BUNKERS DOUBLE RIVETED LAPS.
SEAMS OF SHELL PLATING DOUBLE RIVETED LAPS.
SEAMS OF DECK PLATING SINGLE RIVETED LAPS.

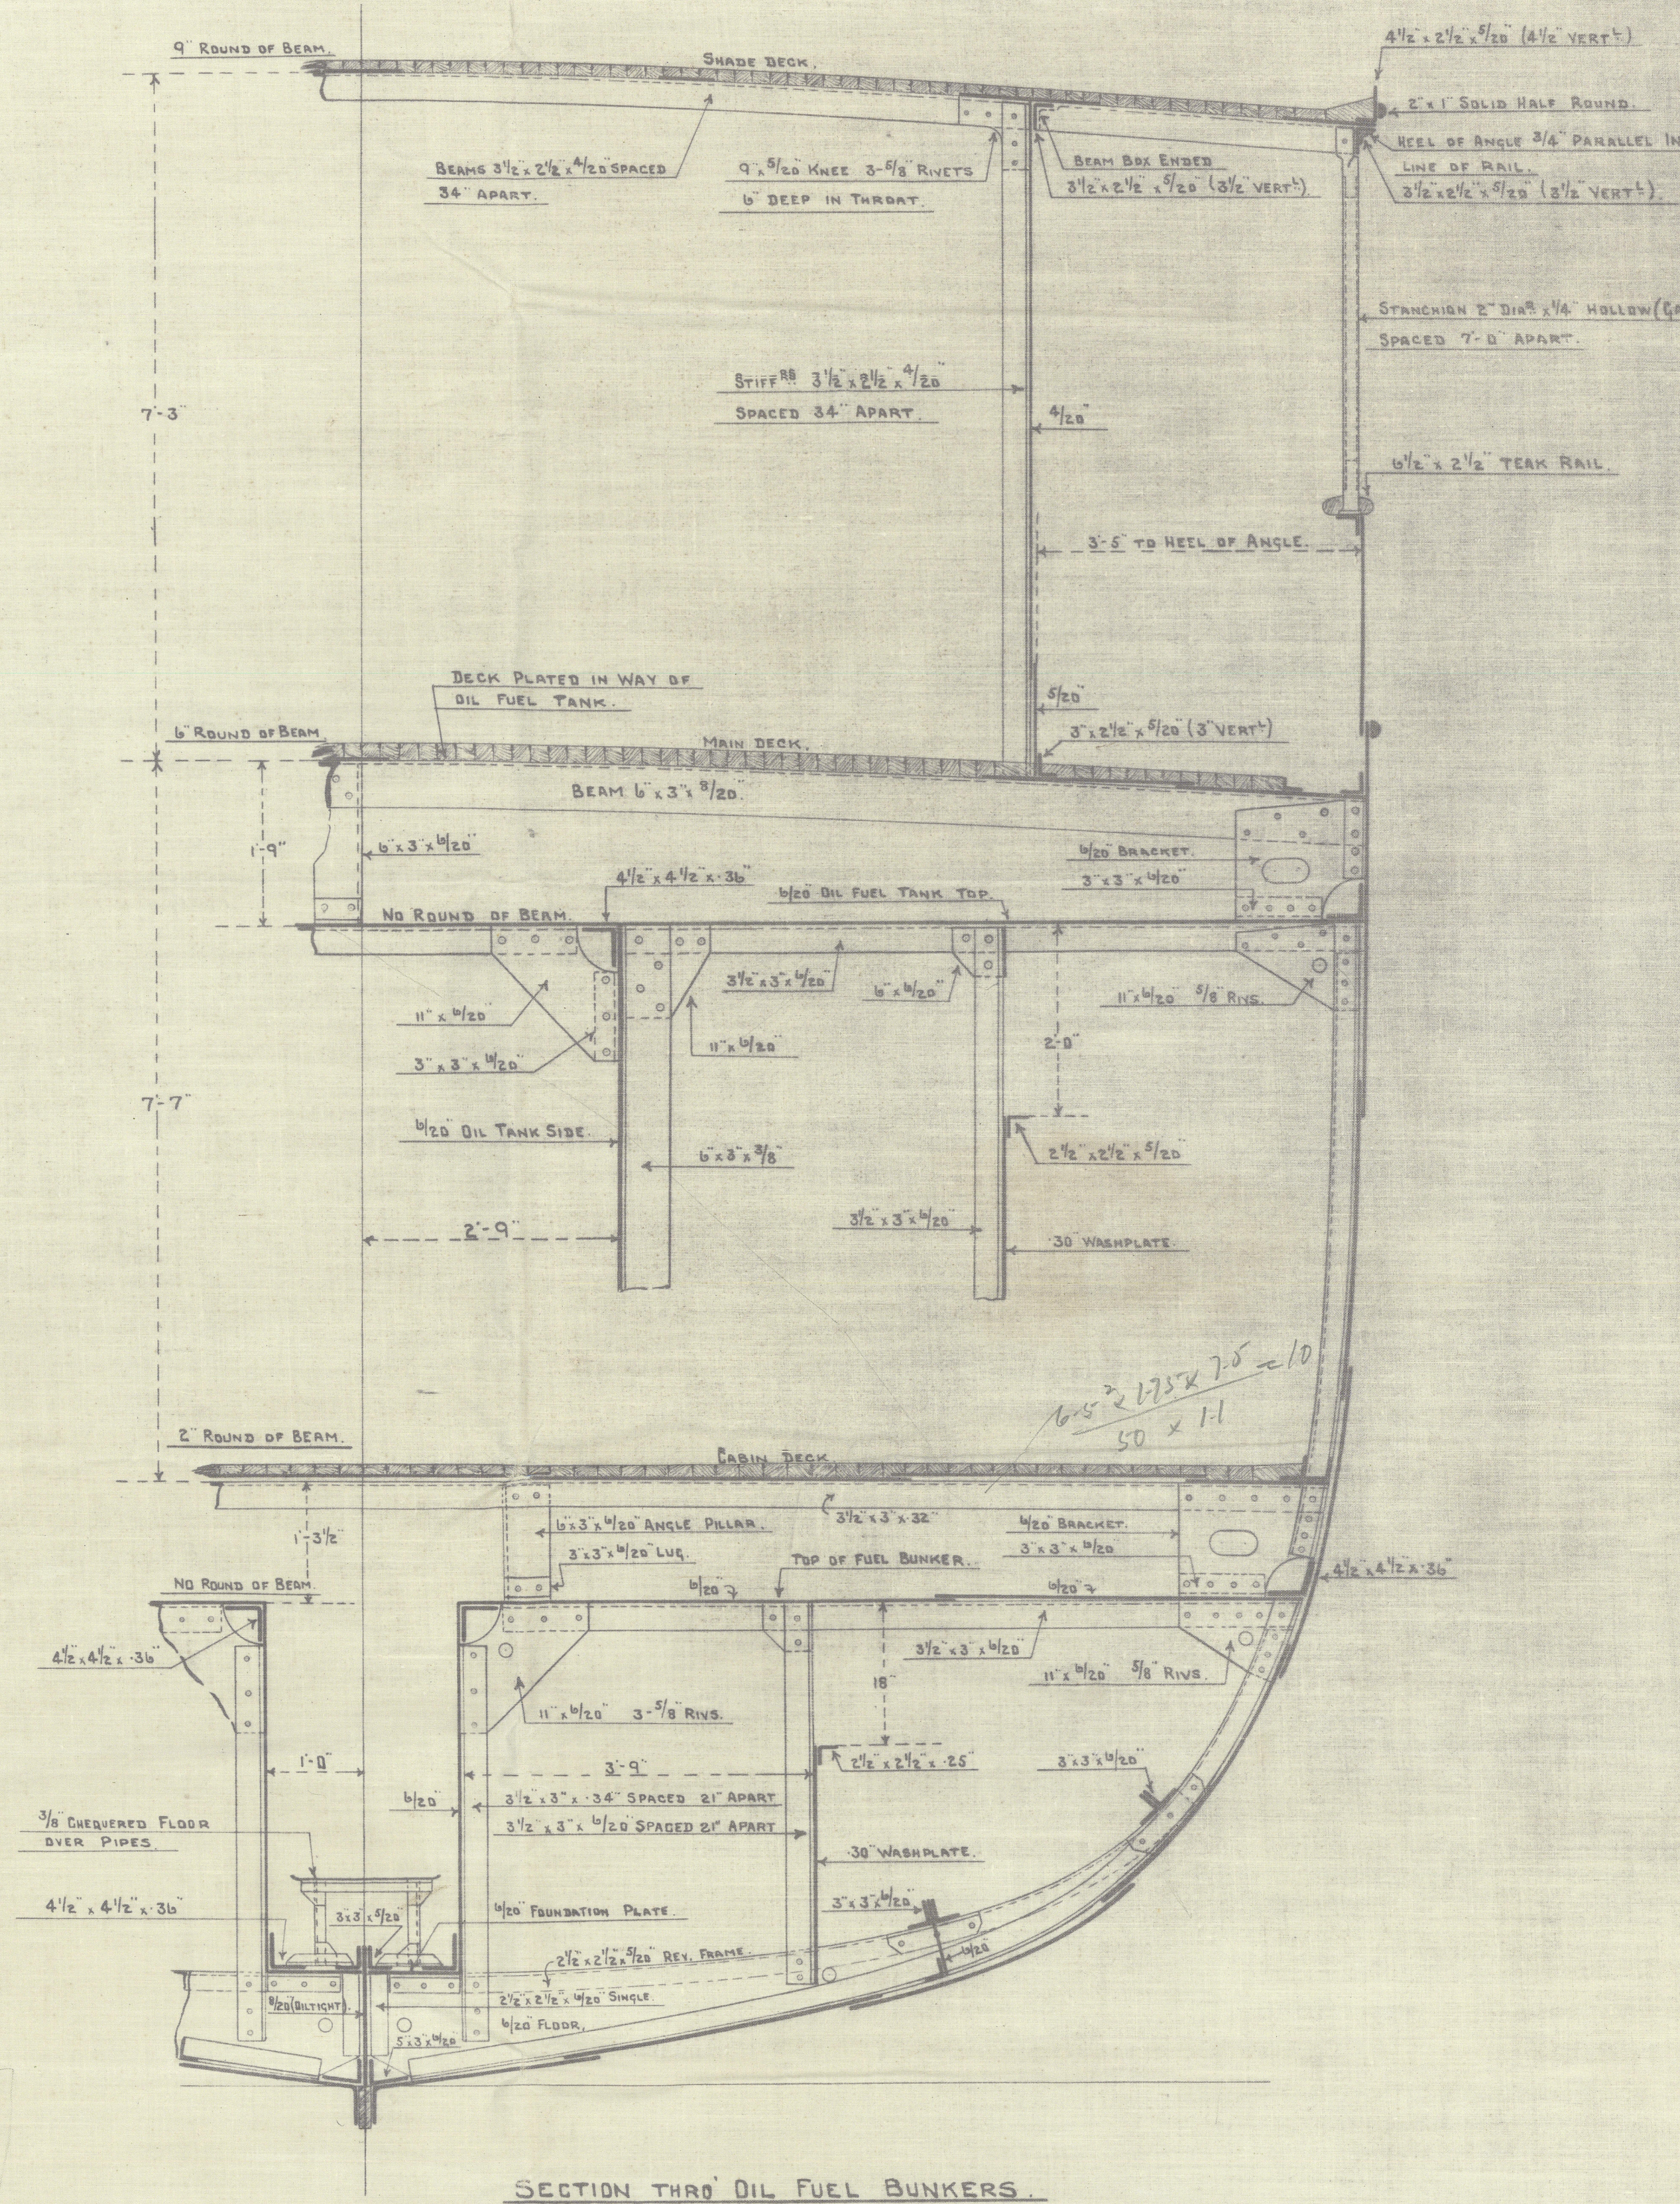

SECTIONS THRD ENGINE SPACE.

Twin Screw Diesel Yacht "CHELSEA."

Midship Section as built.

GLASGOW REPORT No 45791

RETAIN



© 2020

Lloyd's Register
Foundation

W1066-0034