


6 HOLES BORED $1\frac{13}{16}$ " PARALLEL
AND RYMERED OUT TO SUIT.

SHAFT PINS & WEBS - STEEL

Approved.
HC 6-2-26

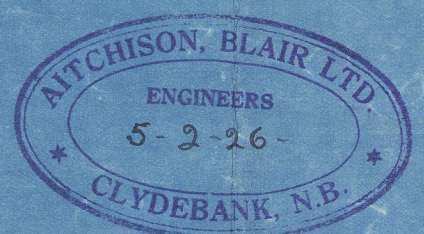

CRANK SHAFT

JOB N° 159

ENGINES

14" x 23" x 38" x 180 LBS
27"

SCALE $1\frac{1}{2}" = 1 \text{ FOOT.}$

11-2-26-

Lloyd's Register
Foundation
W1066-0169 1/2

1439.

FOR ENCLOSURE TO

LLOYD'S

From AITCHISON, BLAIR Ltd.,
CLYDEBANK.

W1065-0169 2/2

Hutchinson

63 L. air

N^o 159

& Lapping

Torrington

GLASGOW REPORT NO 45920



© 2020

Lloyd's Register
Foundation

L51066-8169 1/2