


Dr. 17.6.92
 Dr. 2.7.92
 14941

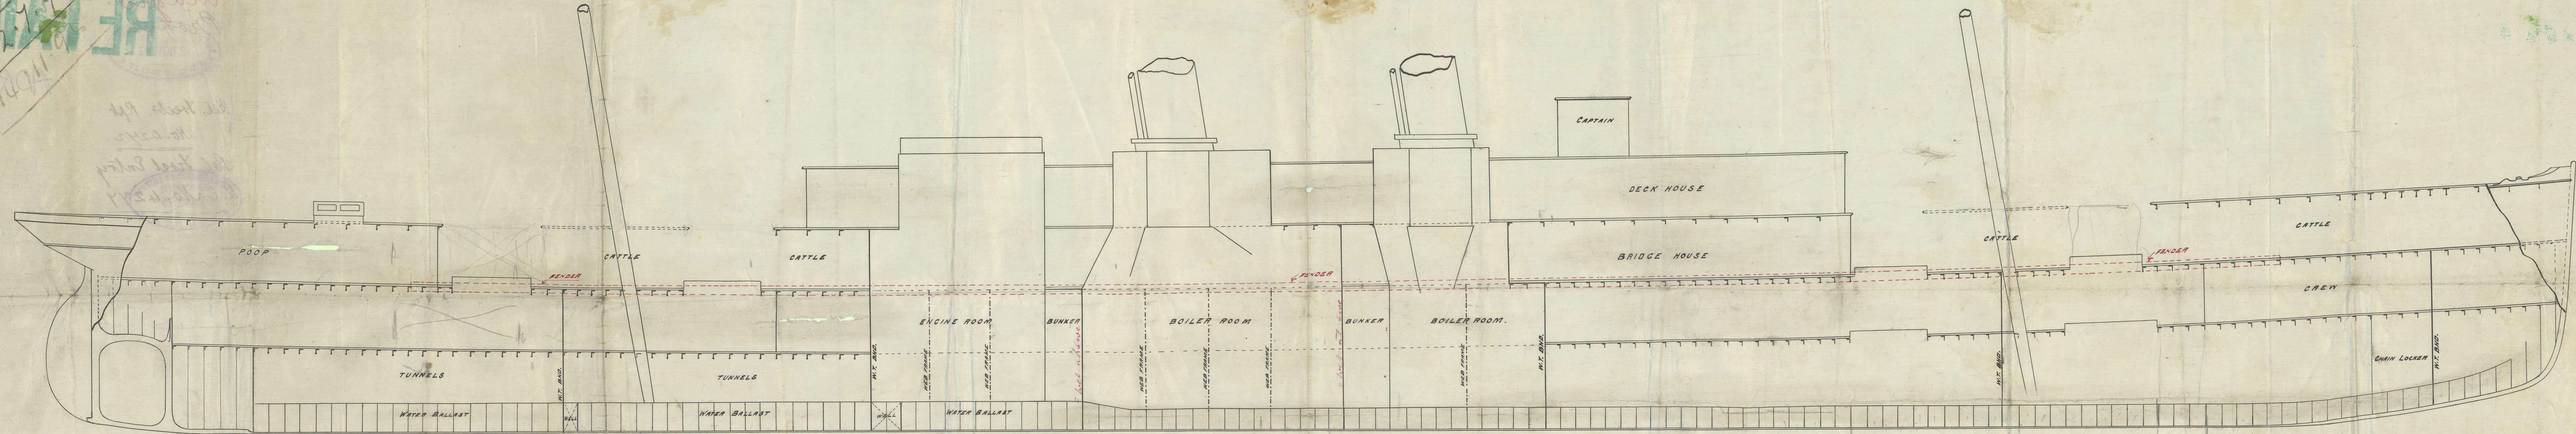

BEAMS IN ENGINE & BOILER SPACE TO SUIT MACHINERY *to suit machinery satisfactory*

SECTIONAL ELEVATION

T.S.S. 310'-0" x 38'-0" x 17'-3" (KEEL TO BEAMS).

Scale $\frac{1}{8}$ inch = one foot.

S.S. Electric
"Magic"

310 ft long
~~Electric~~
Magic

Beam & web
frames

Rel. First Entry

Rpt No 427



© 2020

Lloyd's Register
Foundation

310ft long

Magic
Propeller

RETAIN

12 NOV 1922
LONDON


ADRIAS

Rel. Treels. Rpt

No. 4242

Rel. First Entry


Rel. No. 4244

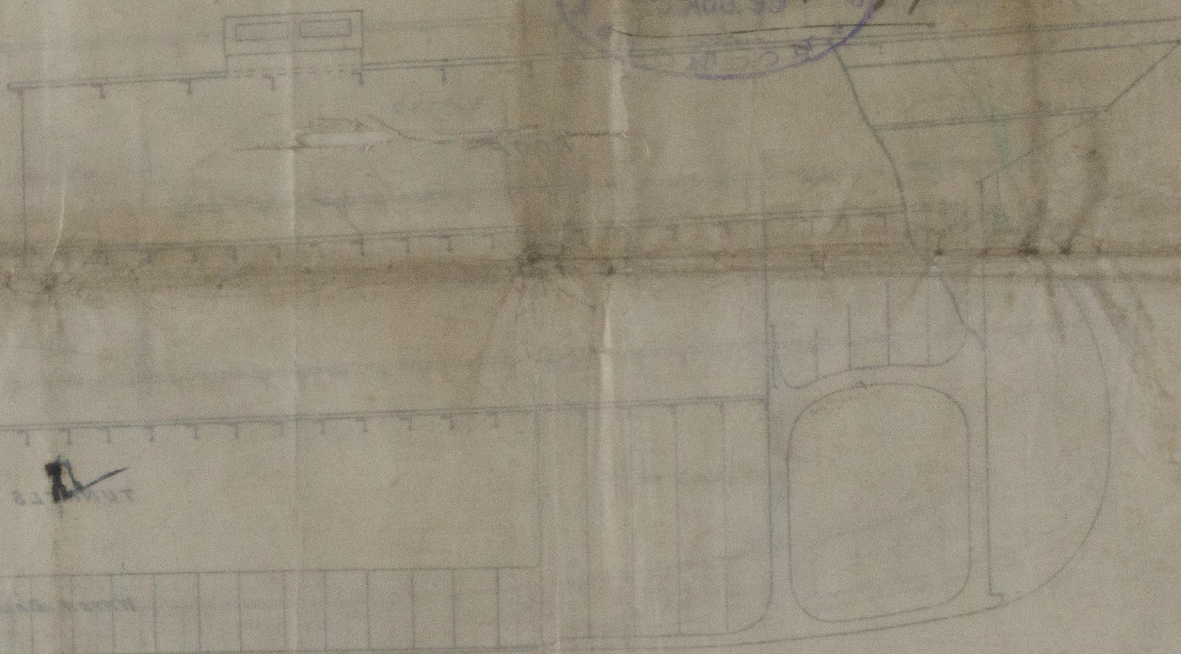

© 2020

Lloyd's Register
Foundation

new boilers fitted 7. 24

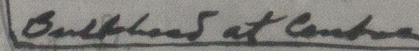

✓ DOUBLE CHANNEL TILLARS

Scale $\frac{1}{8}$ inch = one foot.



Lloyd's Register
Foundation