

and remainder
 1/2 - 2 1/2
 1/2 - 2 1/2

5. 2. 13

18 1/2 - 1 1/2
 1/2 - 1 1/2
 1/2 - 1 1/2

MIDSHIP SECTION.

N^{os} 565 & 6.

STEEL SCREW TRAWLERS


DIMS 133'-4" BP x 23'-0" E x 12'-9" MLD

SCALE 1/2" = ONE FOOT

TO CLASS 100 A.1 AT LLOYDS FOR FISHING PURPOSES.

DECK PLATED OVER IN WAY OF
 MACHINERY SPACE. E & B CASING AS
 PREVIOUSLY APPROVED.

PLAN No. 2487
 FOR ENCLOSURE TO
 Messrs Lloyd's Surveyors
 Hull FROM
 COCHRANE & SONS, LTD.
 SHIPBUILDERS, LONDON
 DATE 1/2/13. RK

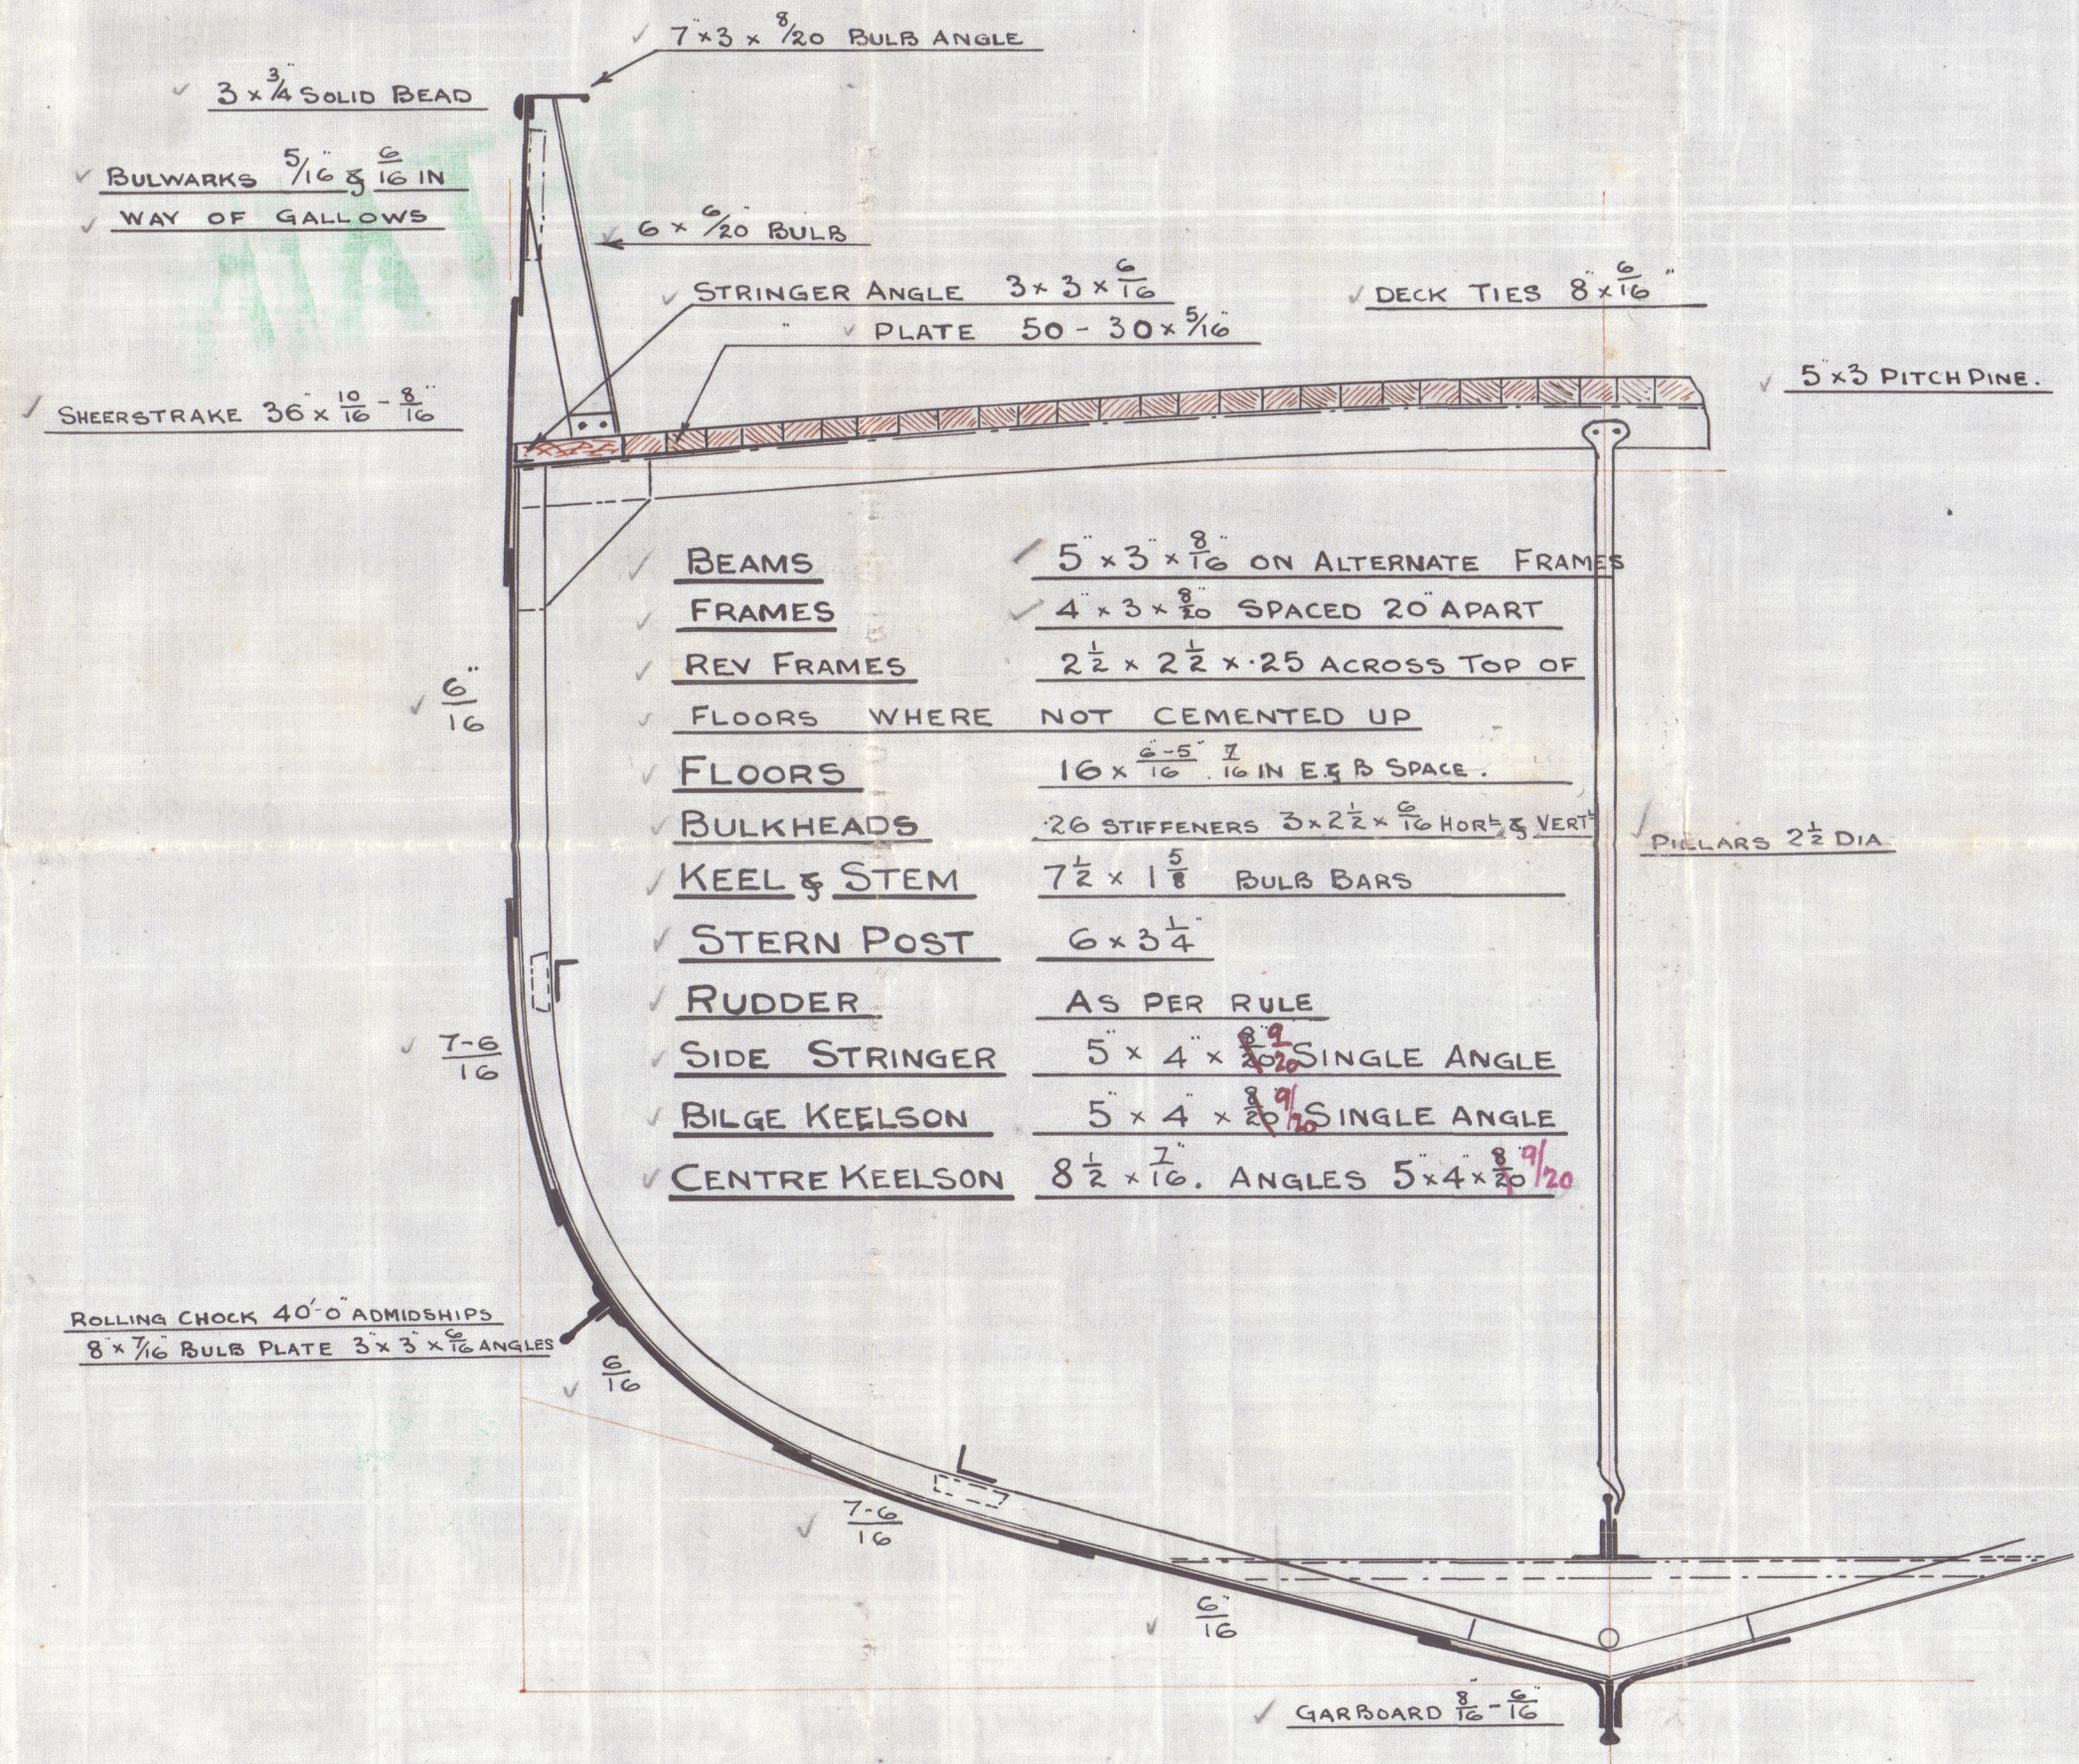

NUMERALS

B + D = 35.63
 L x (B + D) = 4750.55

PRORORTIONS.

L/B = 10.45
 1/B = 5.85

EQUIPMENT

1 ST BOWER ANCHOR	5 3/4 CWTs EX STOCK OR 7 1/4 CWTs STOCKLESS
2 ND " " "	5 1/4 " " " " 6 1/2 " "
KEDGE	3 " " " "
105 FATHOMS	1 1/16 CABLE
60 " "	6 HAWSER OR 2 1/4 STEEL WIRE
60 " "	5 WARP " 2 " " "

Steel wire with
 Owner's consent.

RIVETING

BUTTS OF SHELL PLATING LAPPED & DOUBLE RIVETED
 EXCEPT GARBOARD & SHEERSTRAKE WHICH ARE TO BE
 STRAPPED & DOUBLE RIVETED. LANDINGS DOUBLE RIVETED
 BULWARKS SINGLE RIVETED

asw/
 3-2-13

C.F.
 5/2/13.


Cochran & Sons
No 565-566

Midship Midship.

Skalabeg

Stanley Weyman Hull Rpt No: 26621

St Anthony Hope. - 26666
No. 566.

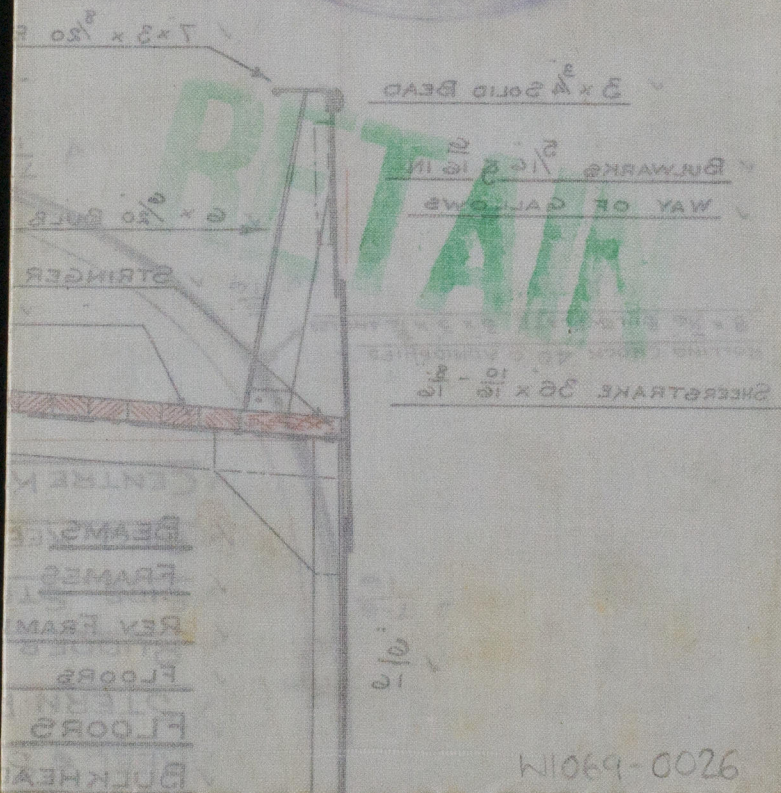

© 2020

Lloyd's Register
Foundation

W1069-0026