
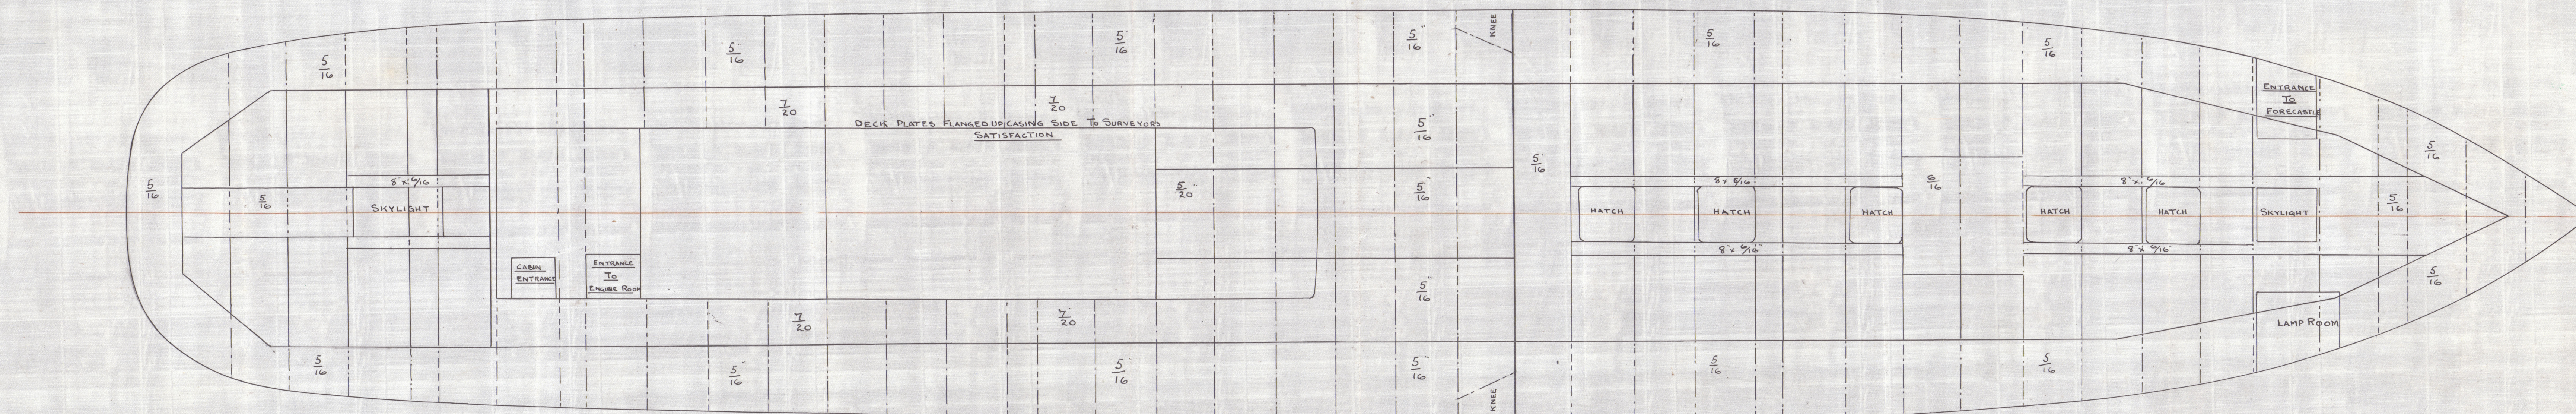


PLAN No. 2468
FOR ENCLOSURE TO
Messrs Lloyd's Surveyors
Hull FROM
LOCHRAINE & SONS, LTD.
SHIPBUILDERS, S. BY.
DATE 1/2/13 RW

N^{os} 565 & 6.

SCALE $\frac{1}{4}$ = ONE FOOT.

(Faint handwritten notes, possibly bleed-through from the reverse side)

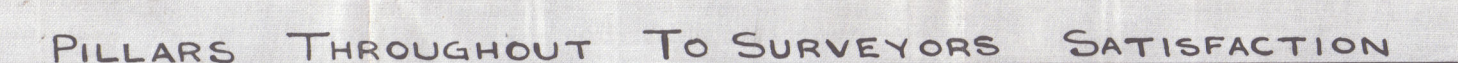

ans
3-2-13

Cochran & Son
Nos 565-566

Profile and Deck.

1/2 Stanley Weyman Hull Rpt No: 26621

3/8 Anthony Hope (No: 636) - 4 - 26666

Skalaberg



© 2020

Lloyd's Register
Foundation

W1069-0027