


m. 0,042

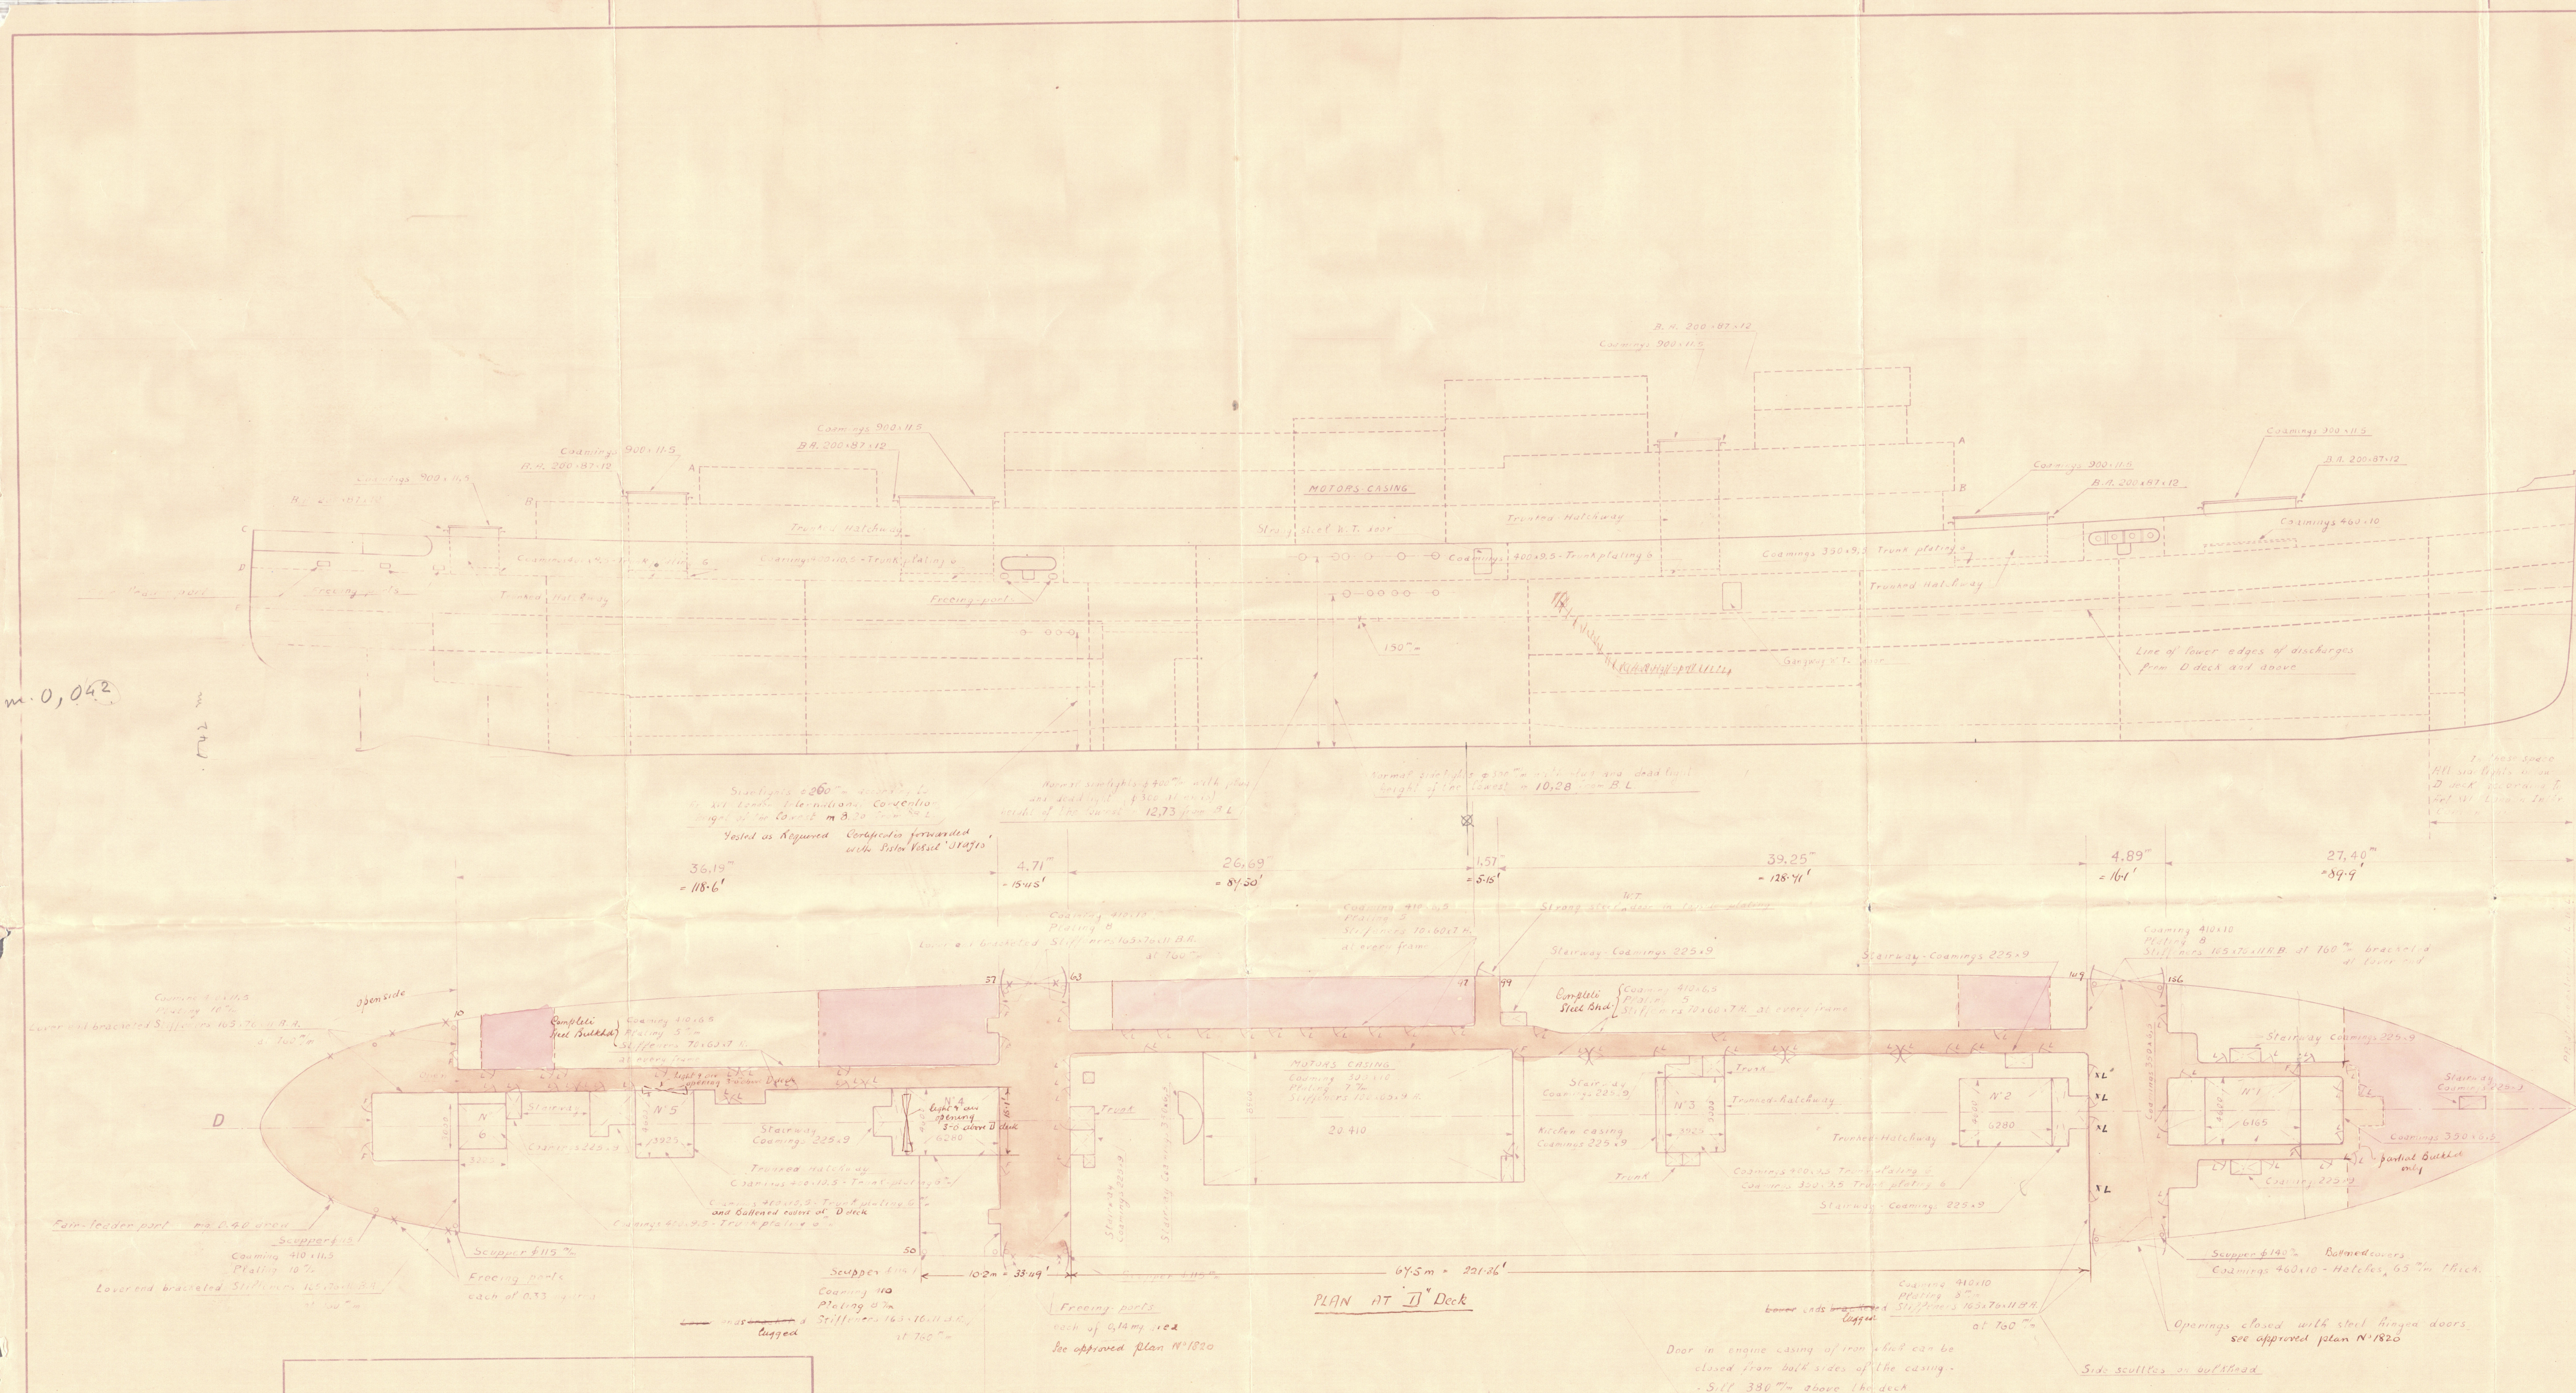

- F) STEEL PLATE HINGED DOOR - FRAMED WITH ANGLE BARR - CONTROLLED ON BOTH SIDES WITHOUT WATERTIGHT PACKING AND HAVING SILL 225" ABOVE THE DECK
- L) HARD WOOD (TEAK) HINGED DOOR - SILL 225" AND ABOVE
- *) ALL SCUPPERS OF D DECK WILL LEAD THROUGH OUTSIDE PLATING BY MEANS OF A NON RETURN VALVE
- +) SCUPPERS FROM DECKS BELOW D DECK LED TO THE BILGES

Parts of Deck lined brown sheathed 2 1/4" wood
" " " red " 2 1/4"
Remainder not sheathed.

Twin Sc. M.S. "VIRGILIO"
COSTRUZIONI N° 15
Elements of Freeboard.
ELEMENTI PER IL BORDO LIBERO
to accompany Freeboard Report

M.S. "VIRGILIO"
GEN. 10314.

Elements of Freckard

RETAIN

RETAIN



© 2020

Lloyd's Register
Foundation

L1069-0149